



TYPICAL SECTIONS & DESIGN DATA

ITEM 406.25 BITUMINOUS CONCRETE PAVEMENT
 LEVELING COURSE, TYPE III OR IV (205 TONS/MILE)
 AS DIRECTED BY THE ENGINEER
 3/4" WEARING COURSE (+1/2") TYPE IV

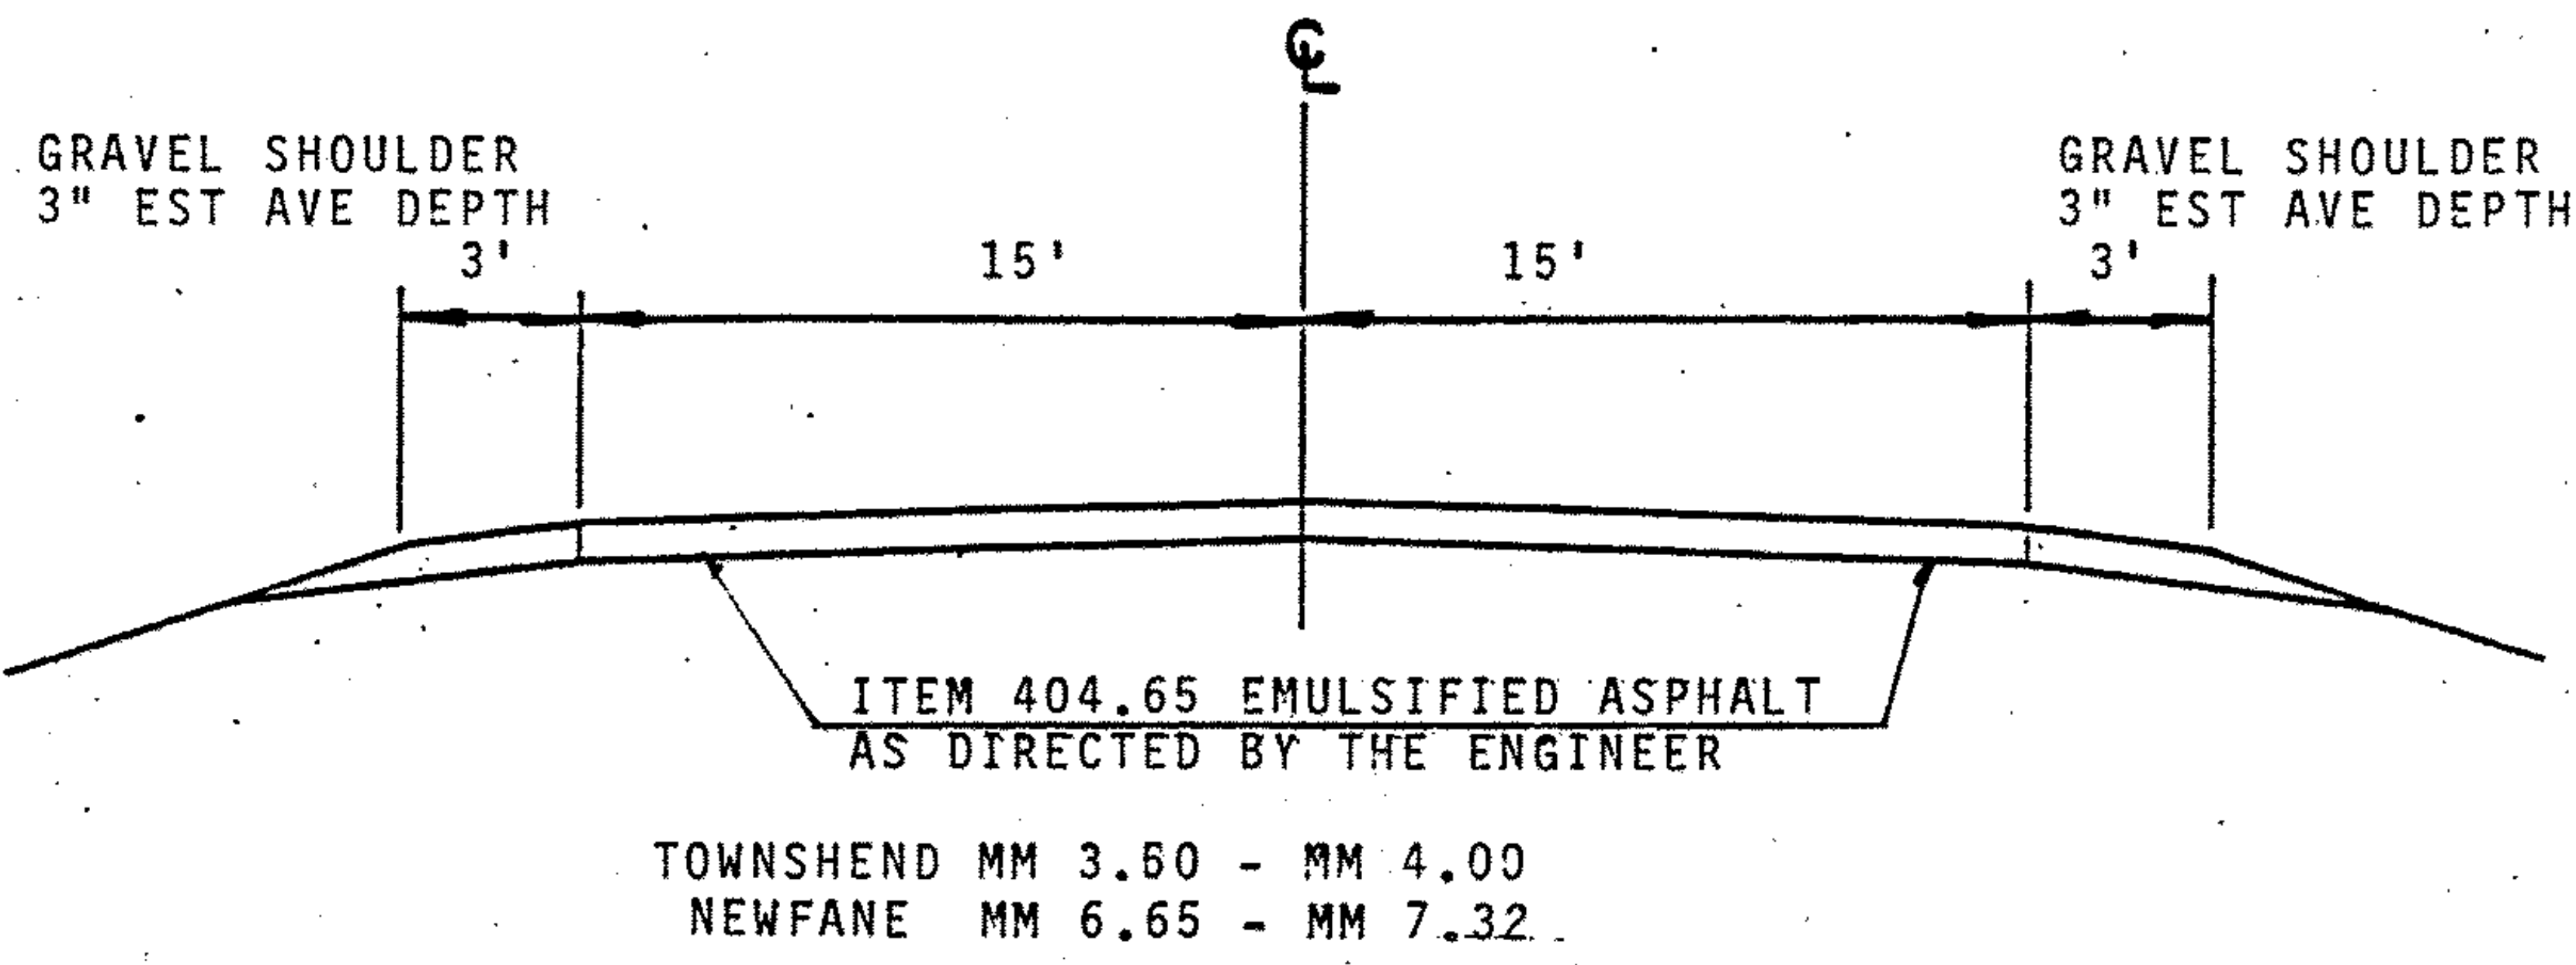

ITEM 406.25 BITUMINOUS CONCRETE PAVEMENT
 LEVELING COURSE, TYPE III OR IV (191 TONS/MILE)
 AS DIRECTED BY THE ENGINEER
 3/3" WEARING COURSE (+1/2") TYPE IV

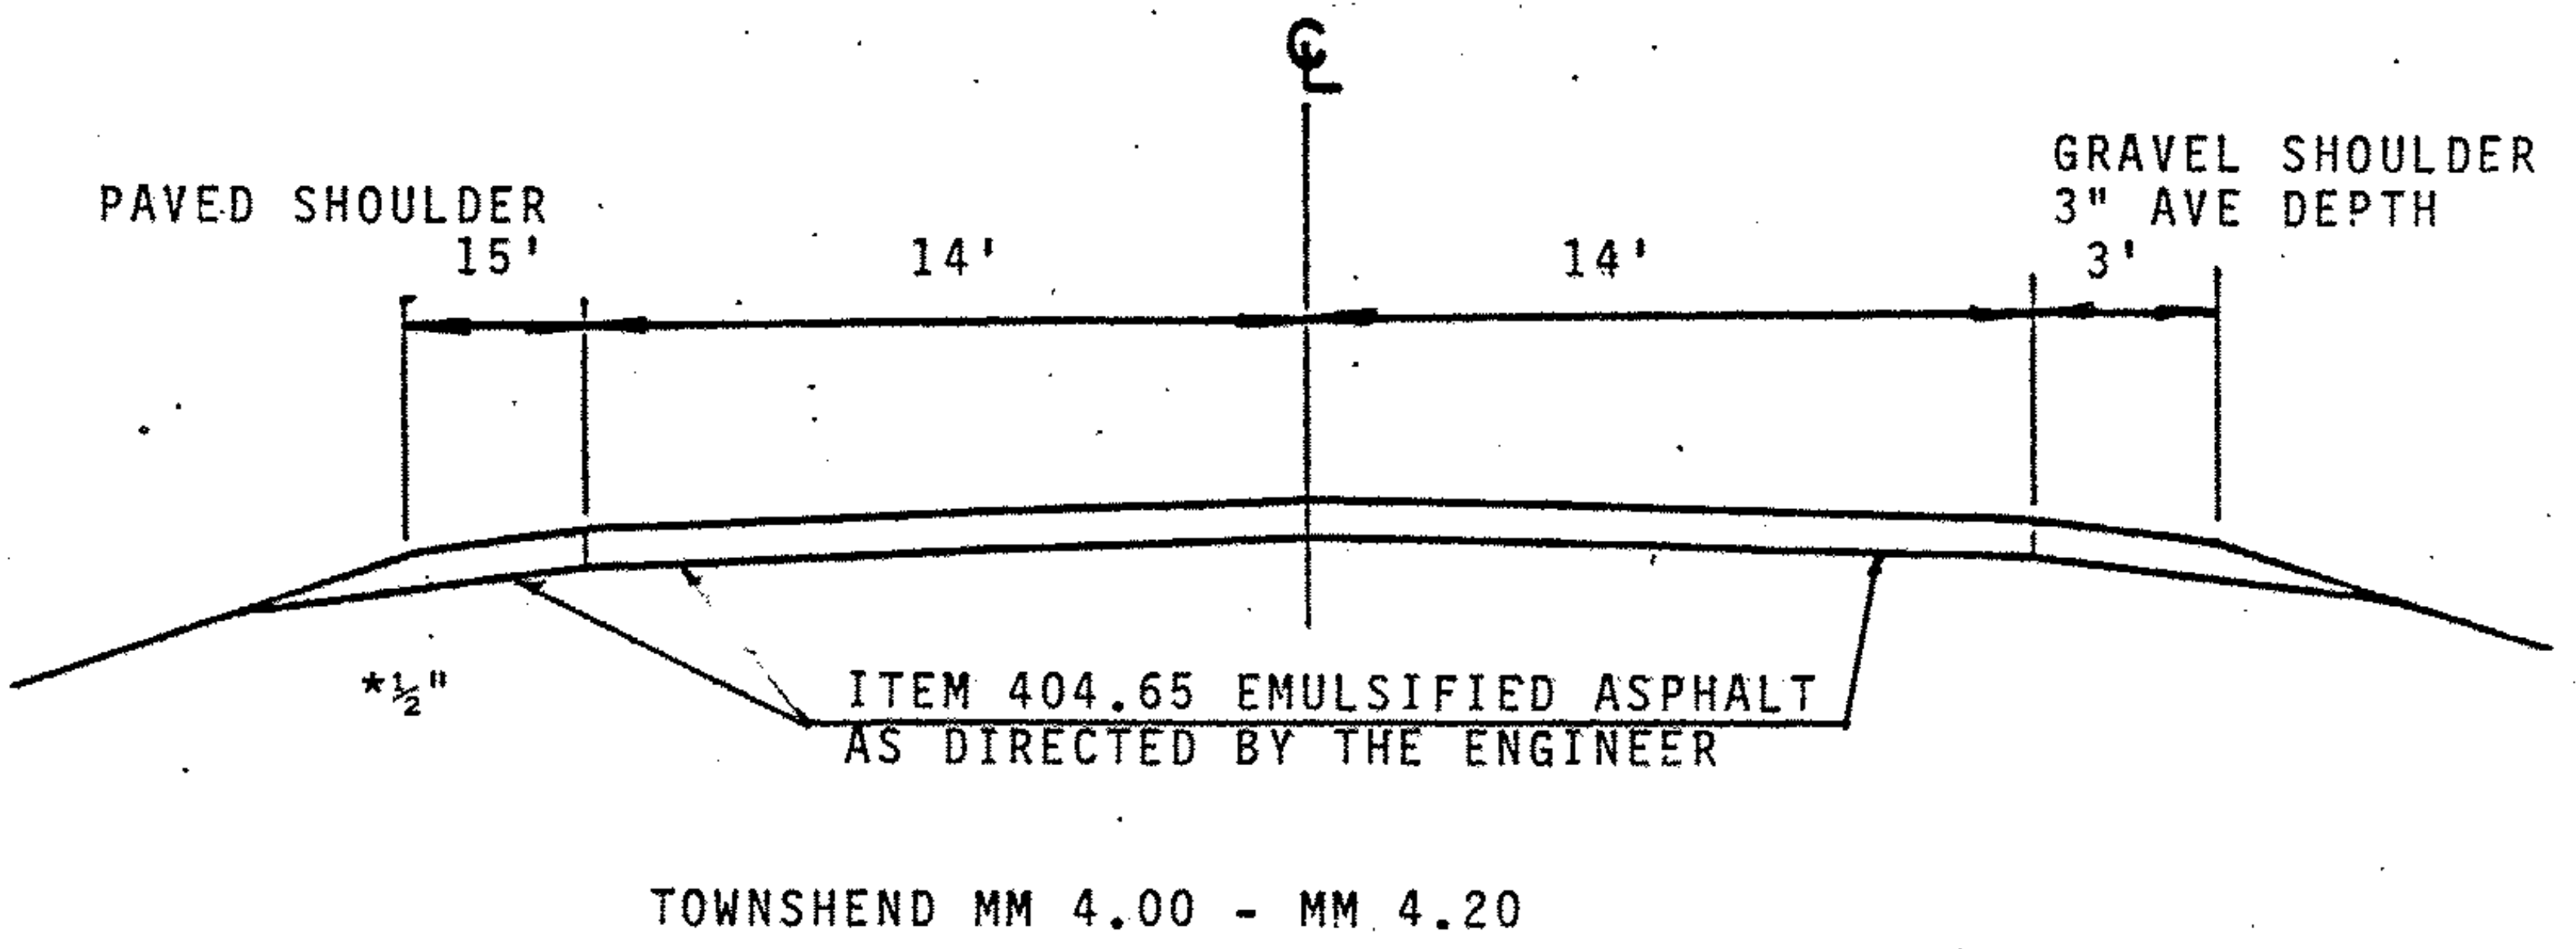

* PAVED SHOULDER WILL BE TAPERED FROM FULL DEPTH TO 1/2"

PROJECT NEWFANE-TOWNSHEND

NO. HMA 2505

SHEET 3A OF 11 SHEETS