


PROJECT DESCRIPTION AND LOCATION

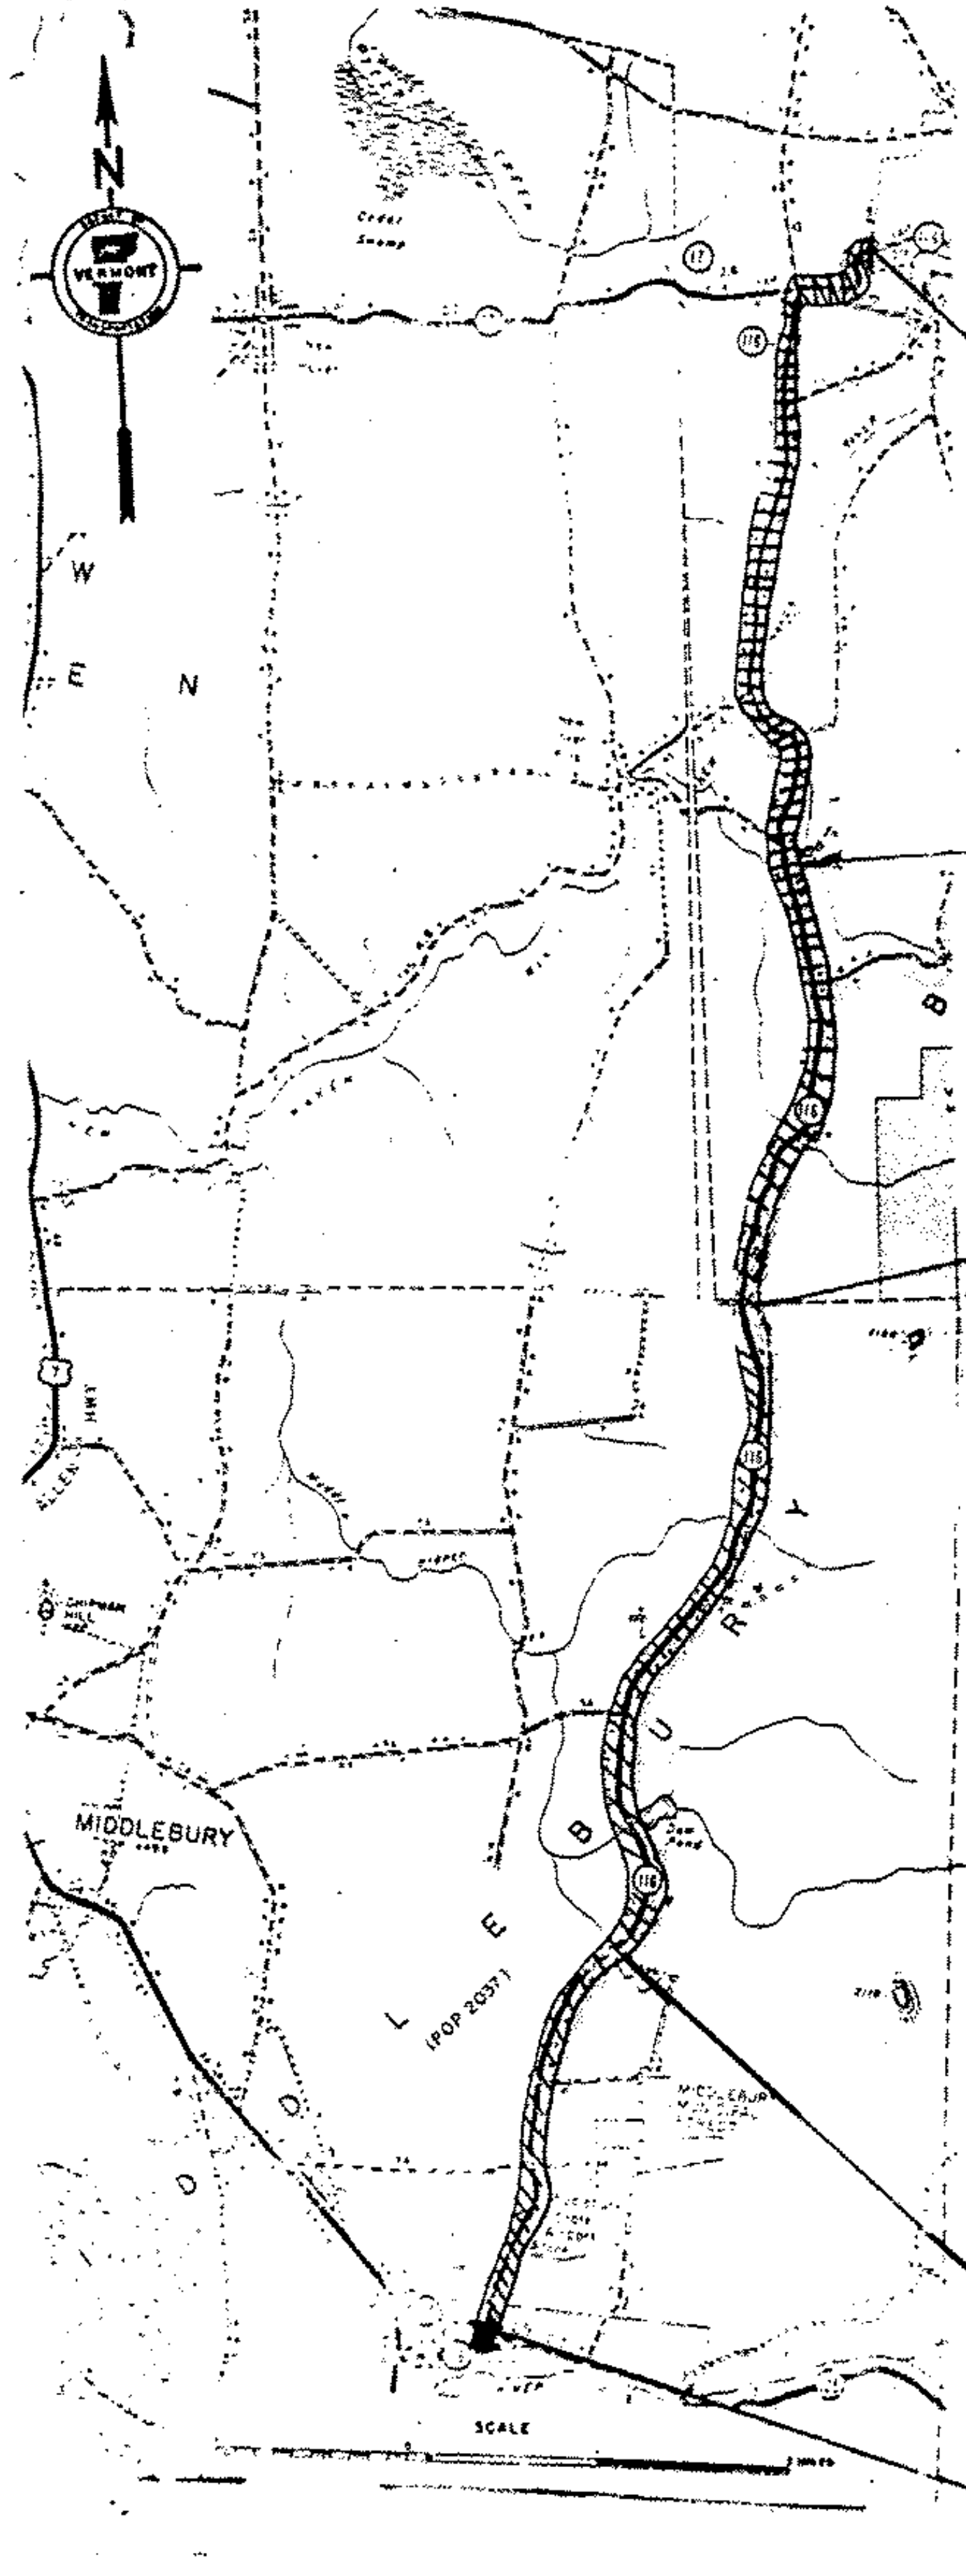

On VT 116 - Beginning at the junction of US-7 and VT 116 at Middlebury MM 0.000 and extending 12.412 miles northerly to Bristol MM 6.025.

END PROJECT
MM 6.025

BRIDGE 8
MM 3.16-DO NOT PAVE

BRISTOL MM 0.000
MIDDLEBURY MM 6.587

Length of Project
12.412 Miles
65535 Feet

BR 2 MM 2.700-MM 2.900
Do Not Pave (1,056')
Bridge and approach under separate contract.
BEGIN PROJECT
MM 0.000

PROJECT Middlebury-Bristol

NO. HMA 2518 HMA 2465

SHEET 2 OF 11 SHEETS