



TYPICAL SECTIONS & DESIGN DATA

ITEM 406.25 BITUMINOUS CONCRETE PAVEMENT
 Leveling course Type III or IV (250 tons/mile)
 AS DIRECTED BY THE ENGINEER
 3/4" Wearing course (+1/4") Type IV

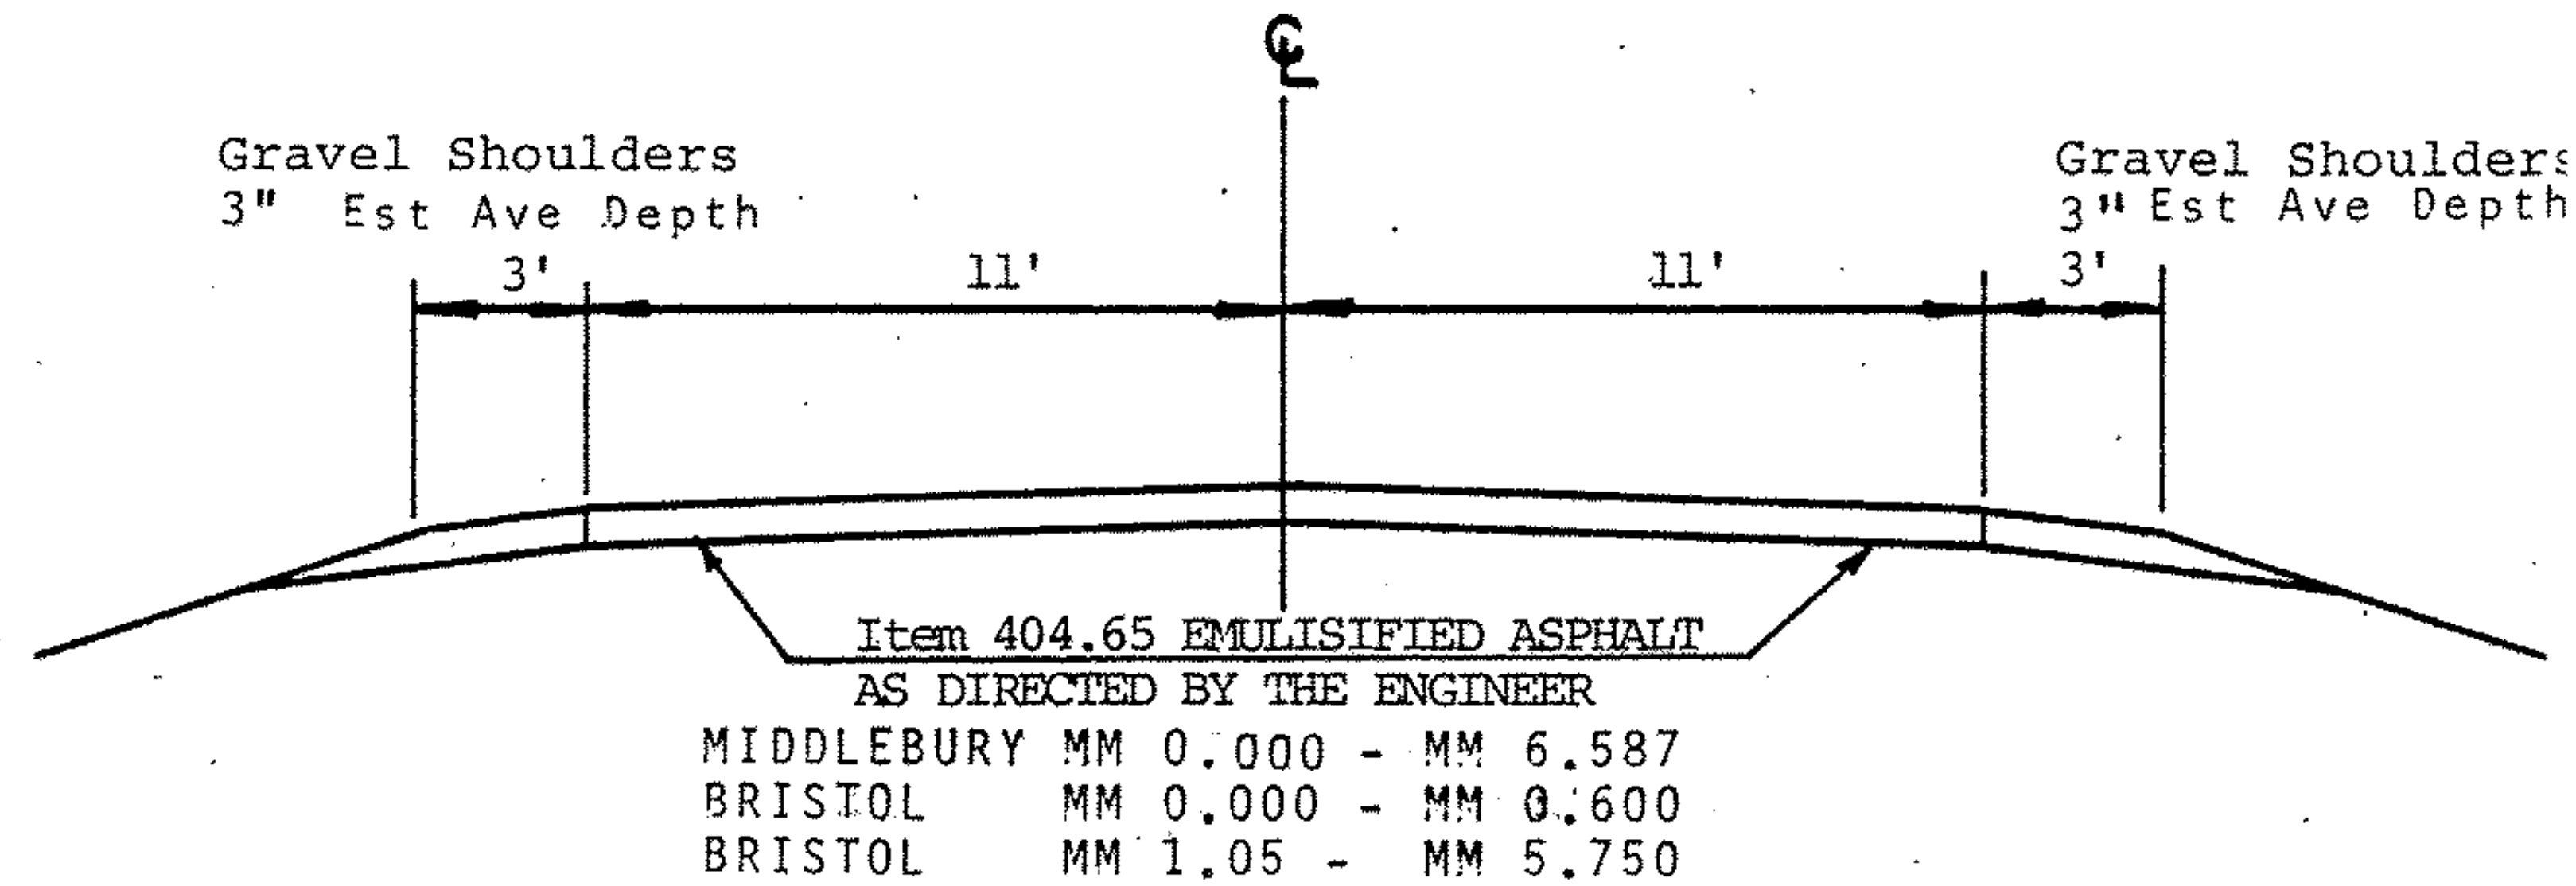

ITEM 406.25 BITUMINOUS CONCRETE PAVEMENT
 Leveling course, Type III or IV (273 Tons/Mile)
 AS DIRECTED BY THE ENGINEER
 3/4" Wearing course (+1/4") Type IV

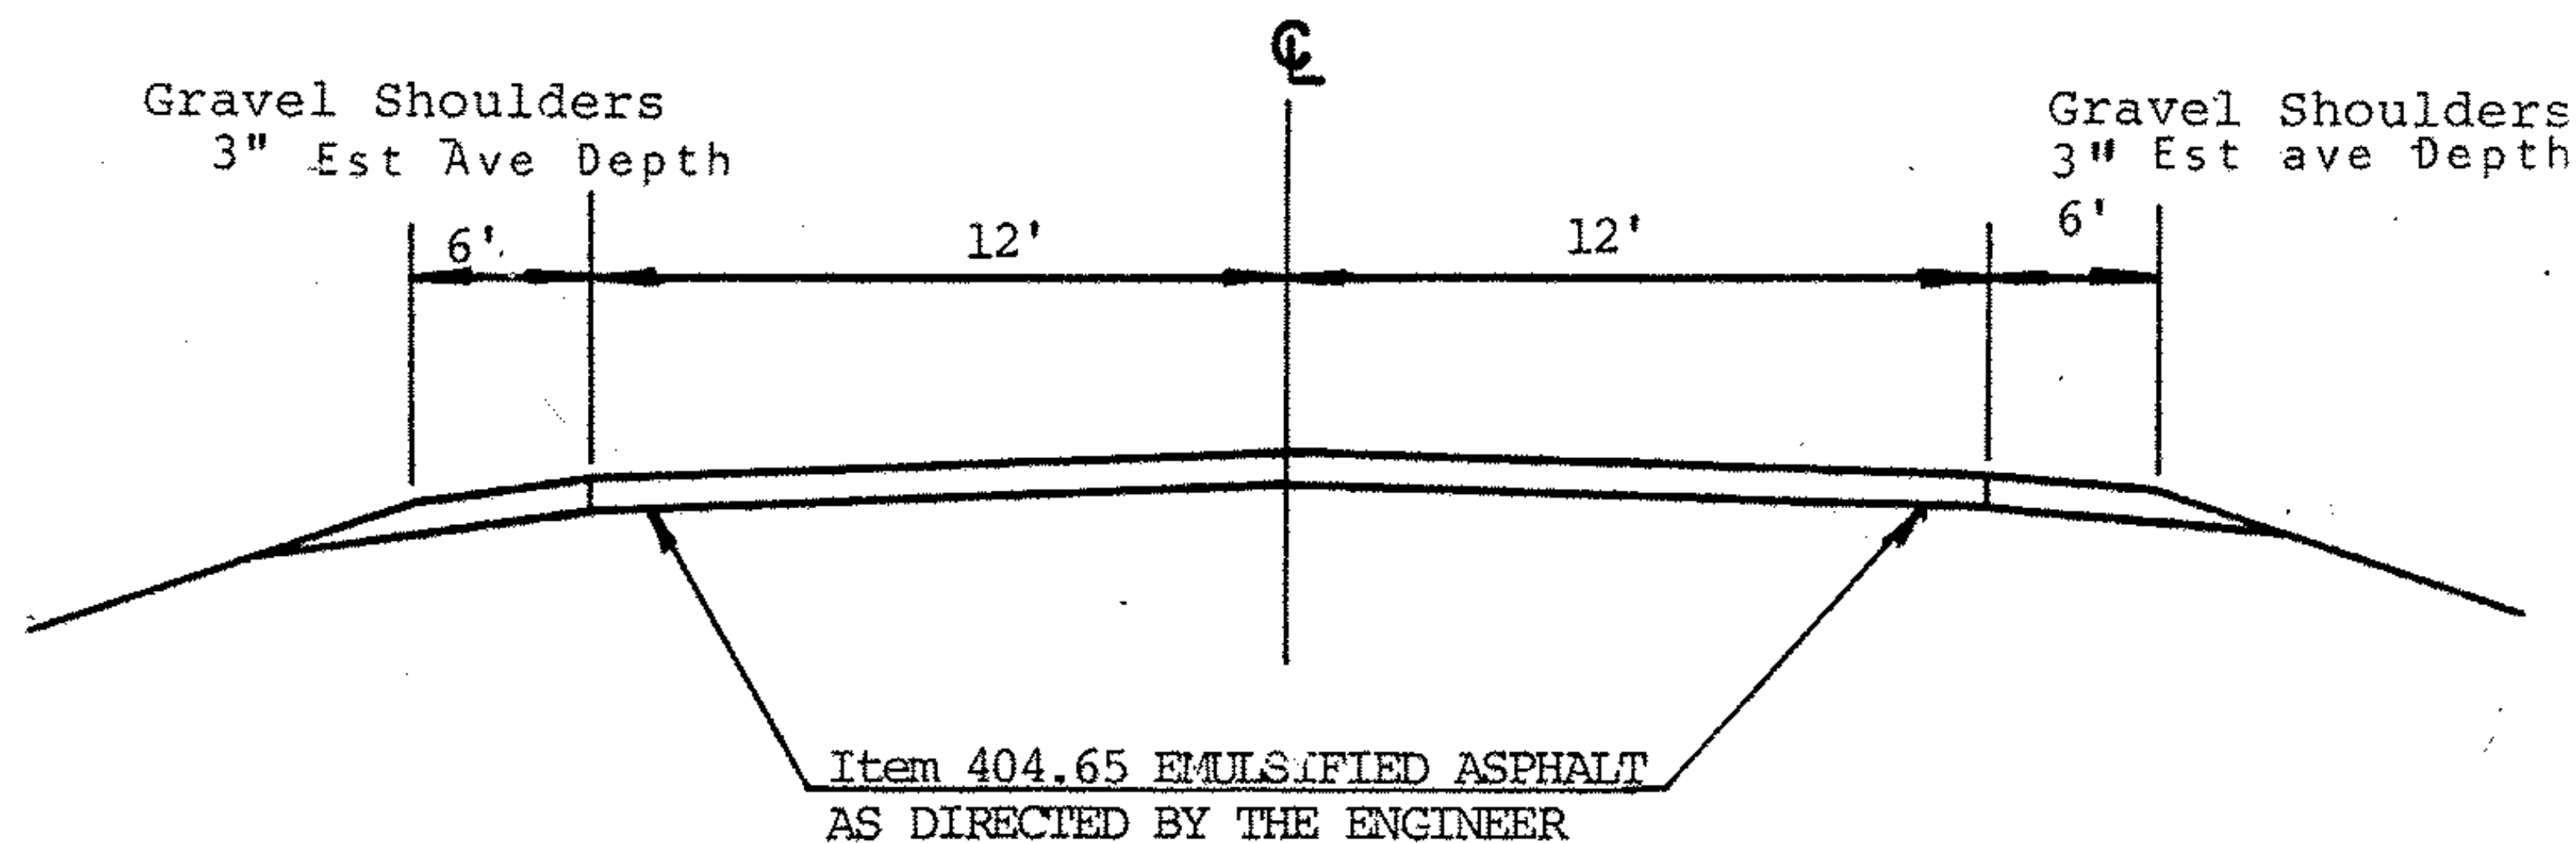

BRISTOL MM 0.60- MM 1.05

TRAFFIC DATA
 1982 ADT = 2000
 V = 50 MPH

PROJECT MIDDLEBURY-BRISTOL

NO. HMA 2518 HMA 2465
 SHEET 3 OF 11