


TYPICAL SECTIONS & DESIGN DATA

ITEM 406.25 BITUMINOUS CONCRETE PAVEMENT
Leveling course type III or IV (409 tons/mile)
AS DIRECTED BY THE ENGINEER
3/4" Wearing course (+1/4") Type IV

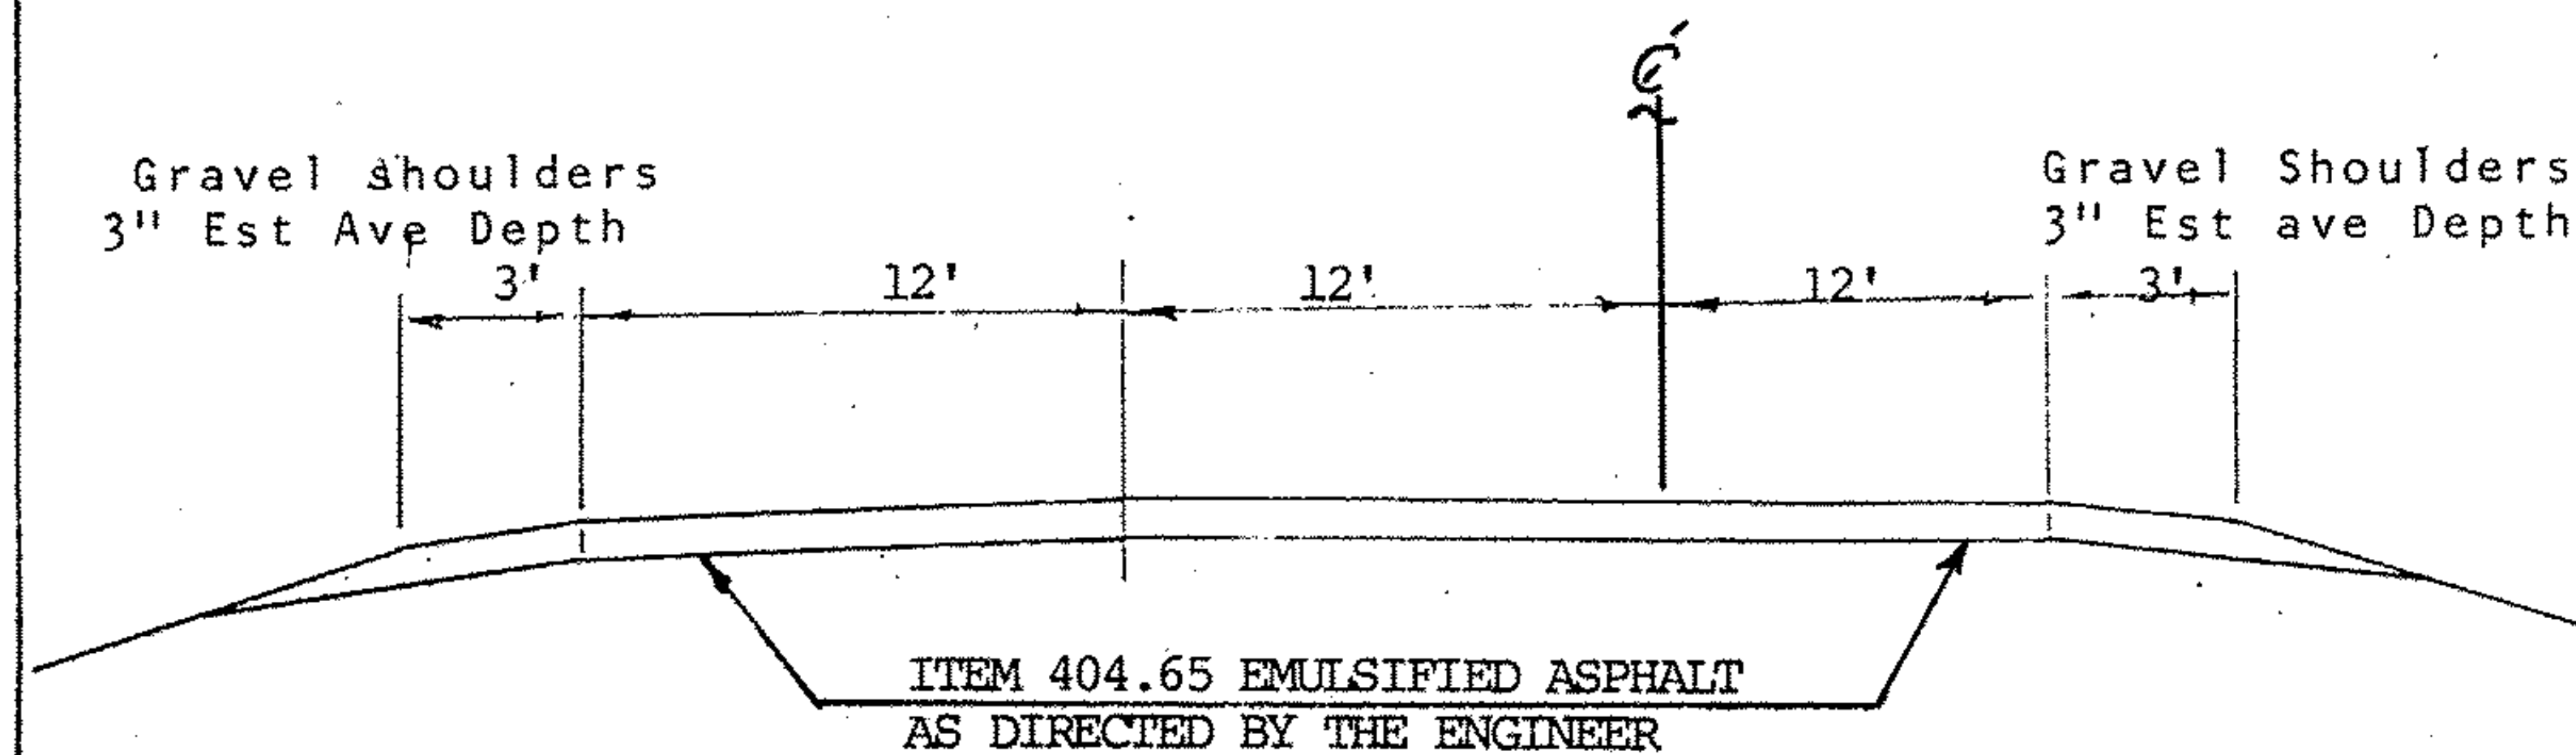

BRISTOL MM 5.75 - MM6.029

NOTE: BRIDGE 8, MM 3.16, ALTHOUGH LISTED ON PLANS AS "DO NOT PAVE"
IF, IN THE OPINION OF THE ENGINEER, IS EXTREMELY POOR MAY BE
PAVED WITH A DRAG COURSE NOT TO EXCEED 1/2".

PROJECT MIDDLEBURY-BRISTOL

NO. HMA 2518 HMA 2465

SHEET 3A OF 11 SHEETS