


PROJECT DESCRIPTION AND LOCATION

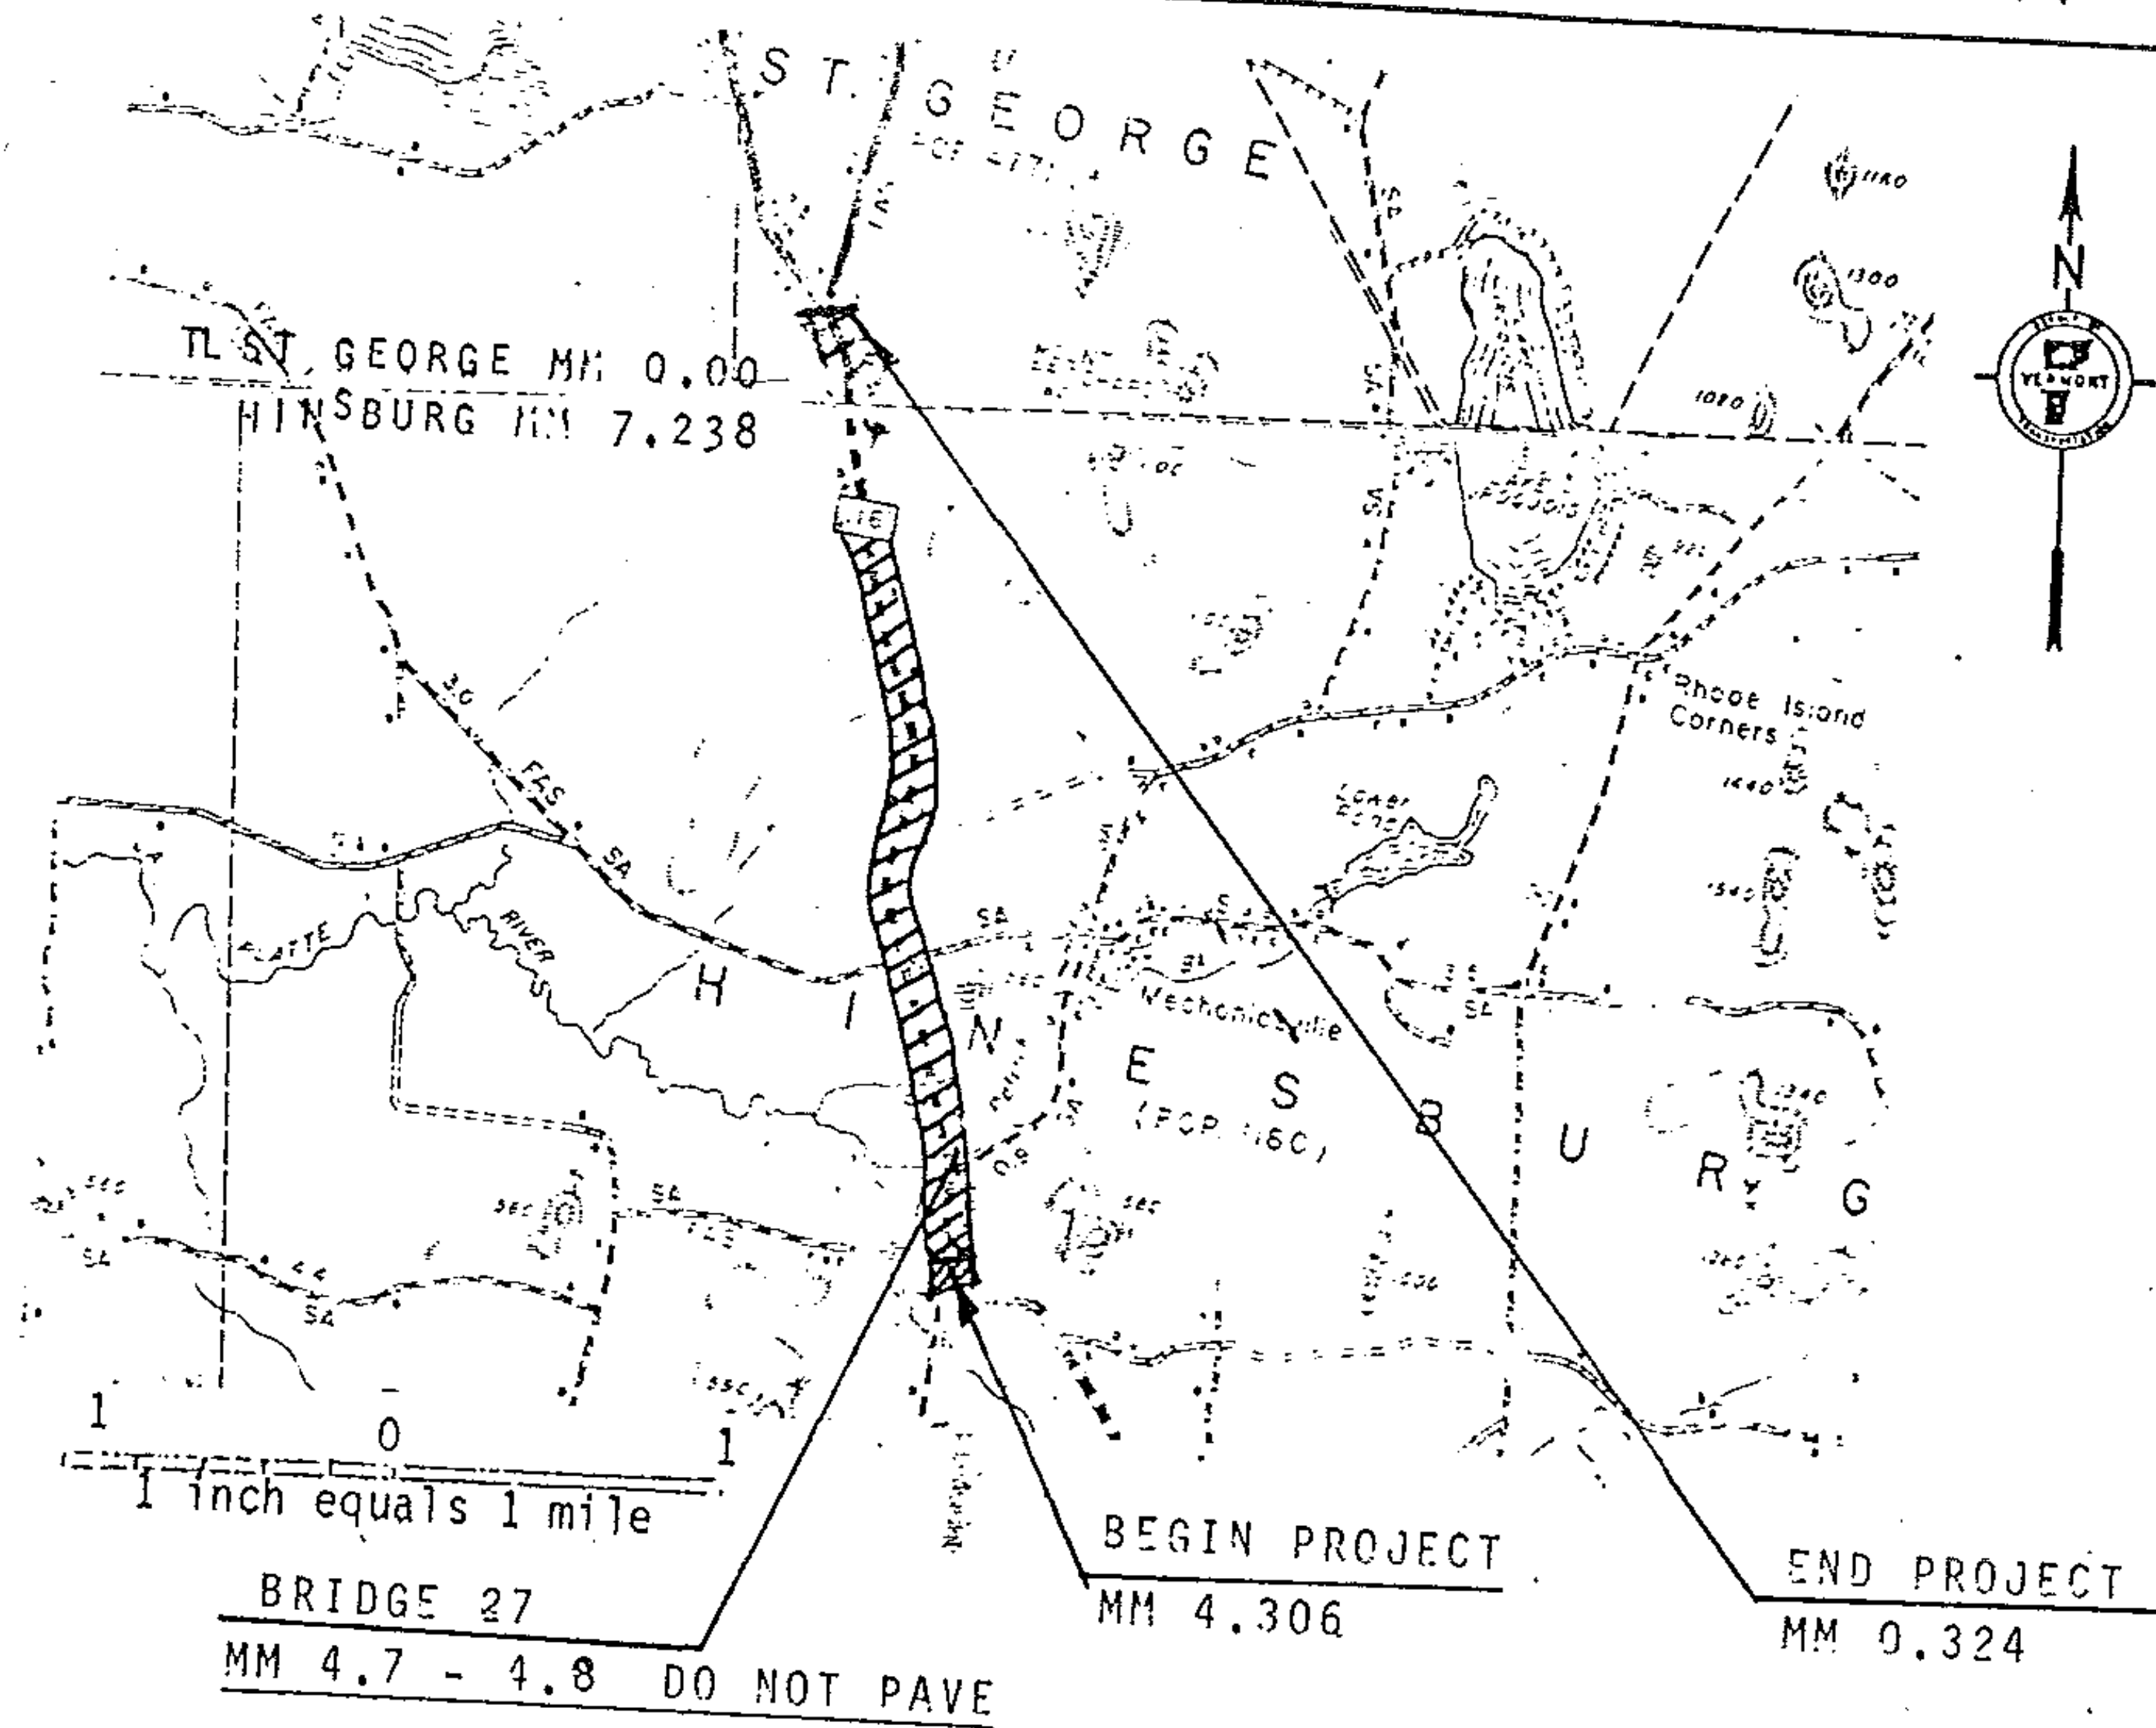

ON VT 116: BEGINNING 2.932 MILES SOUTHERLY OF THE HINESBURG-ST GEORGE TOWN LINE AT HINESBURG MM 4.306 AND EXTENDING 3.156 MILES NORHTERLY TO ST GEORGE MM 0.324 AT THE JUNCTION OF VT 116 AND VT 2A.

LENGTH OF PROJECT
3.156 Miles
16,663 Feet

NOTE: Bridge 27-Bridge project to be let do not pave between MM 4.7 & 4.8

PROJECT HINESBURG-ST GEORGE

NO. HMA 2519

SHEET 2 OF 11 SHEETS