


TYPICAL SECTIONS & DESIGN DATA

ITEM 406.25 BITUMINOUS CONCRETE PAVEMENT
 Leveling course, Type III or IV (250 Tons/Mile)
 AS DIRECTED BY THE ENGINEER
 1½" Wearing course (+¼") Type III



ITEM 406.25 BITUMINOUS CONCRETE PAVEMENT
 Leveling course, Type III or IV (250 Tons/Mile)
 AS DIRECTED BY THE ENGINEER
 1½" Wearing course (+¼") Type III

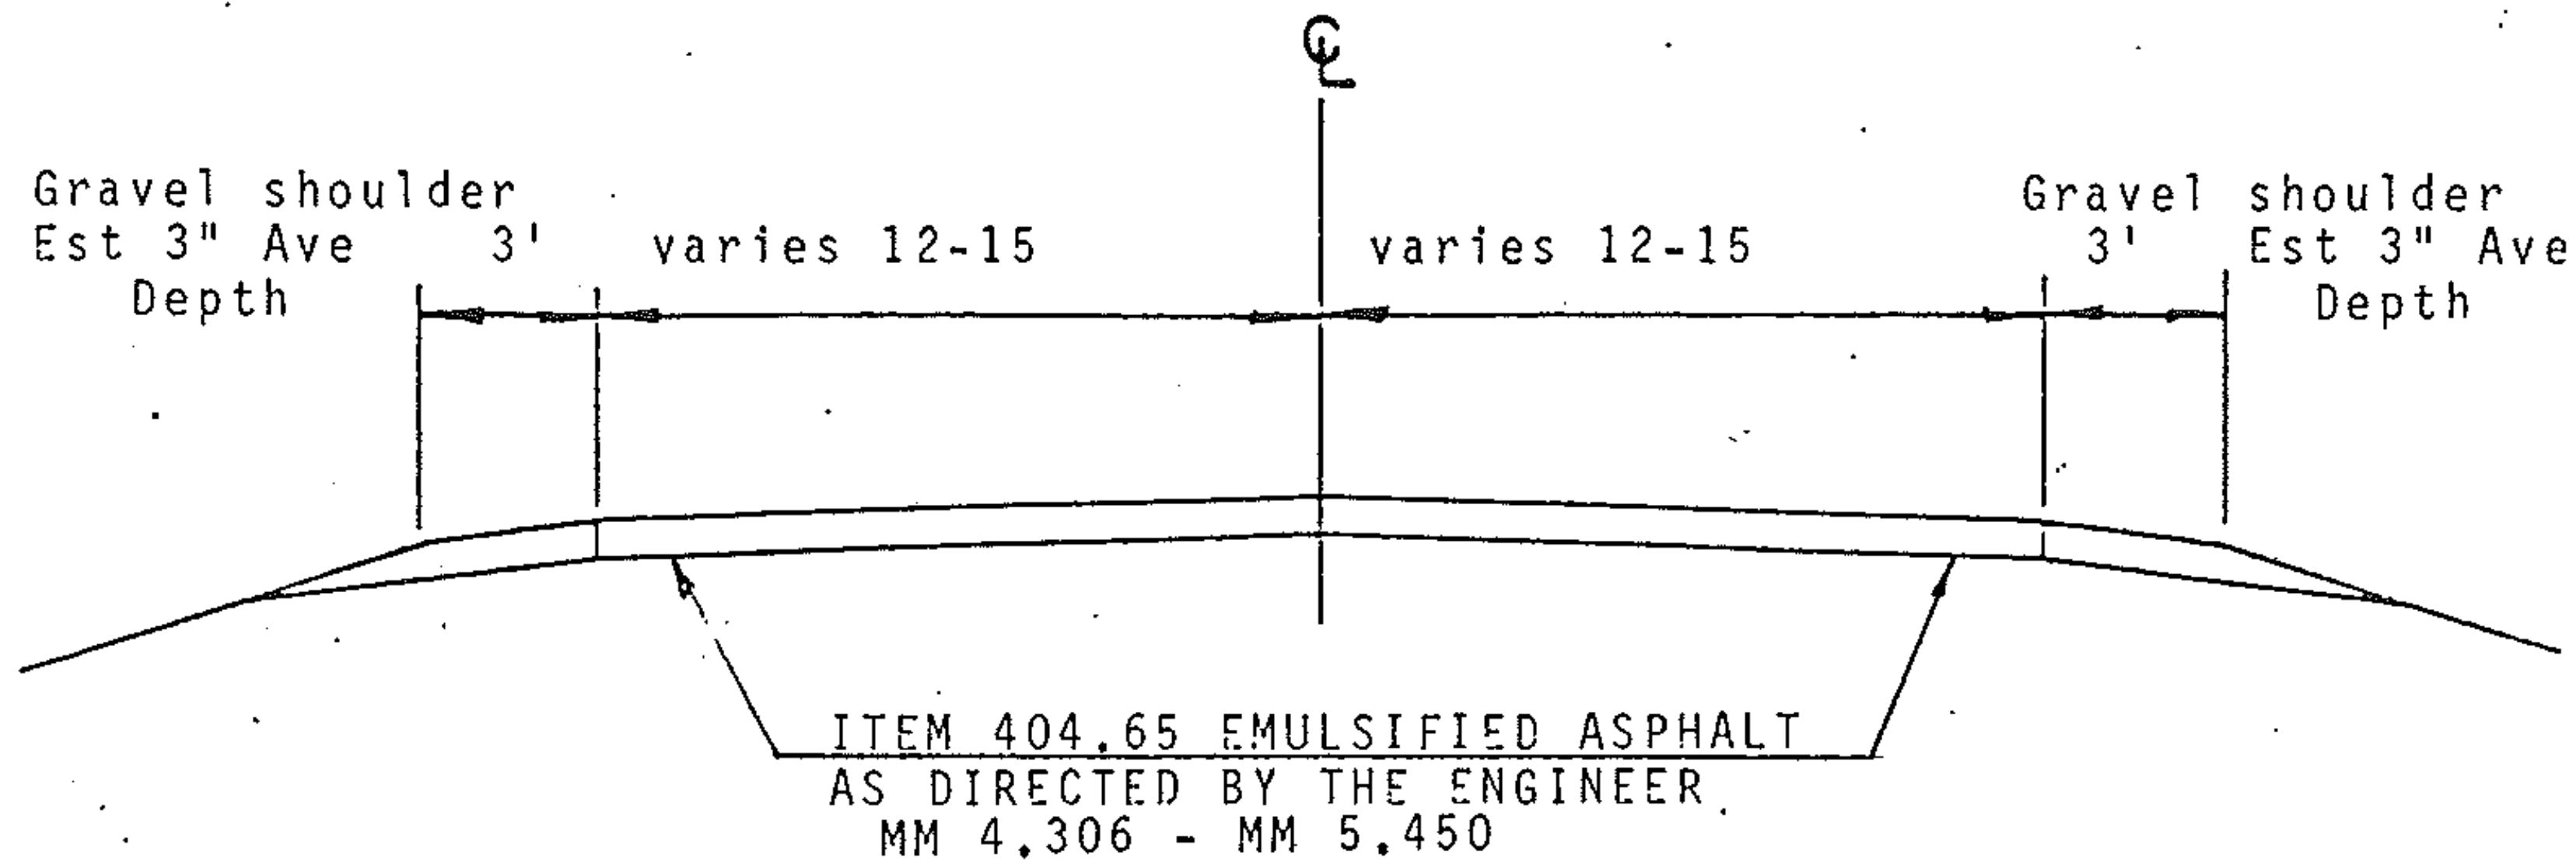