


PROJECT DESCRIPTION AND LOCATION

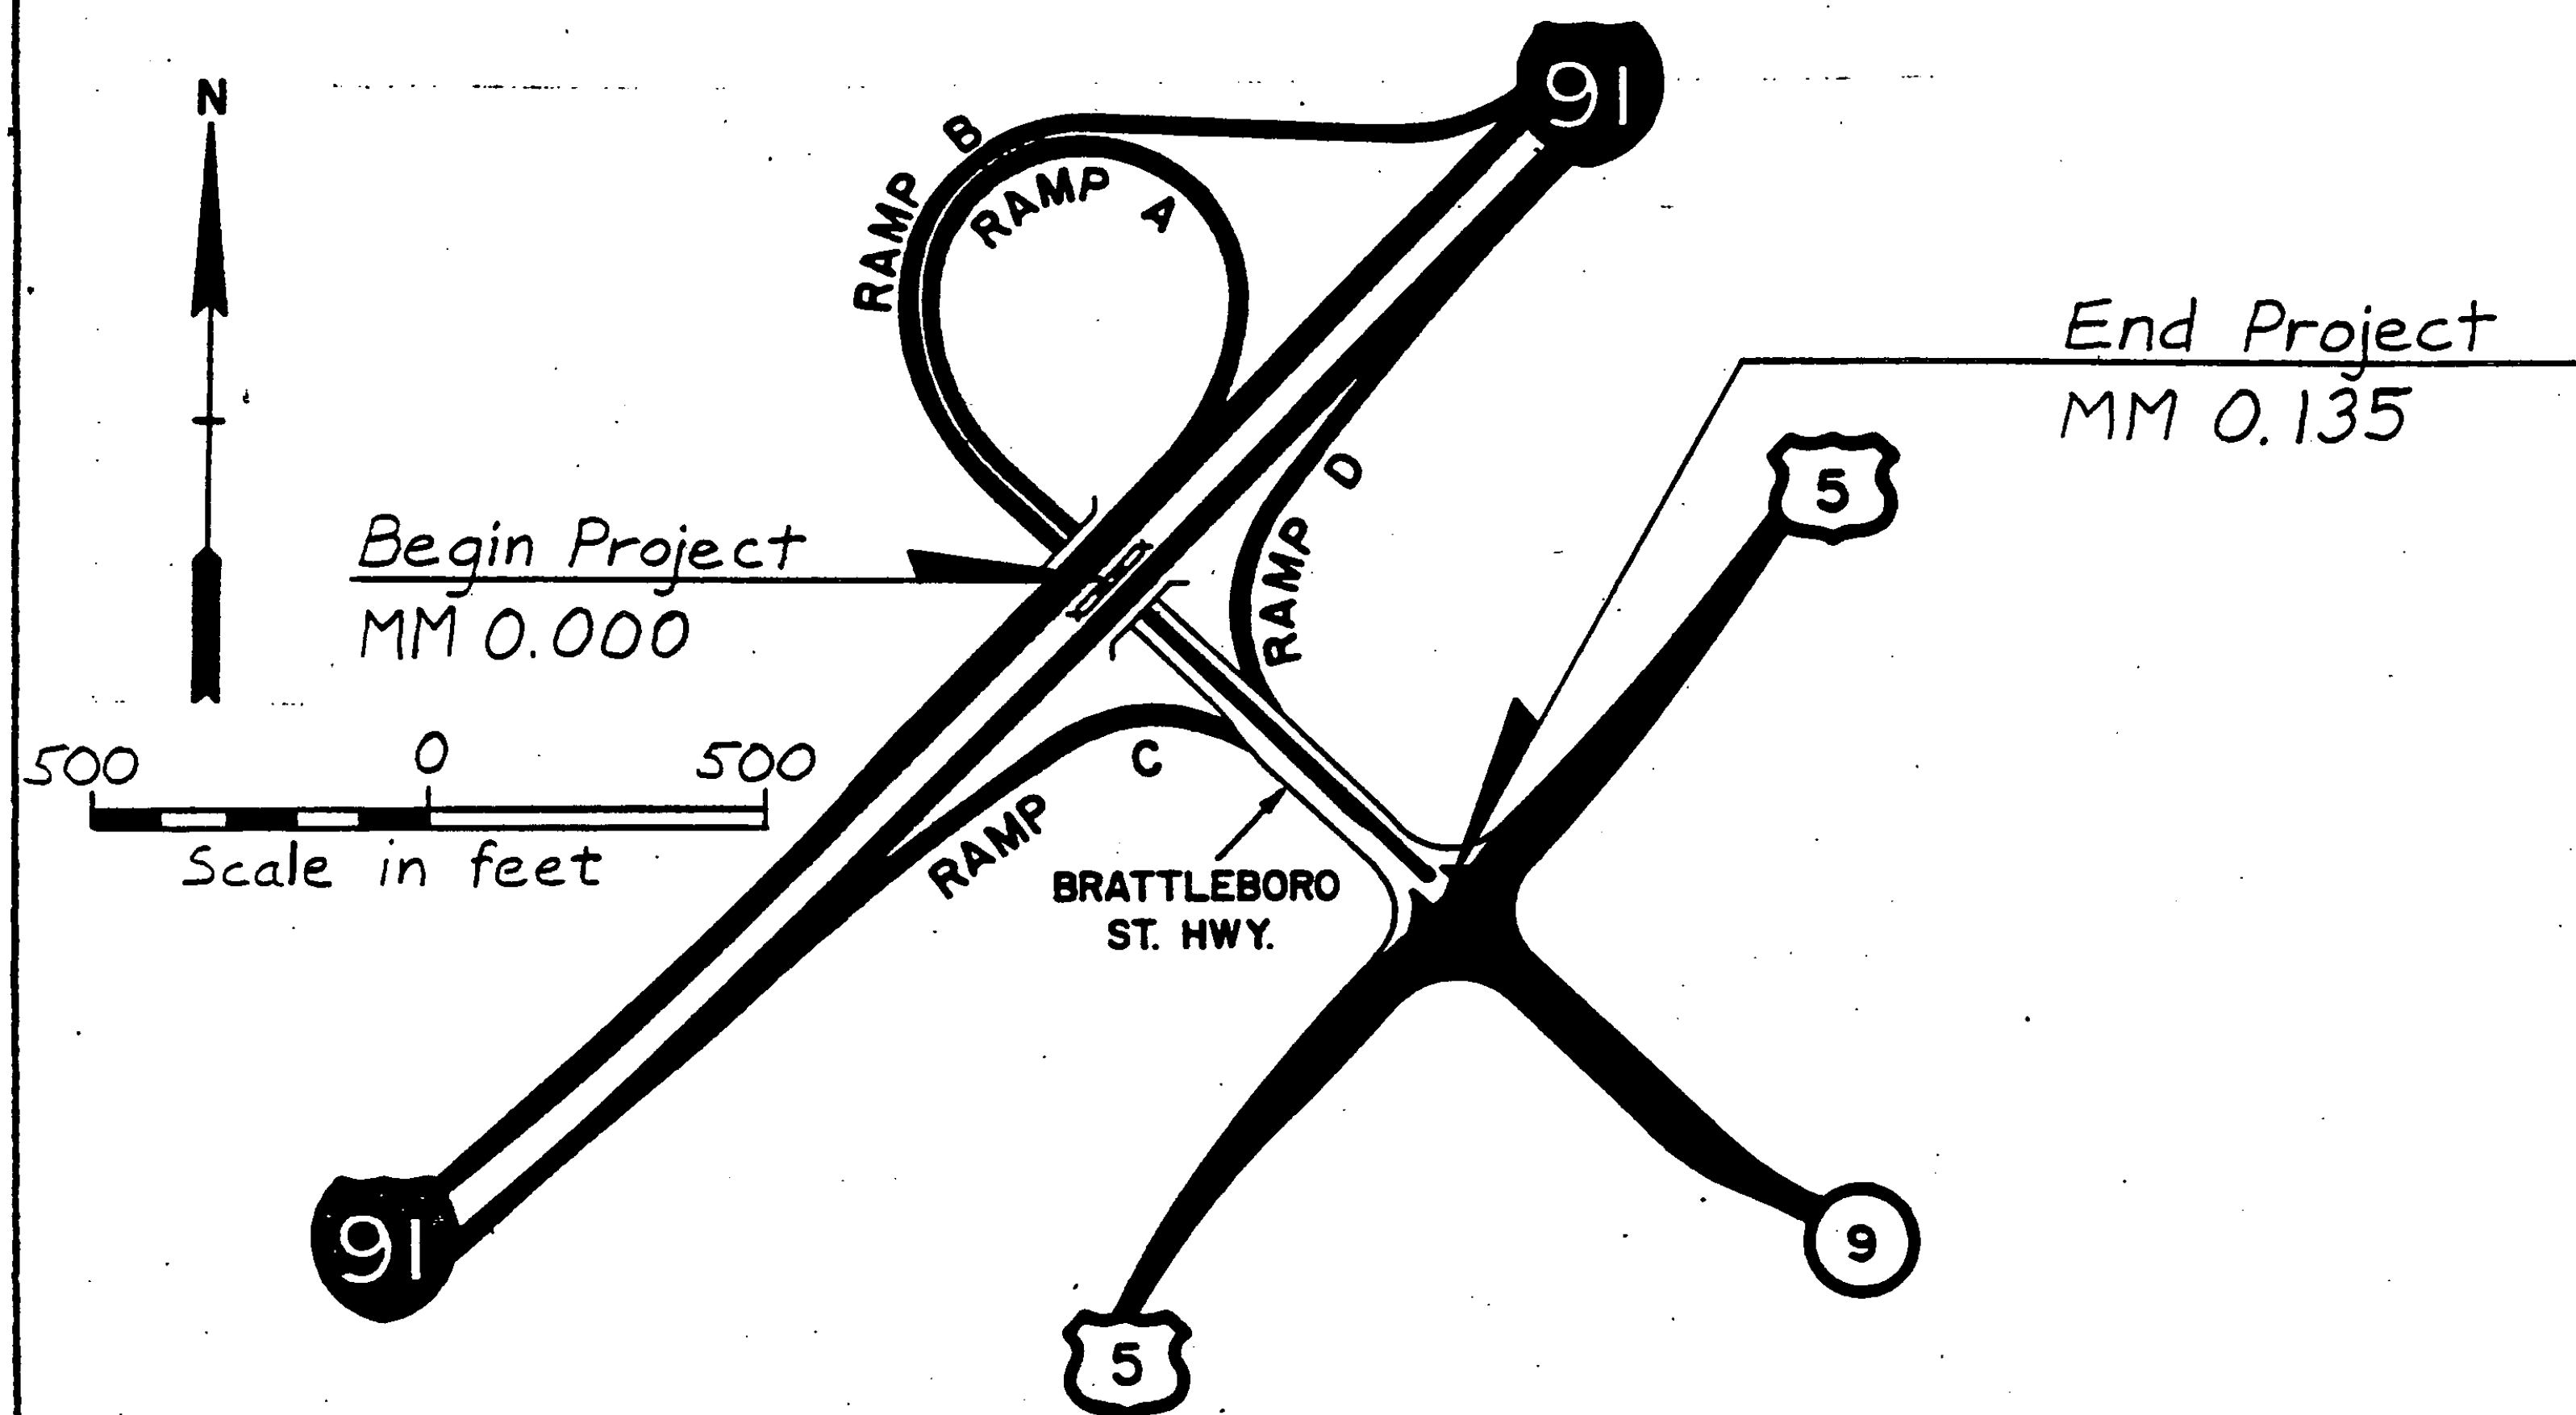

Beginning on Brattleboro State Highway at the intersection of I 91 at MM 0.000 and extending easterly 0.135 miles to the intersection of US Route 5 at MM 0.135.

Traffic Data

1982 AADT = 6630

V = 50 MPH

Length of Project

713 ft.

0.135 mi.

PROJECT Brattleboro

NO. HMA 2507

SHEET 5 OF 20 SHEETS