


# PROJECT DESCRIPTION AND LOCATION

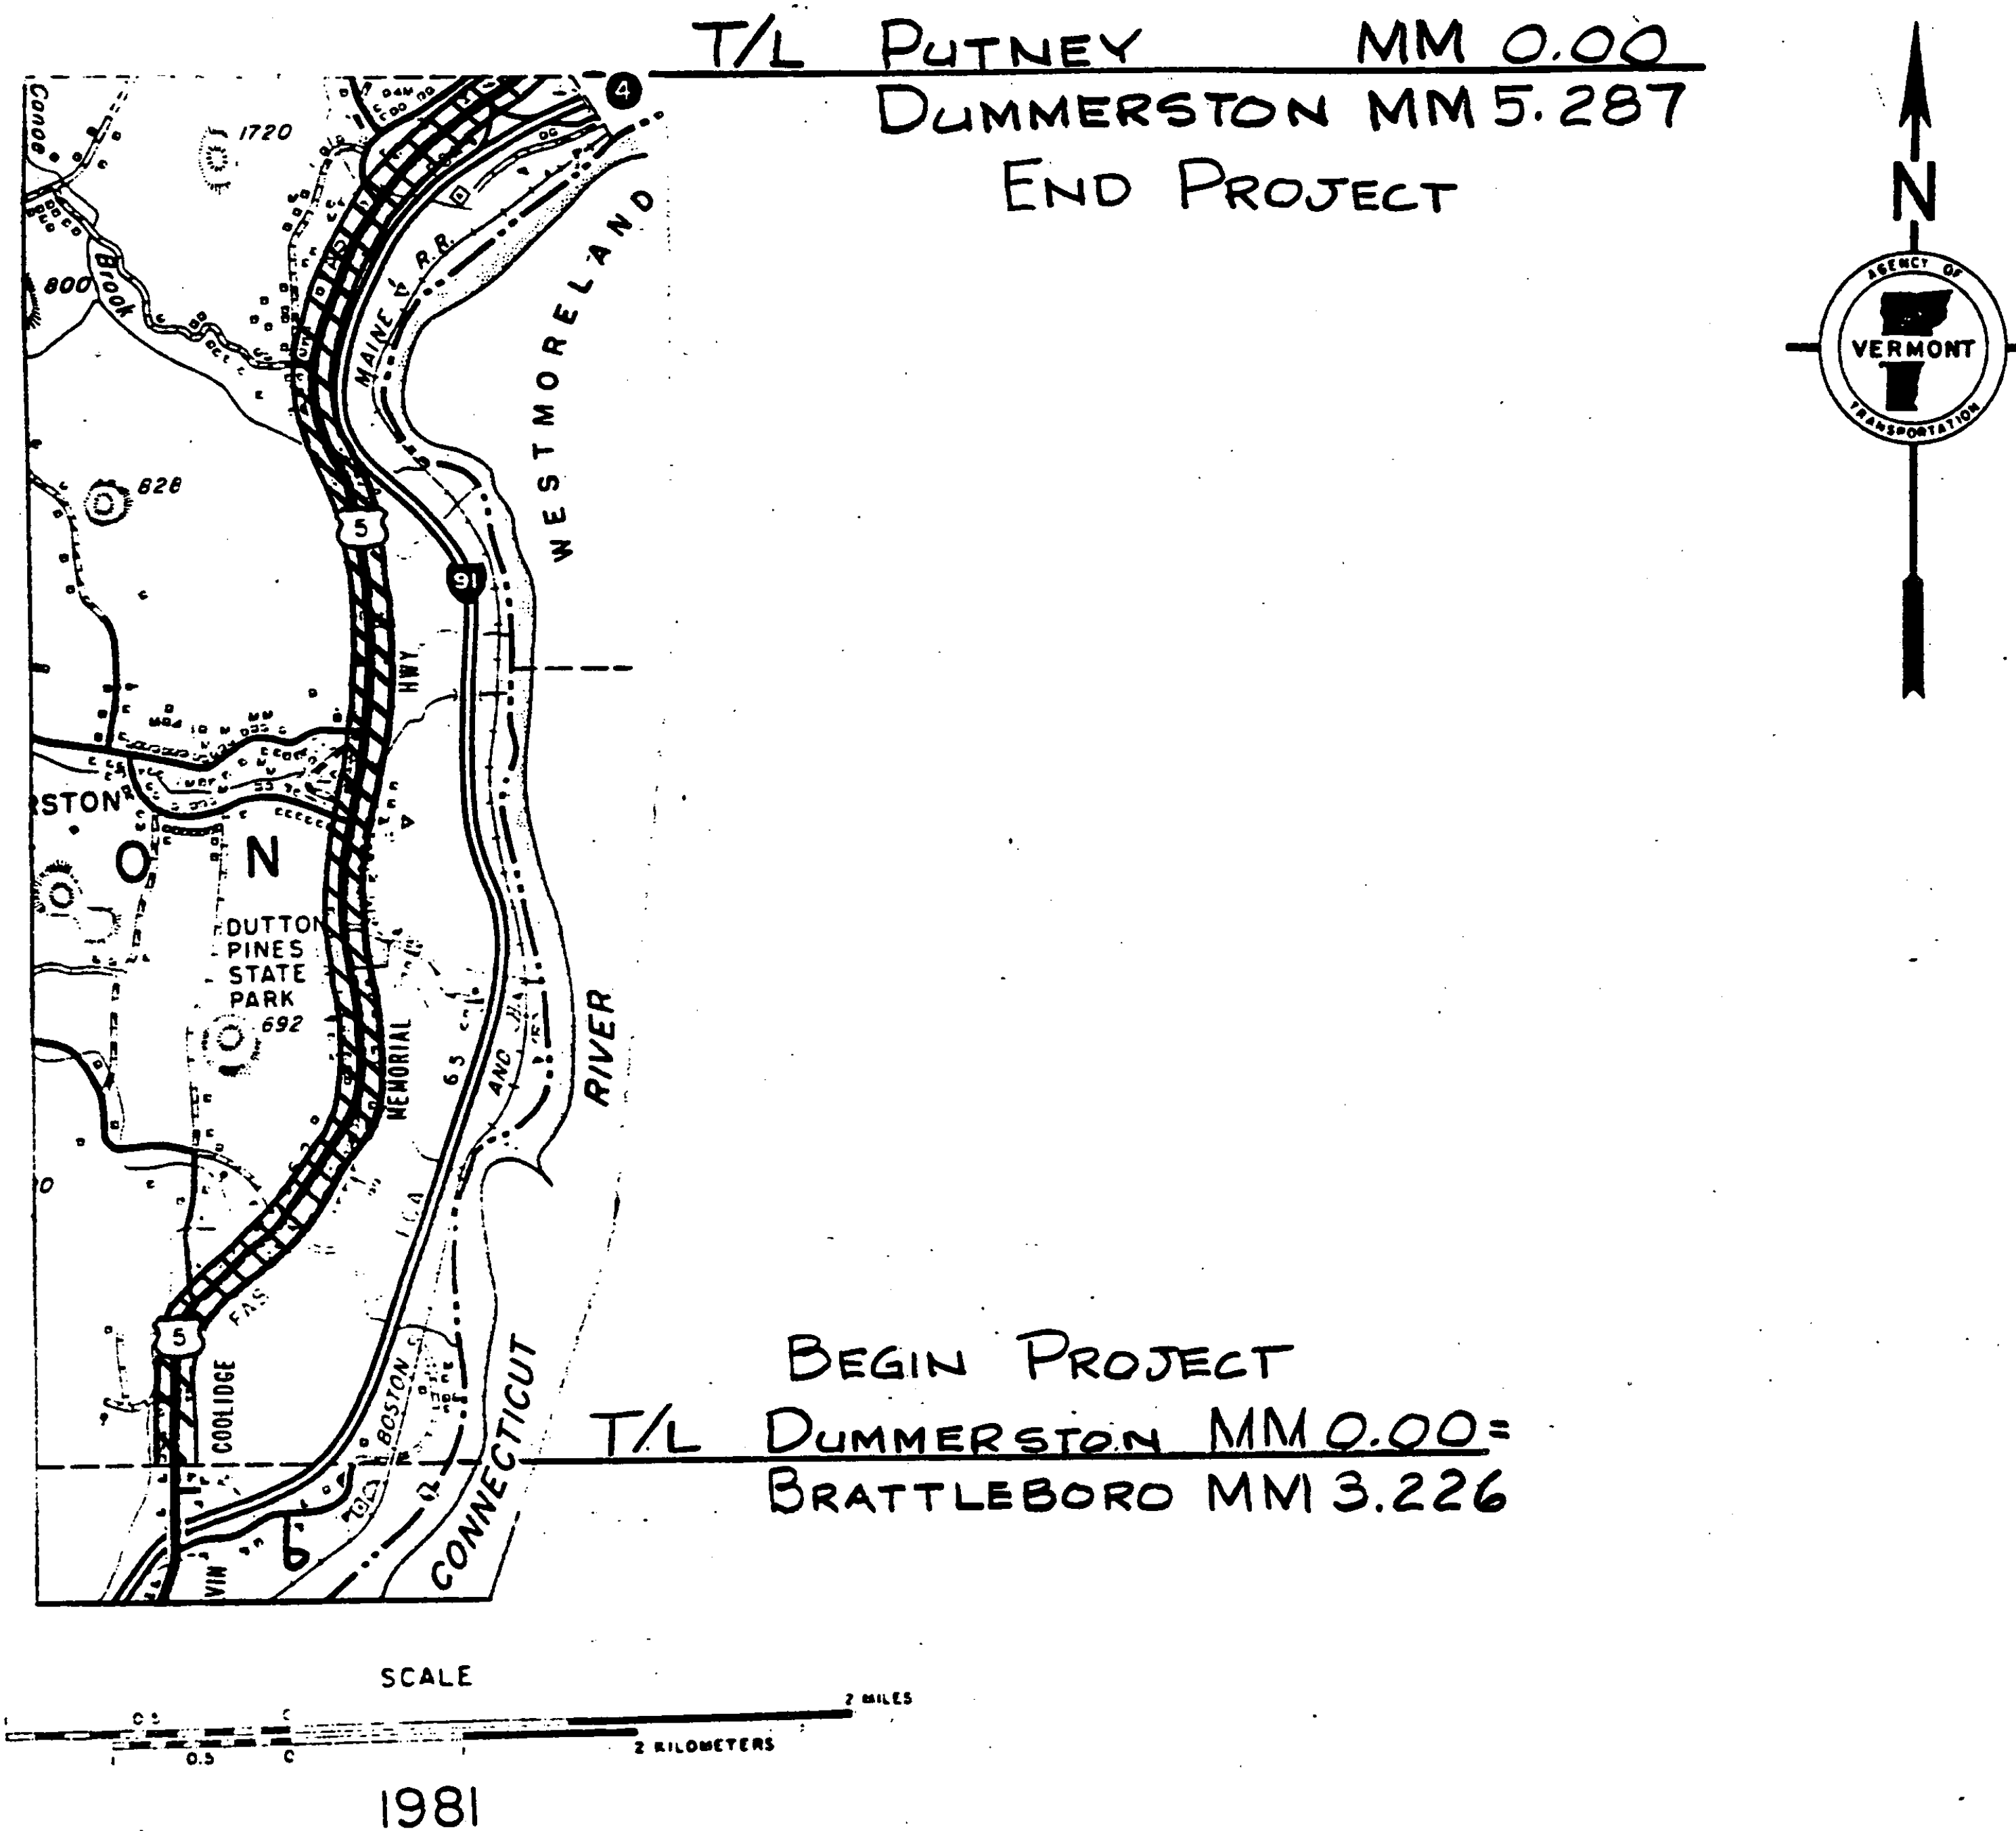

BEGINNING ON U.S. RTE. 5 AT THE BRATTLEBORO-DUMMERSTON TOWN LINE, THEN PROCEEDING NORTHERLY ON U.S. RTE. 5, 5.287 MILES, TO THE DUMMERSTON-PUTNEY TOWN LINE.

LENGTH OF PROJECT: 27913 FT.  
5.287 mi.

PROJECT DUMMERSTON

NO. RS 0113(37)

SHEET 11 OF 20 SHEETS