
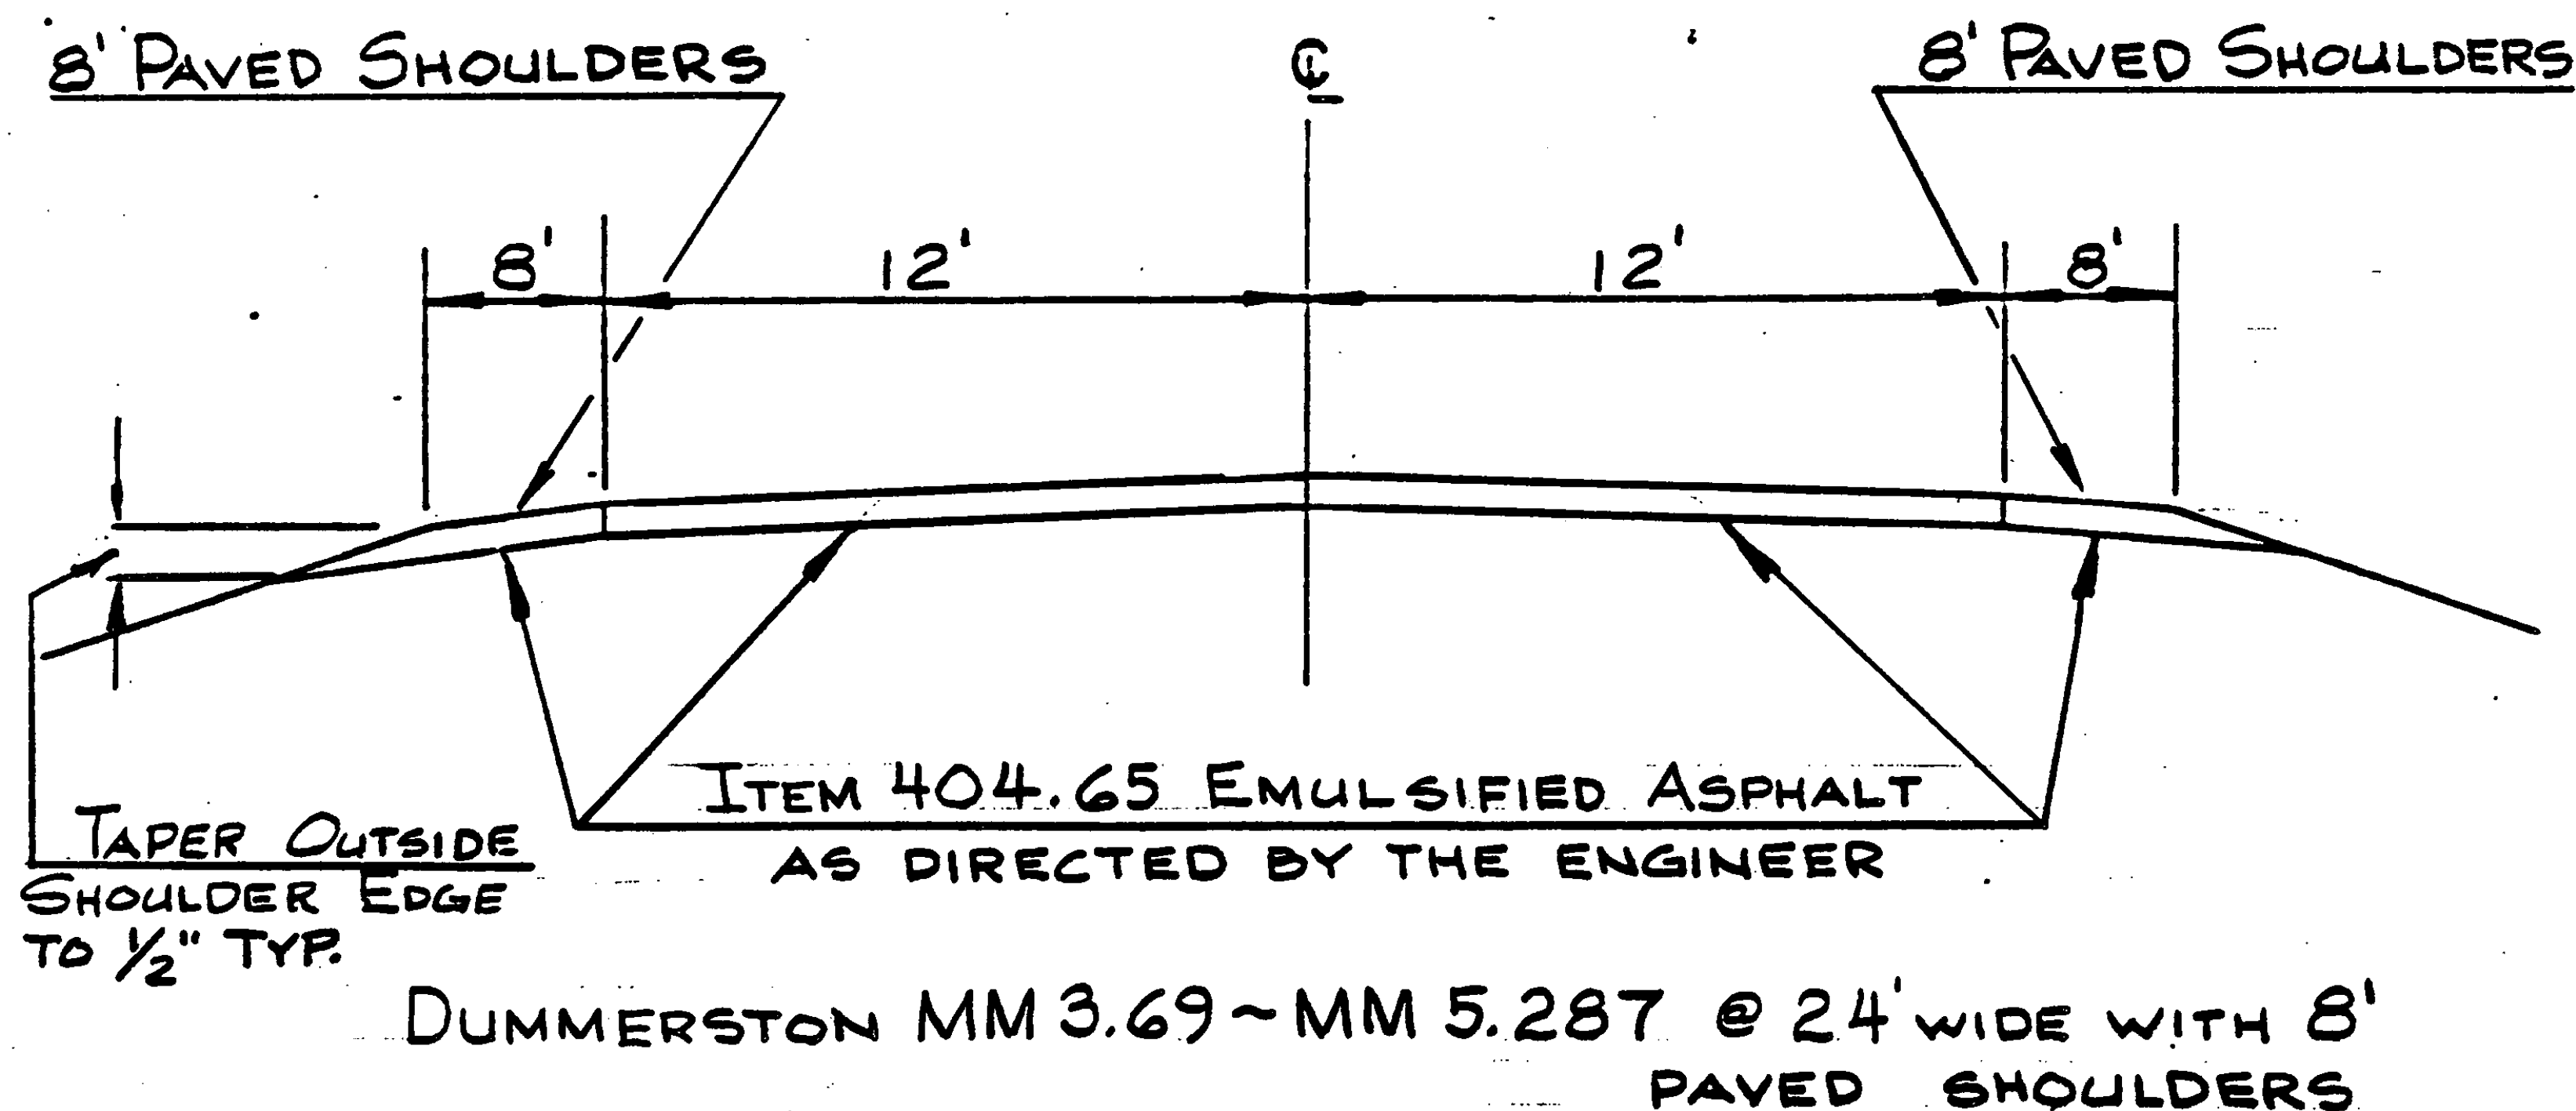


TYPICAL SECTIONS & DESIGN DATA

ITEM 406.25 BITUMINOUS CONCRETE PAVEMENT
LEVELING COURSE, TYPE III OR IV (24' WIDE @ 164 TONS/Mi.)
AS DIRECTED BY THE ENGINEER.
1 1/4" WEARING COURSE, TYPE III

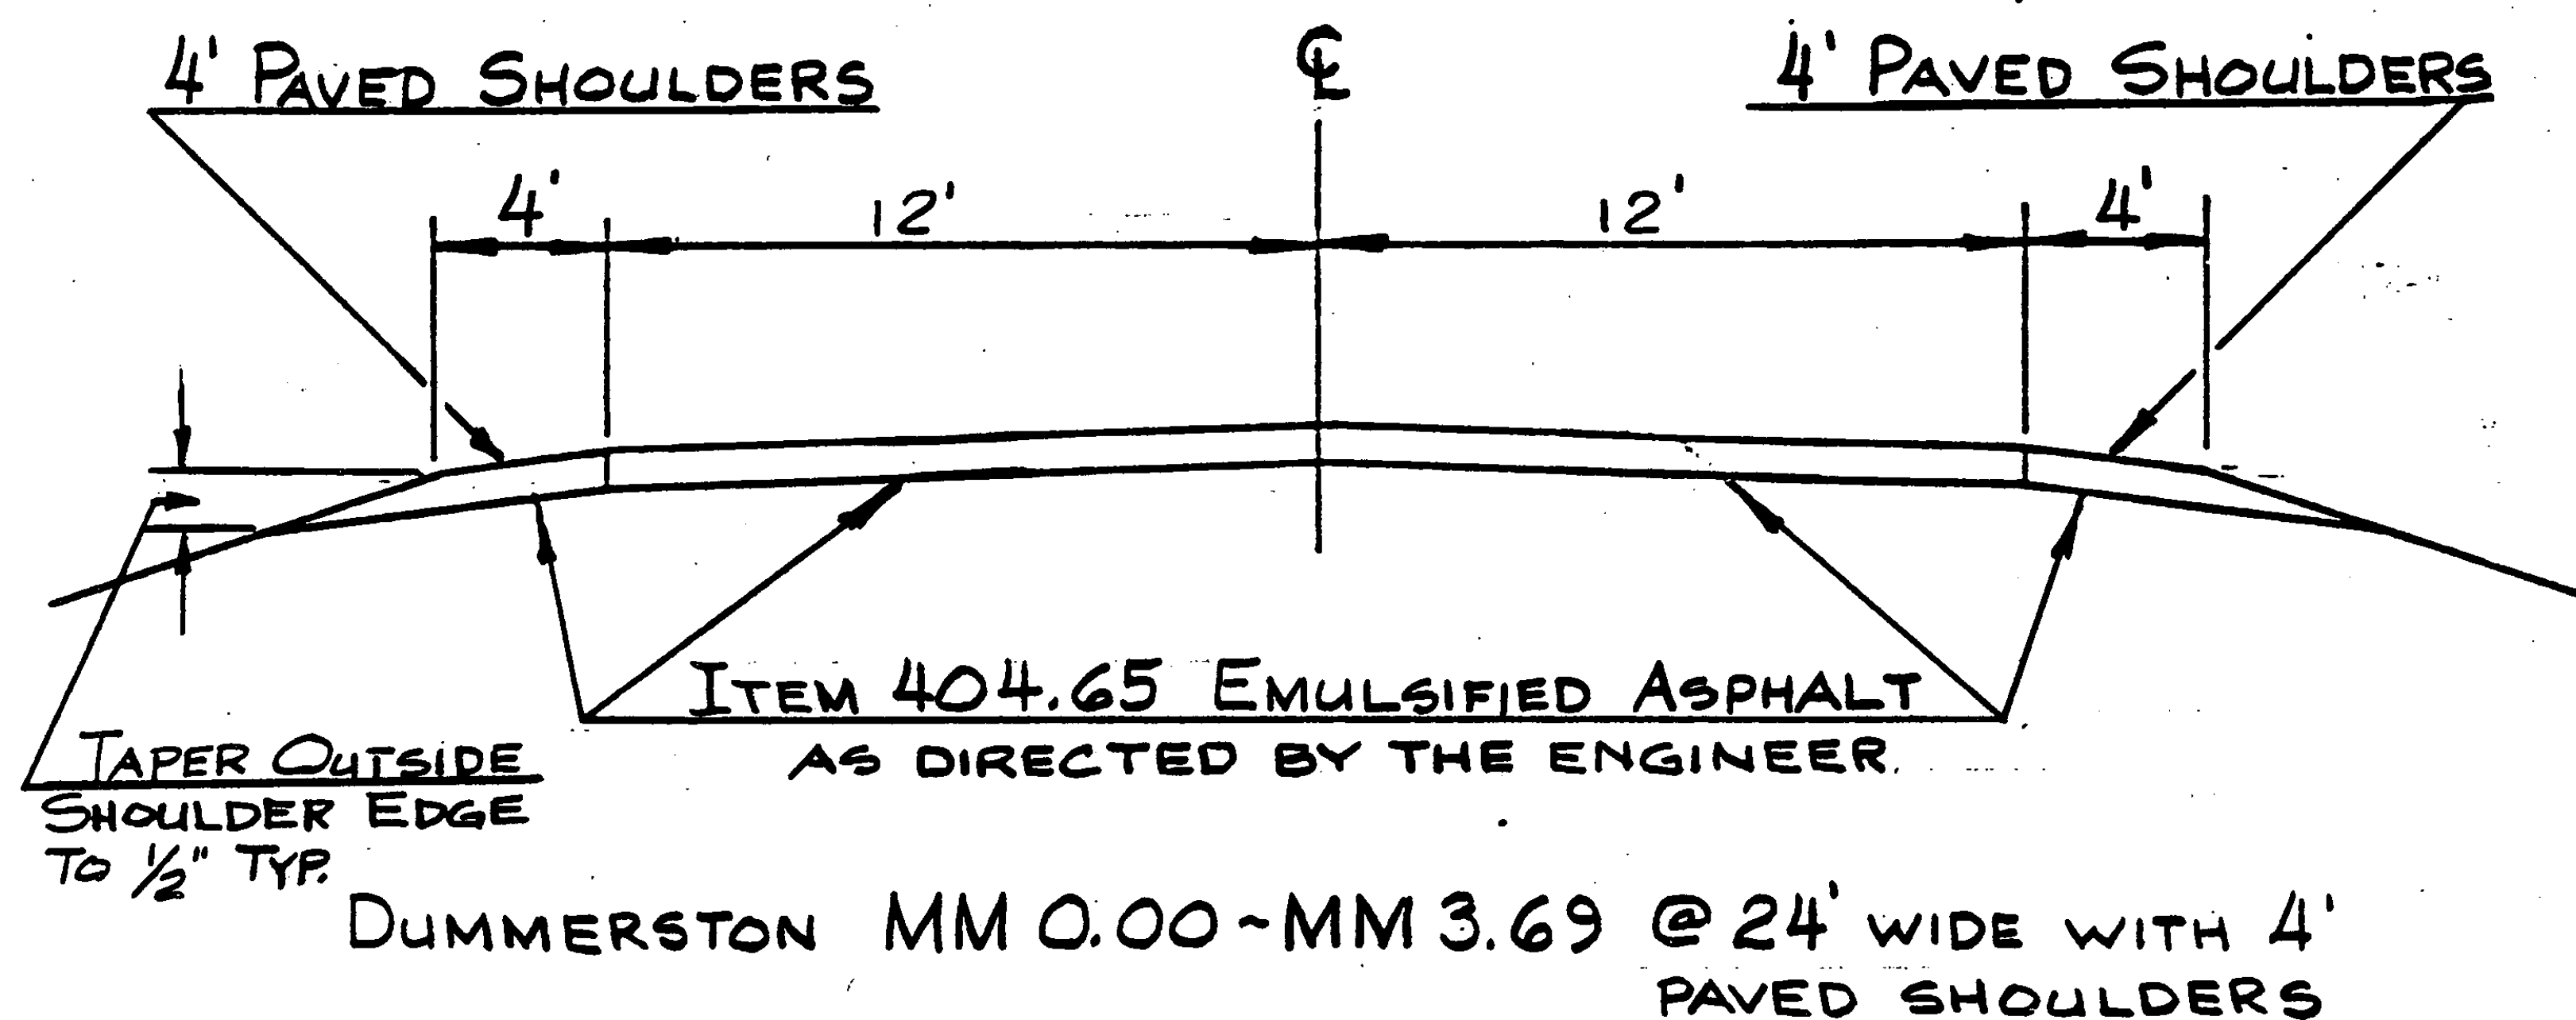

TRAFFIC DATA
1982 ADT = 3440
V = 50 MPH

PROJECT DUMMERSTON

NO. RS 0113(37)
SHEET 12 OF 20