
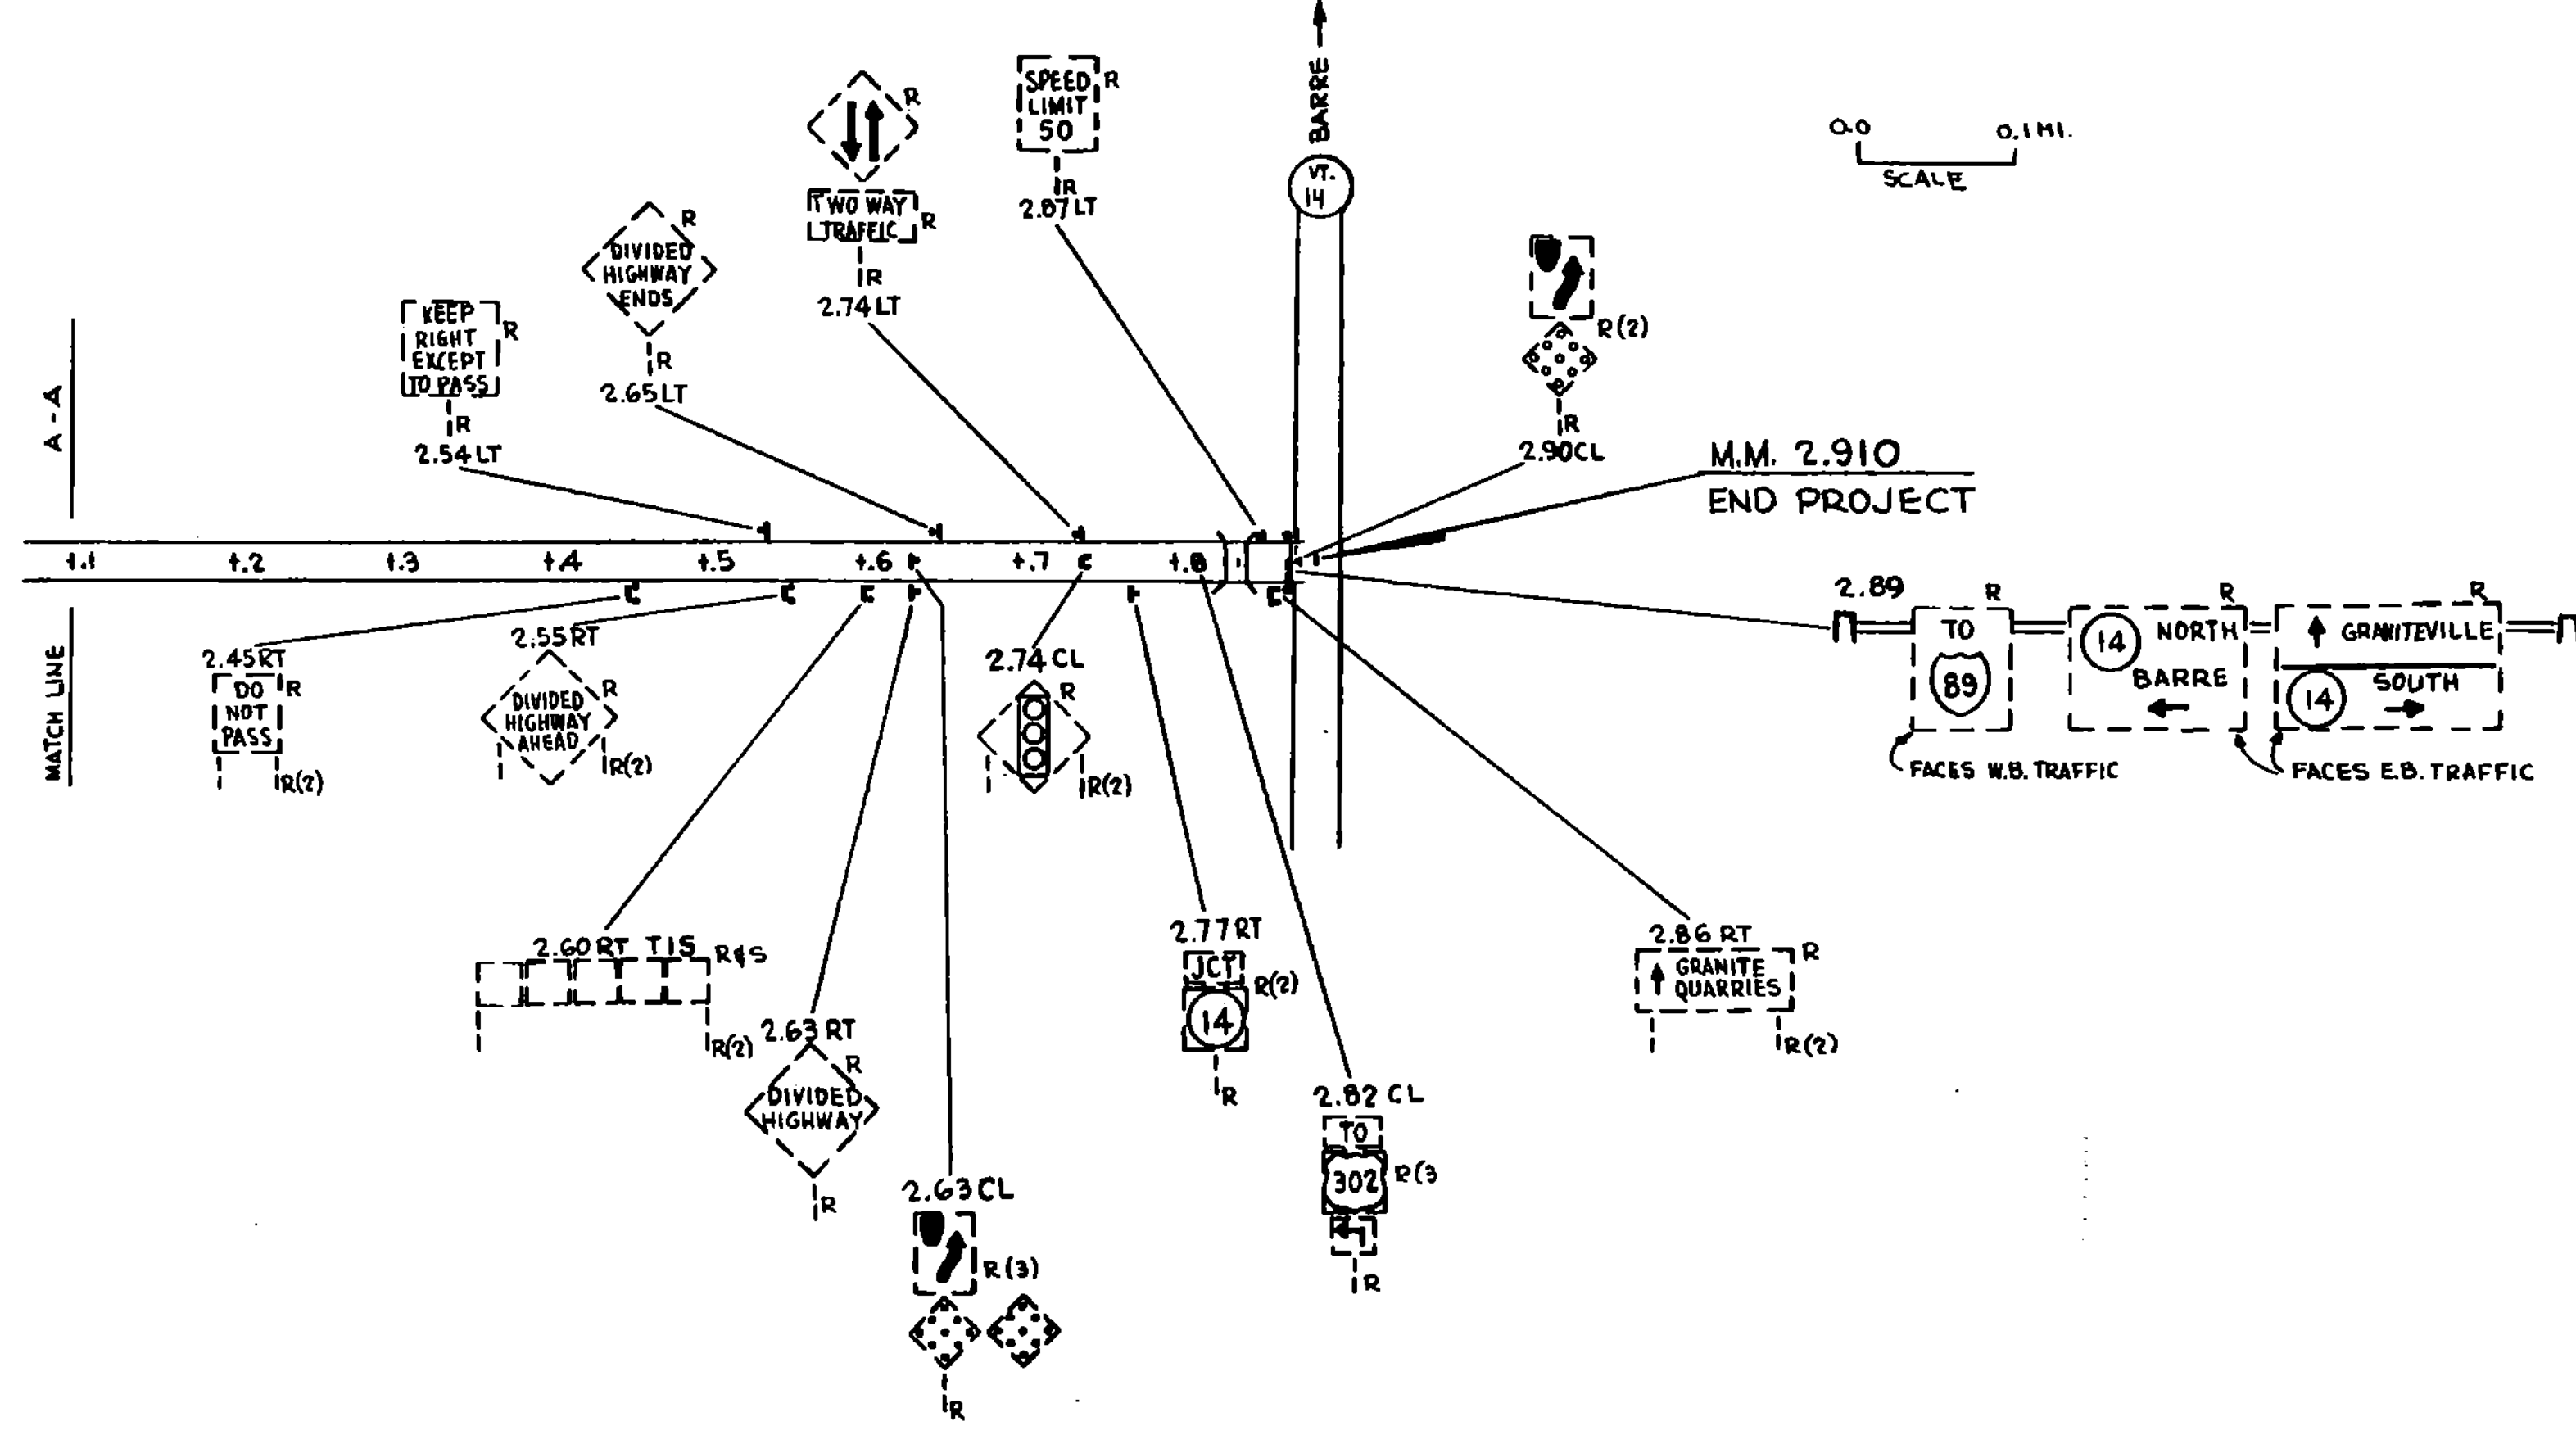


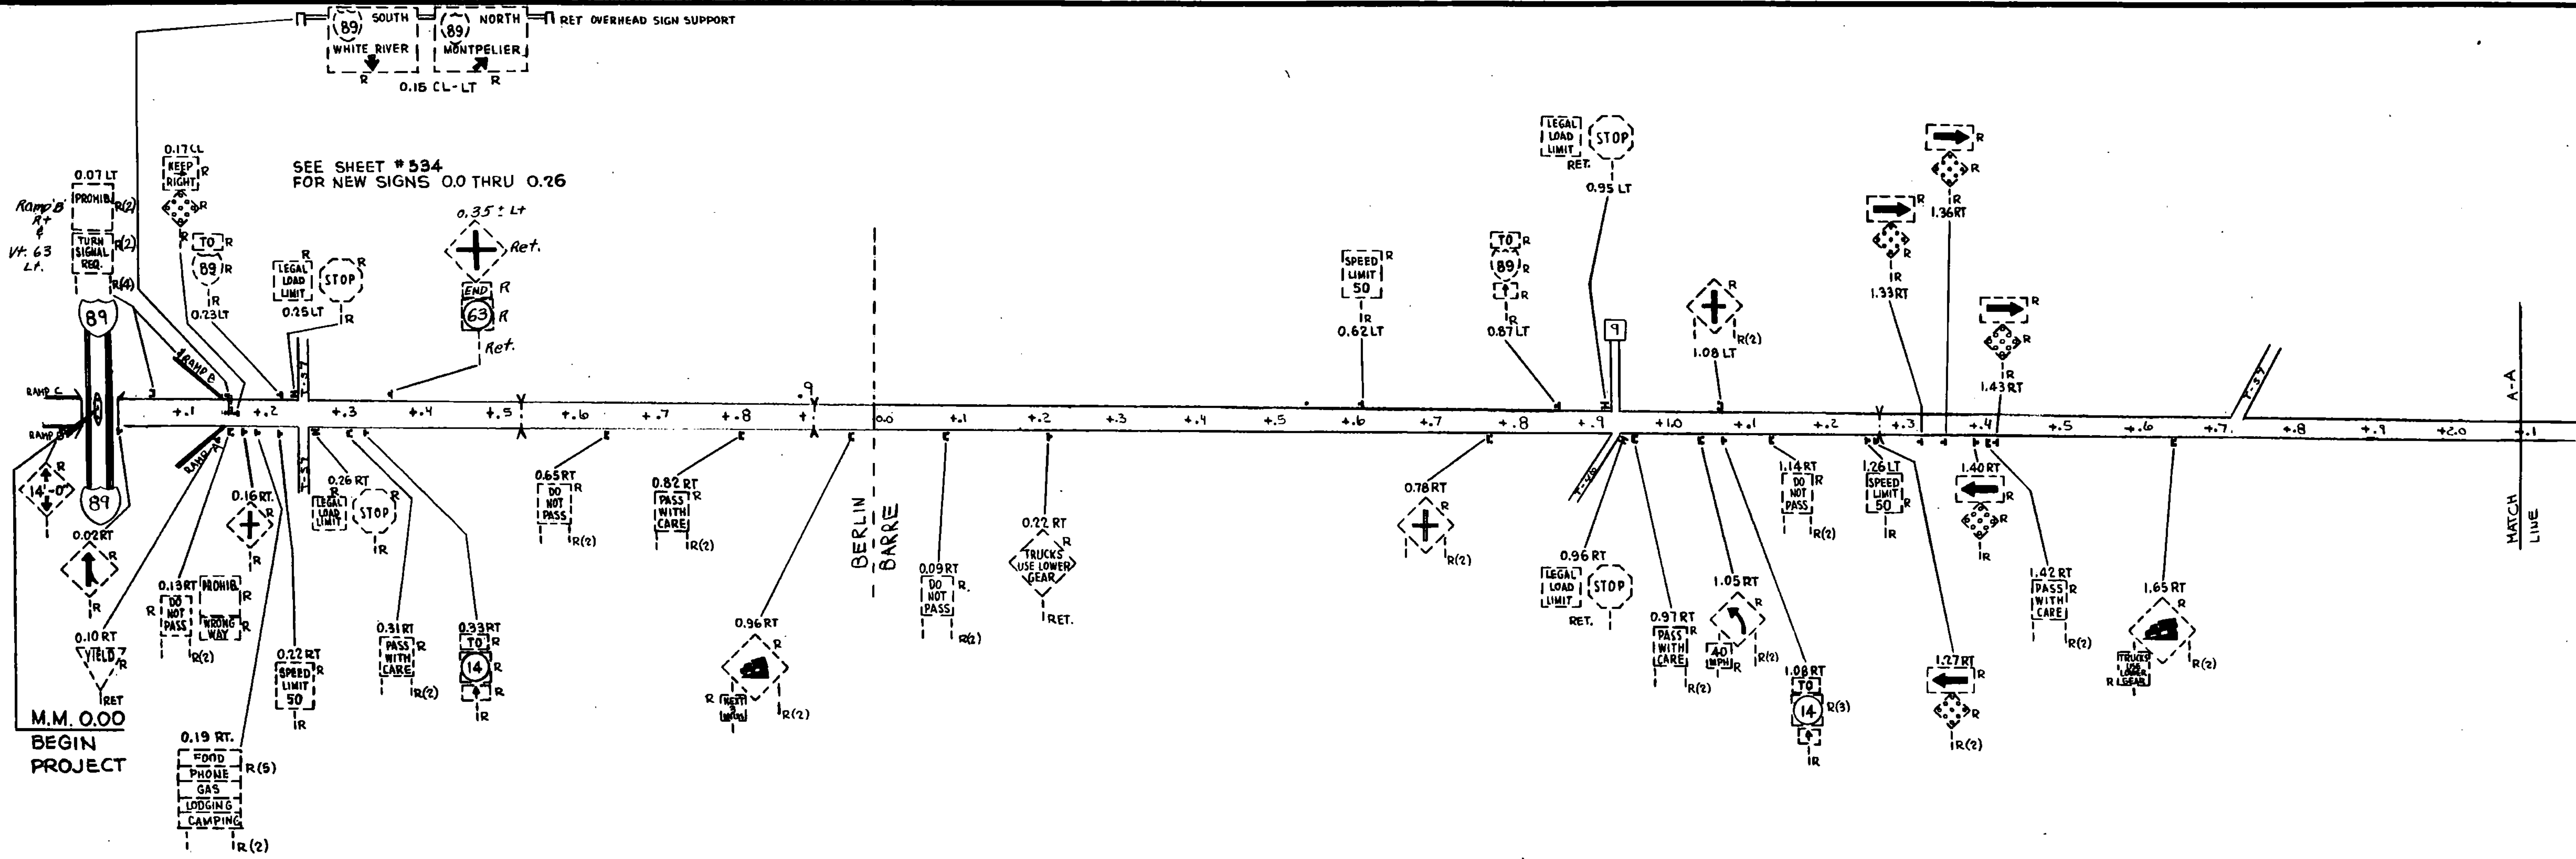

BERLIN-BARRE
F-SFTY(85)

LEGEND
R - REMOVE
N - NEW
R+S - REMOVE AND SALVAGE
S - SALVAGE

DATUM
VERTICAL _____
HORIZONTAL _____

EXISTING SIGNS

TRAFFIC SHEET NO. 533 SHEET _____ OF _____

SURVEYED BY _____ DATE _____
DRAWN BY _____ DATE _____
TRACED BY _____ DATE _____

BERLIN - BARRE

PROJ. STATEWIDE NO. F-SFTY (85)
SHEET 87 OF 200