


LEGEND
 RET - RETAIN
 R - REMOVE
 S - SALVAGE
 R & S - REMOVE AND SALVAGE
 N - NEW

REMOVE AND REPLACE GUARD-RAIL DELINEATORS, MOD.
 6.22 ± 12 UNITS
 1.87 ± 8 UNITS

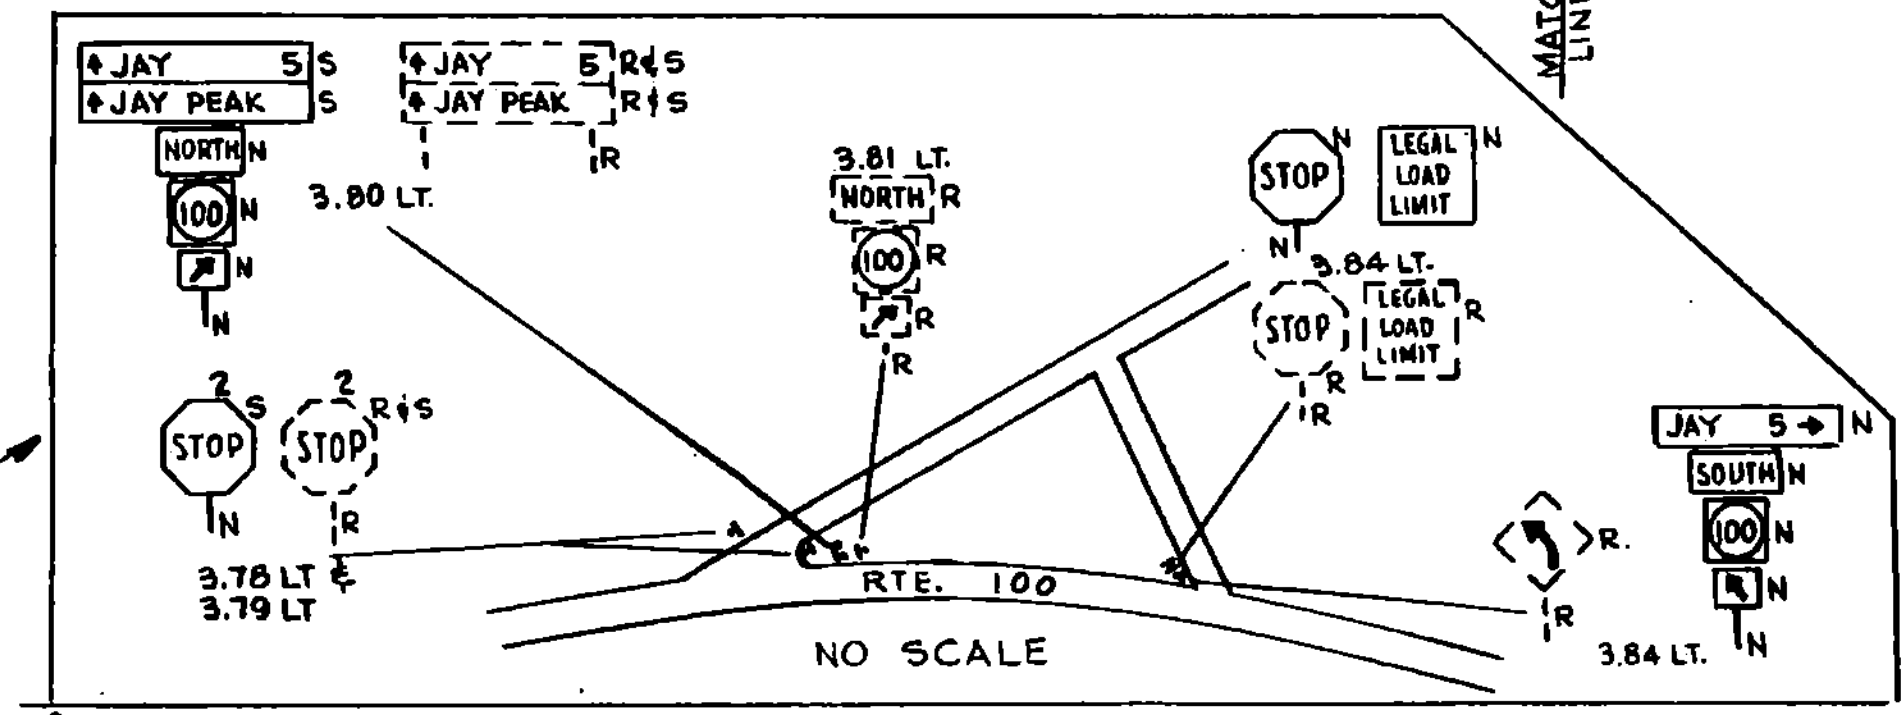

DATUM
 VERTICAL _____
 HORIZONTAL _____

0 0.1 0.2 MI.
 SCALE

SURVEYED BY _____ DATE _____
 DRAWN BY G.M. DATE 9/15/85
 TRACED BY _____ DATE _____
LOWELL - WESTFIELD
 PROJ. STATEWIDE NO. F-SFTY (85)S
 SHEET 105 OF 200

BRUNNEN 13428-3