


New Signs to be Supplied by State.
Erect As Salvaged Signs

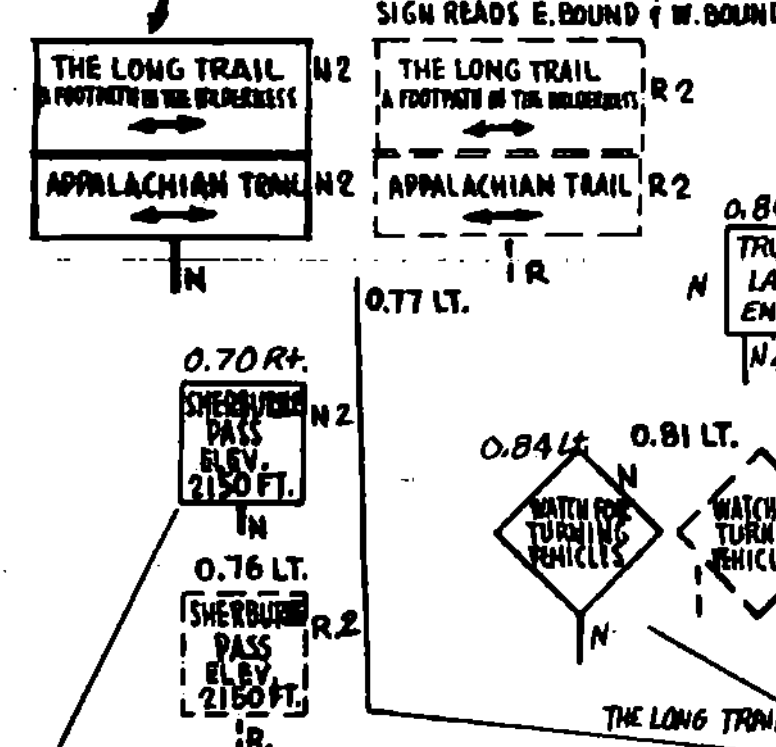

NOTE:
For New Signs mm 2.00
to end of project, see Sh. #545

- LEGEND**
- R - REMOVE
 - RET - RETAIN
 - R+S - REMOVE & SALVAGE
 - N - NEW
 - S - SALVAGED
 - [Symbol] - EXISTING SIGN
 - [Symbol] - NEW OR SALVAGED SIGN

DATUM
VERTICAL _____
HORIZONTAL _____

SURVEYED BY _____ DATE _____
DRAWN BY S.H.M. DATE 9/10/85
TRACED BY _____ DATE _____
MENDON-SHERBURNE
STATEWIDE F-SFTY (85) S
TRAFFIC SIGN NO. 70 COUNTY NO. 100