


GORE SIGN PLACEMENT DETAIL

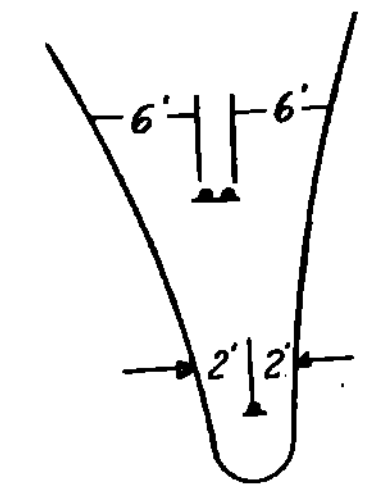

NEW SIGNS  
M.M. 2.00 ~ END of PROJECT

- Temp. 4" White Line  
Vt 100 - West Approach (As Shown)  
U.S. 4 - U-Turn Rt. - Edgeline Rt-MM 1.10~1.21 ±
- Temp. 8" White Line (Gore)  
US 4 & Vt 100 - West Intersection (As Shown)
- Temp. Arrow Marking  
Vt 100 - As Shown
- Temp. Letter in Word Marking  
Vt 100 - As Shown  
U.S. 4 - U-Turn Rt. - MM 1.20 ± "STOP"
- Temp. 24" Stop Bar  
U.S. 4 - U-Turn Rt - MM 1.20 ±
- Temp. 4" Yellow Line (Dbl.)  
U.S. 4 - Painted Island (As Shown)  
Vt 100 - Painted Island (As Shown)  
Vt 100 - Centerline  
U.S. 4 - U-Turn Rt. - Edgeline Lt. - MM 1.10~1.21 ±
- Temp. 8" Yellow Line  
Vt 100 - West Approach - Diagonal Lines  
(Painted Island - See Detail this sheet)

Remove Existing Pavement Markings  
U.S. 4 - Painted Island - As Shown  
Vt 100 - & If Necessary - As Shown

DATUM	_____
VERTICAL	_____
HORIZONTAL	_____

PREPARED BY J.B. DATE 1-86  
CHECKED BY \_\_\_\_\_ DATE \_\_\_\_\_  
MENDON - SHERBURNE  
PROJ. STATEWIDE NO. F-SFTY(85)S  
TRAFFIC SHEET NO. 72341 SHEET 21 OF 23