

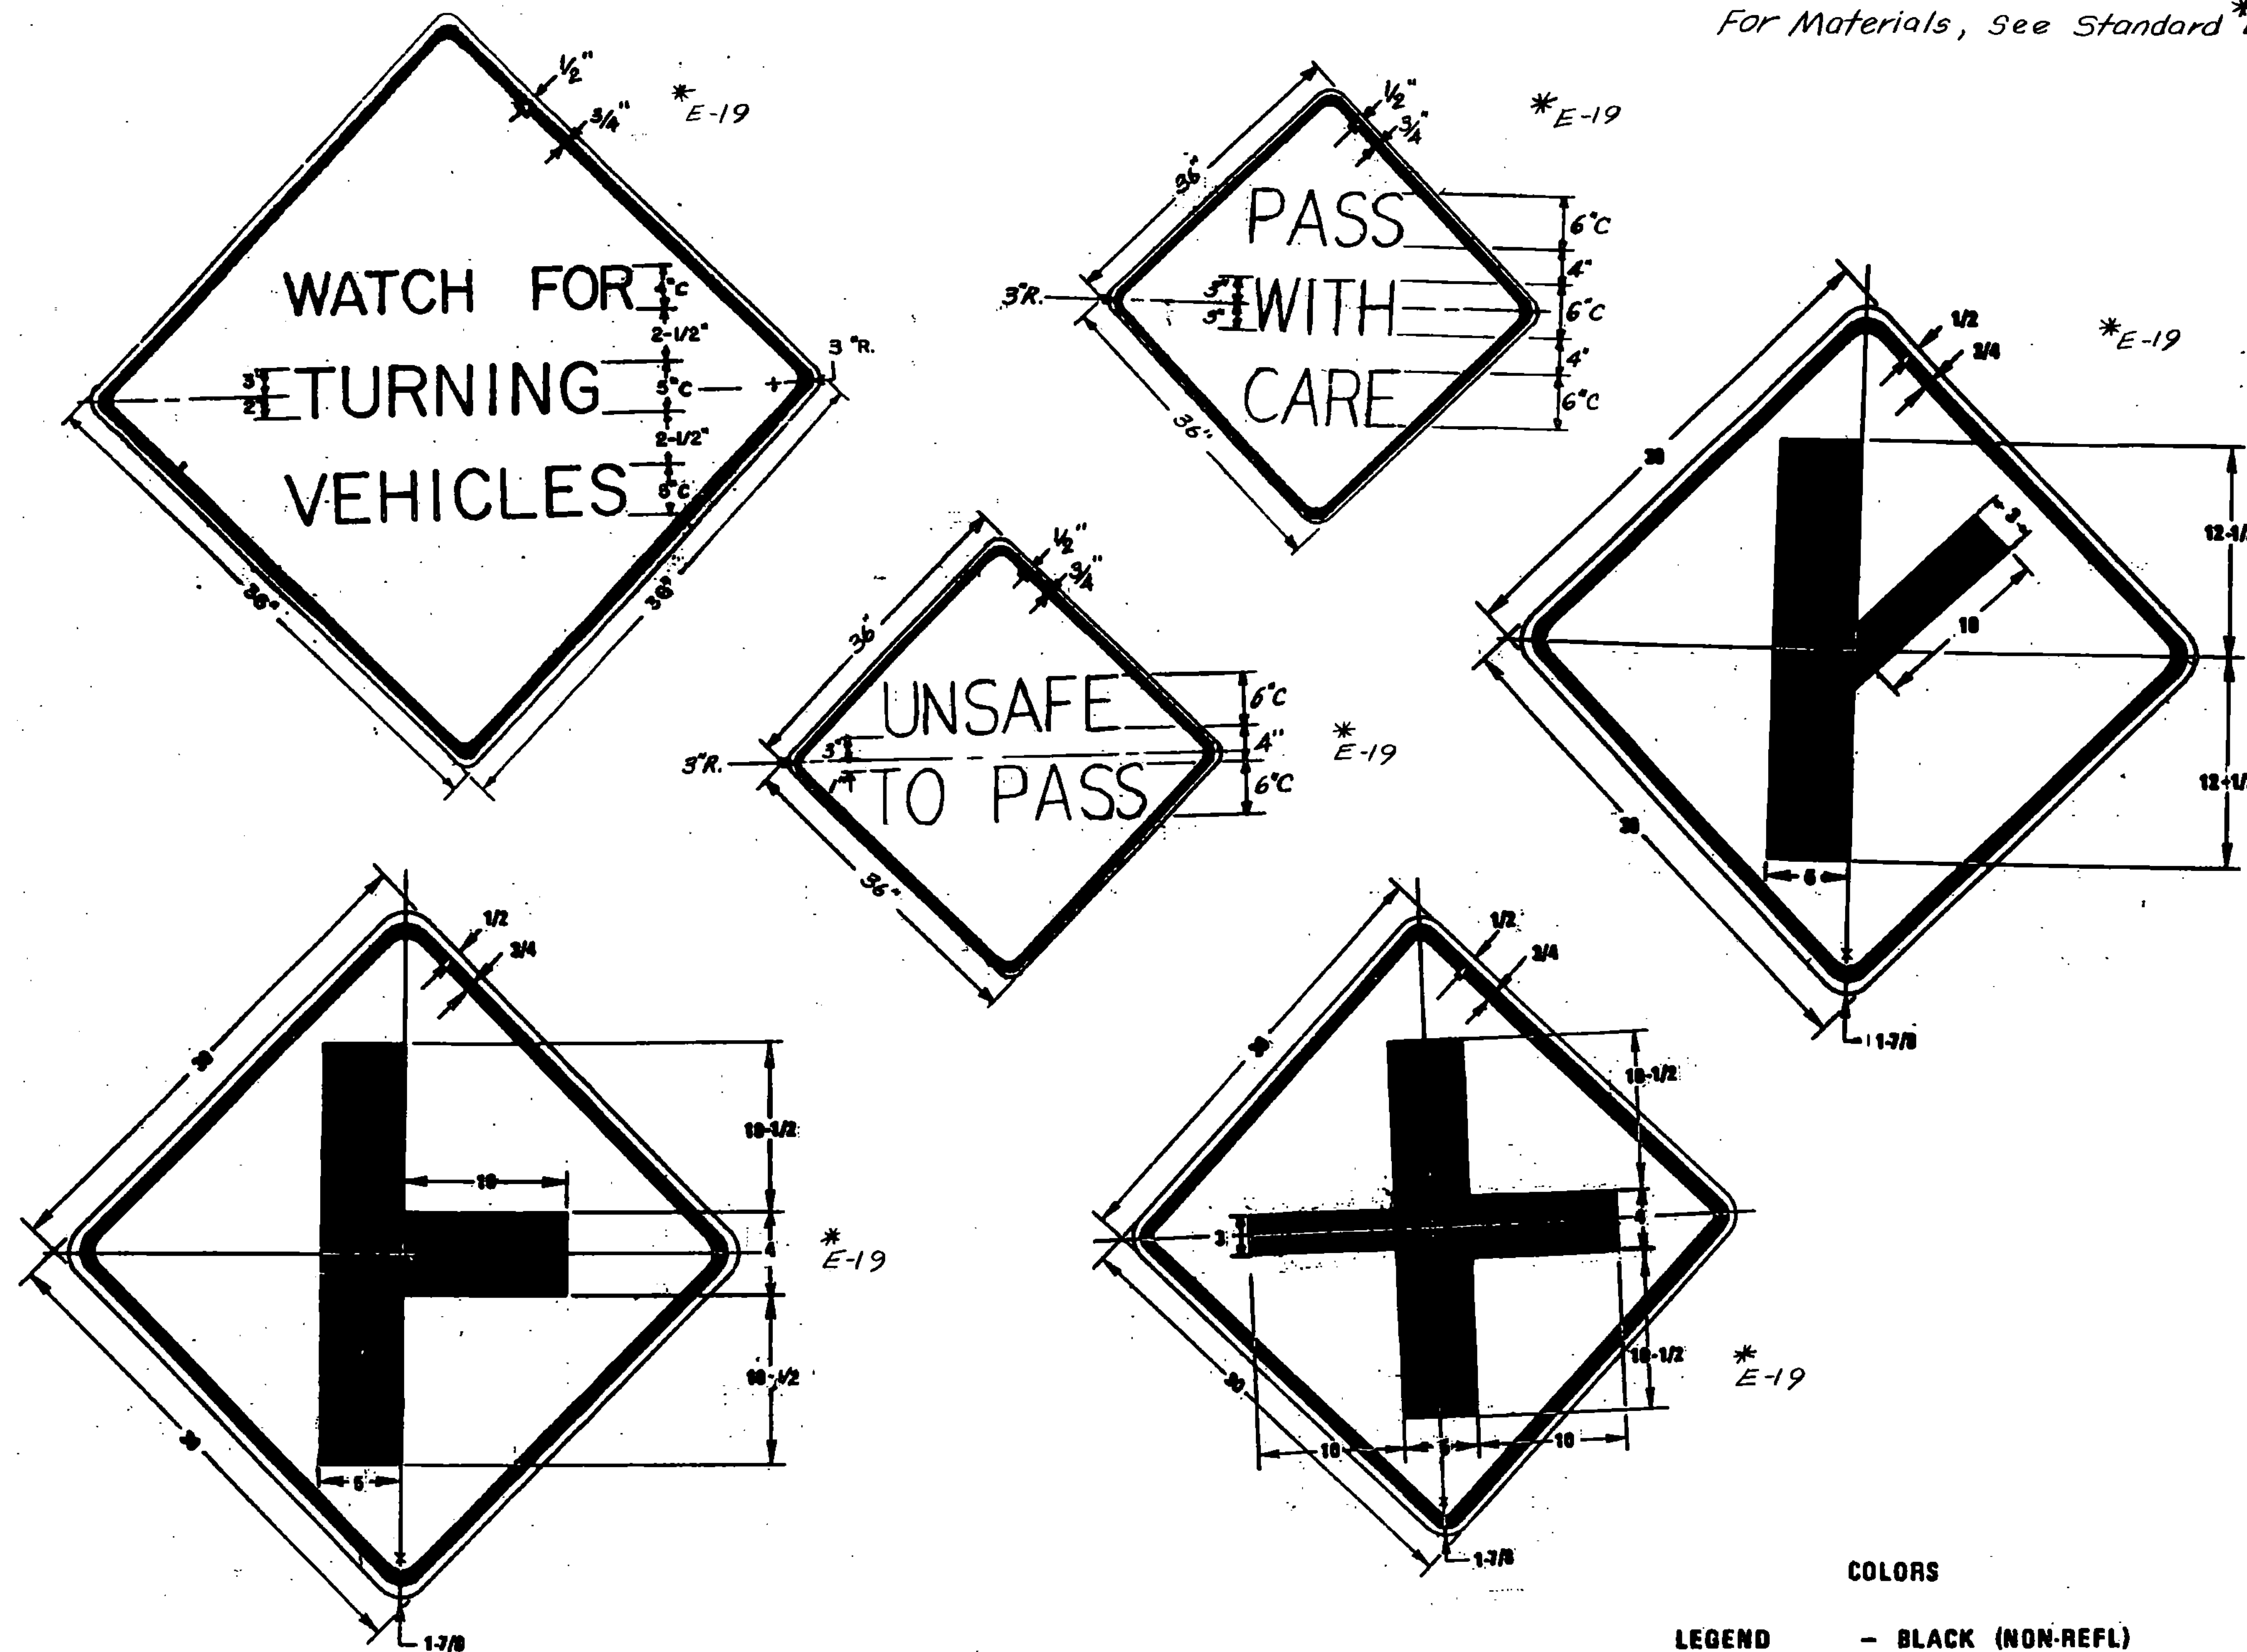


For Materials, See Standard *E-

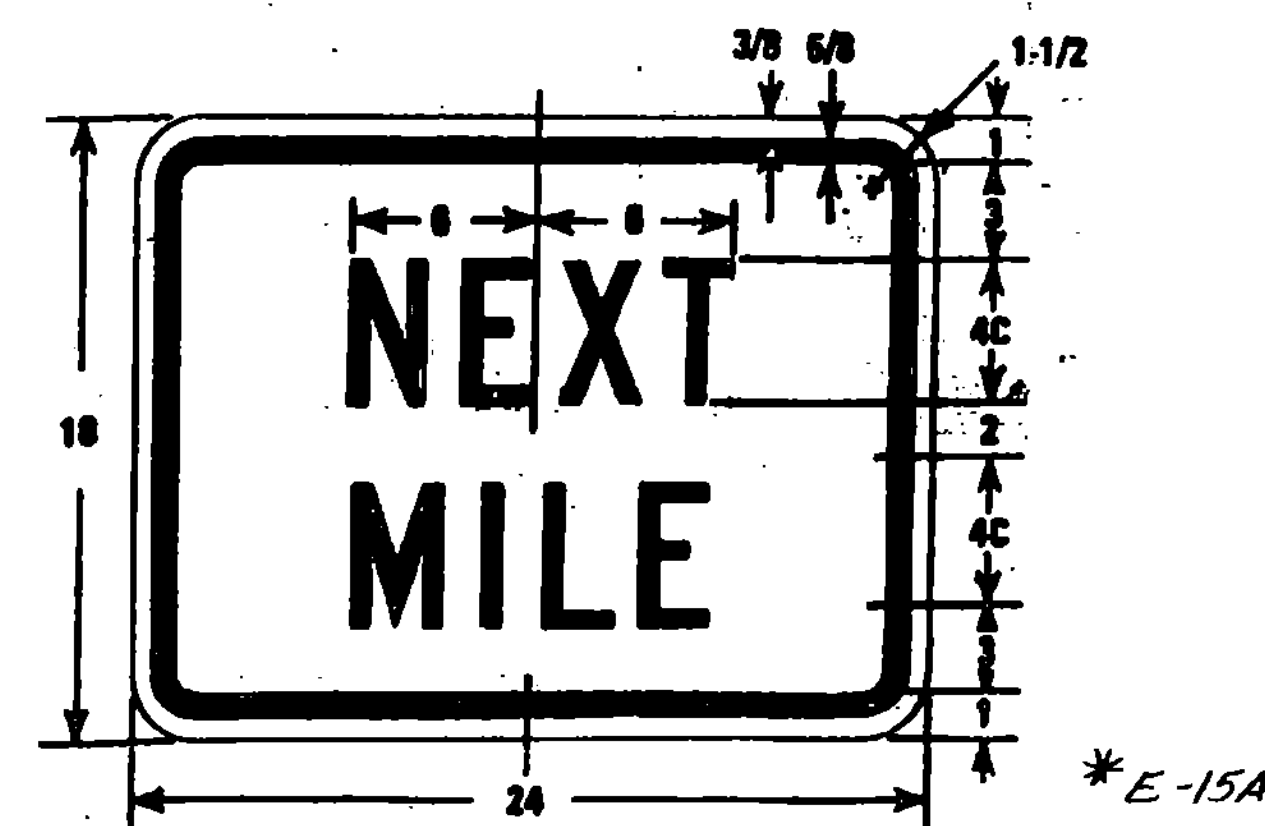





COLORS

LEGEND - BLACK (NON-REFL)
BACKGROUND - YELLOW (REFL)


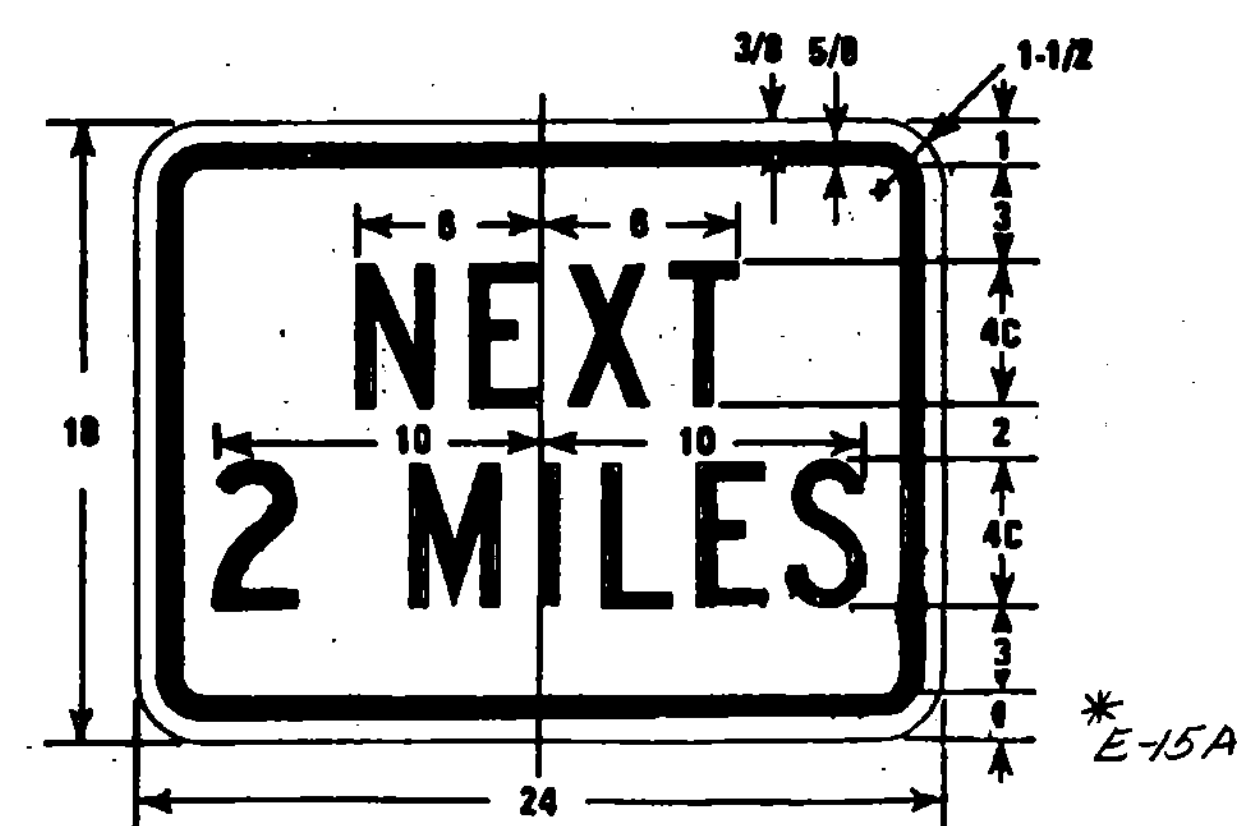


COLORS

LEGEND - BLACK (NON-REFL)
BACKGROUND - WHITE (REFL)

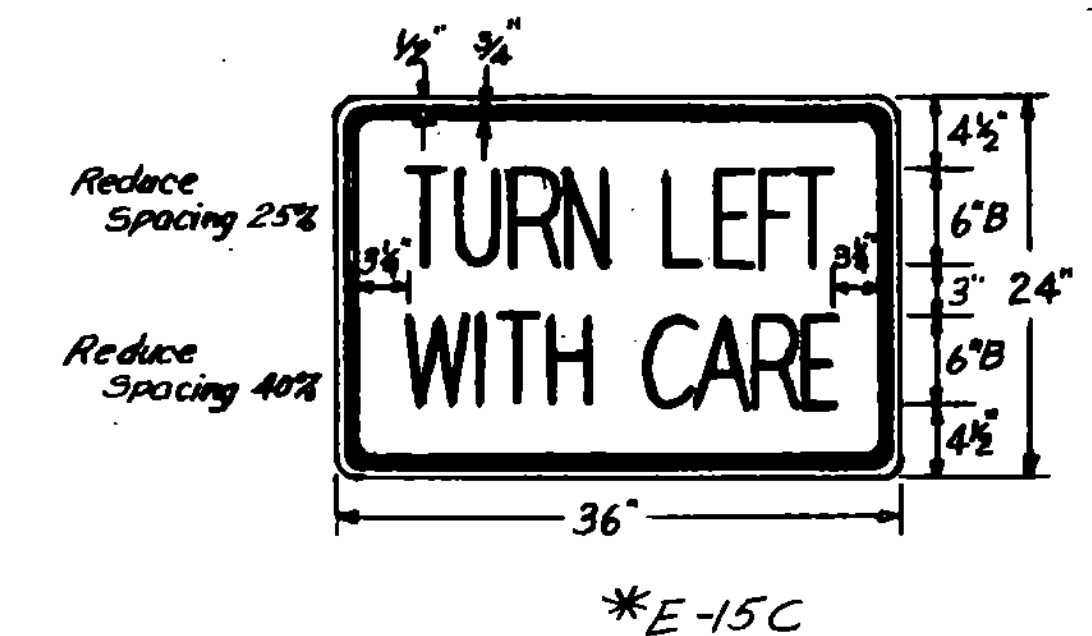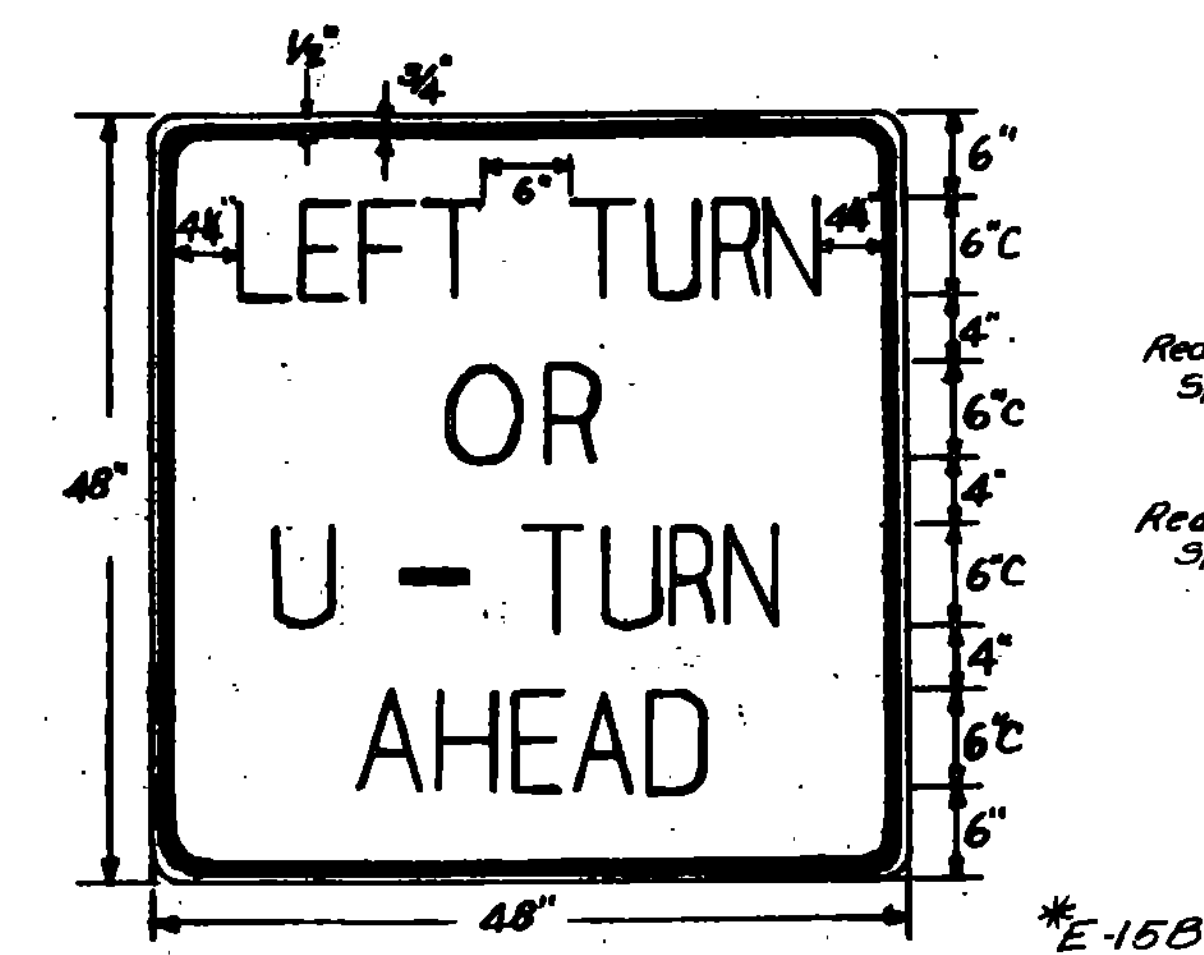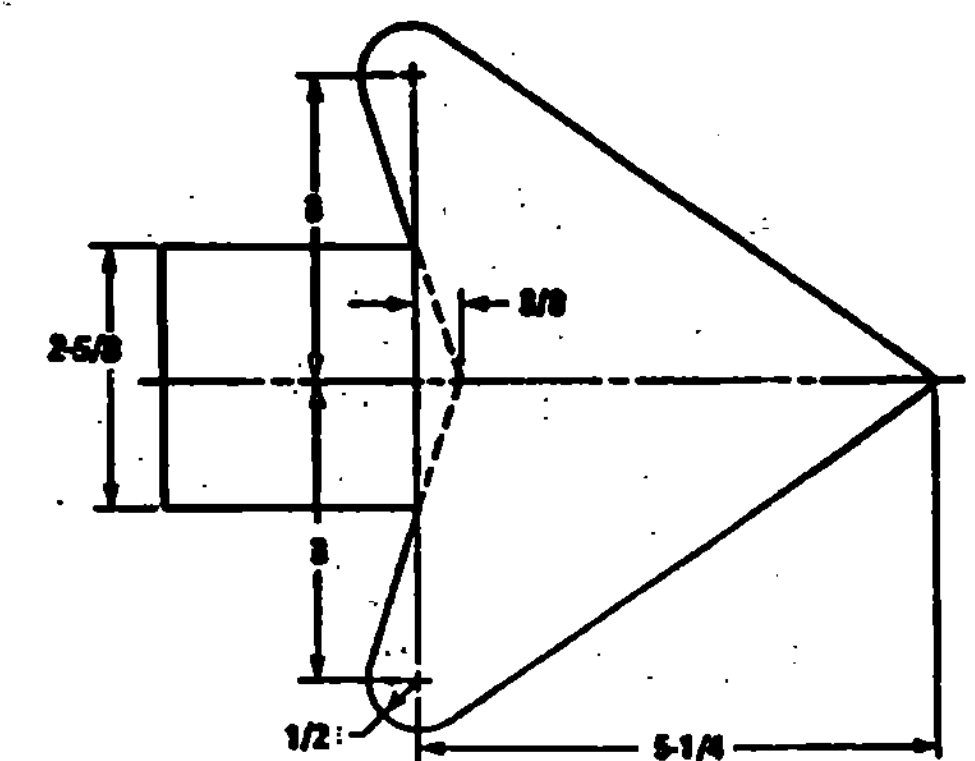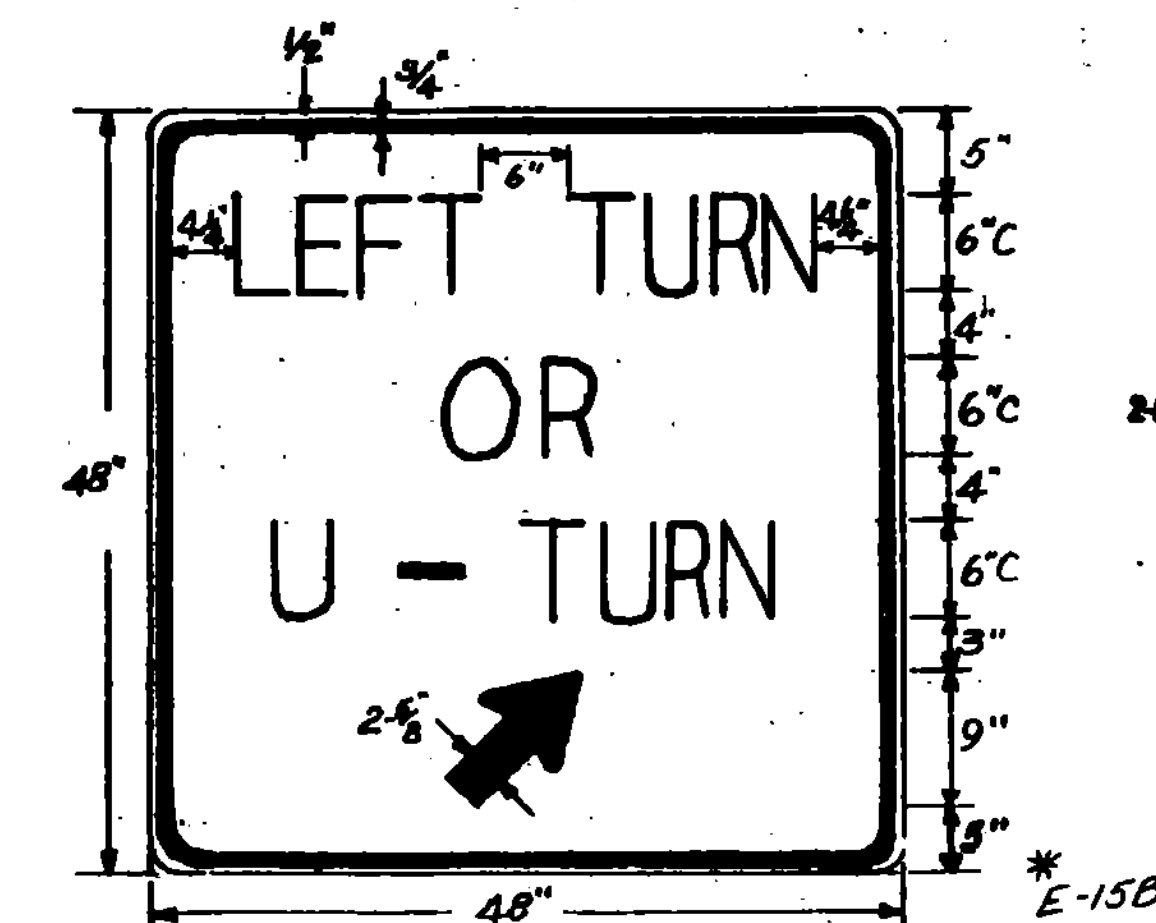

*
FLAT SHEET ALUMINUM - 0.125"
HIGH DENSITY OVERLAD PLYWOOD - 5/8"
GALVANIZED FLAT SHEET STEEL - 12 GAGE

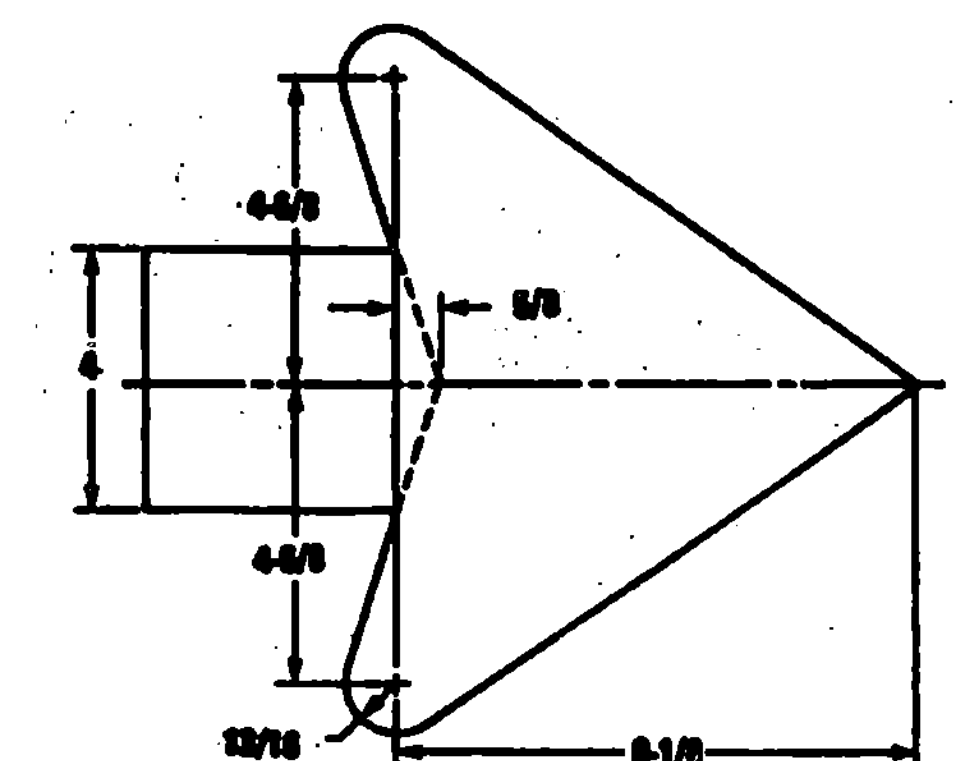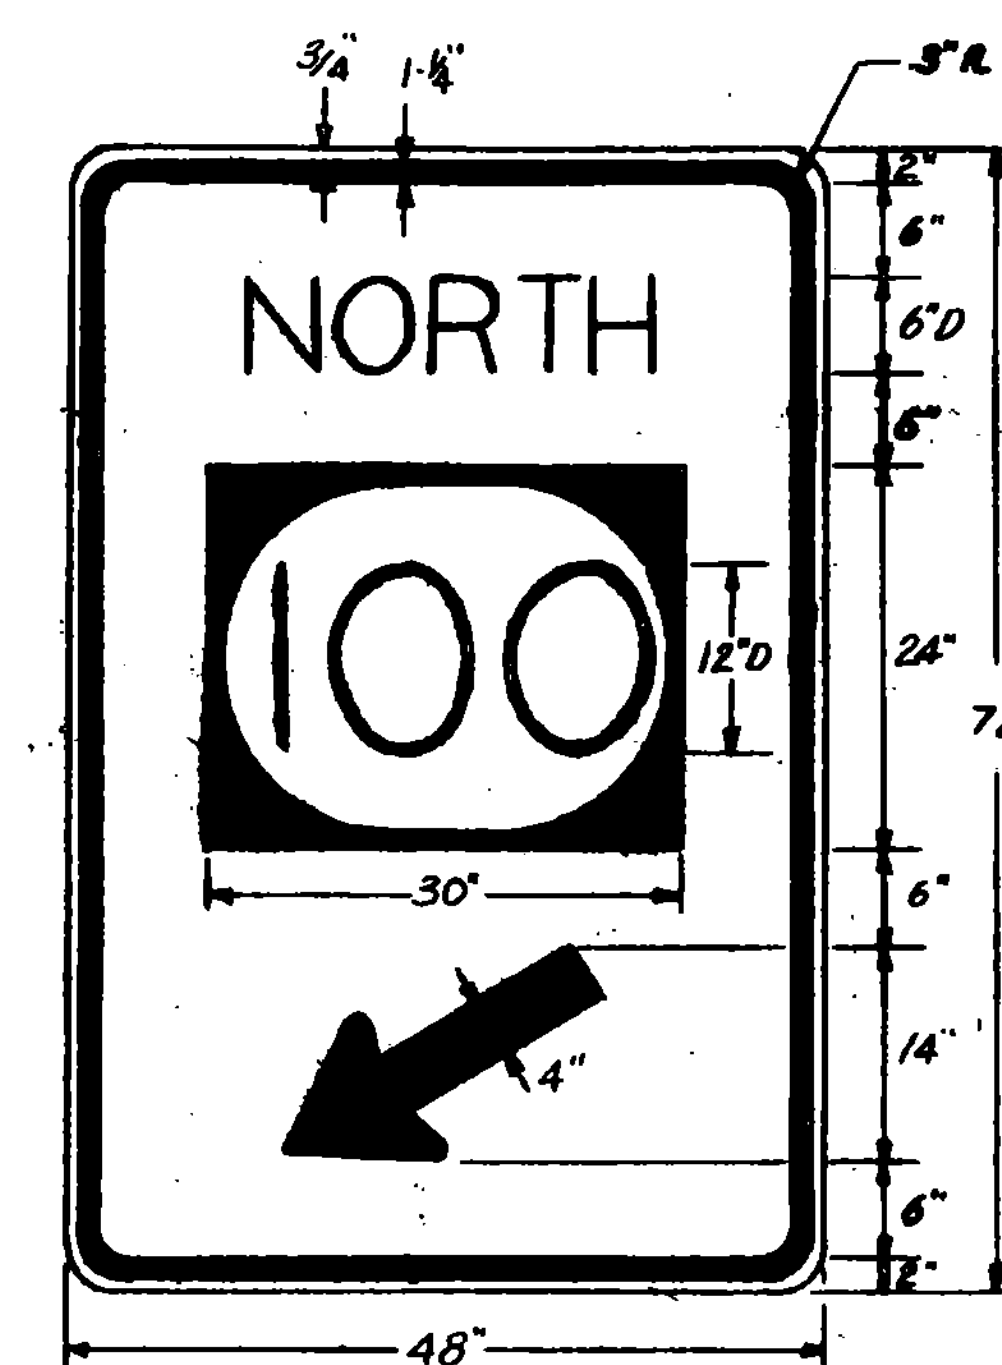

SURVEYED BY _____ DATE _____
DRAWN BY JB DATE 3-86
TRACED BY _____ DATE _____

MENDON ~ SHERBURNE
PROJ. NO. F-SFTY (85)S
STATEWIDE
TRAFFIC SHEET NO. JD 517 SHEET 133 OF 200