


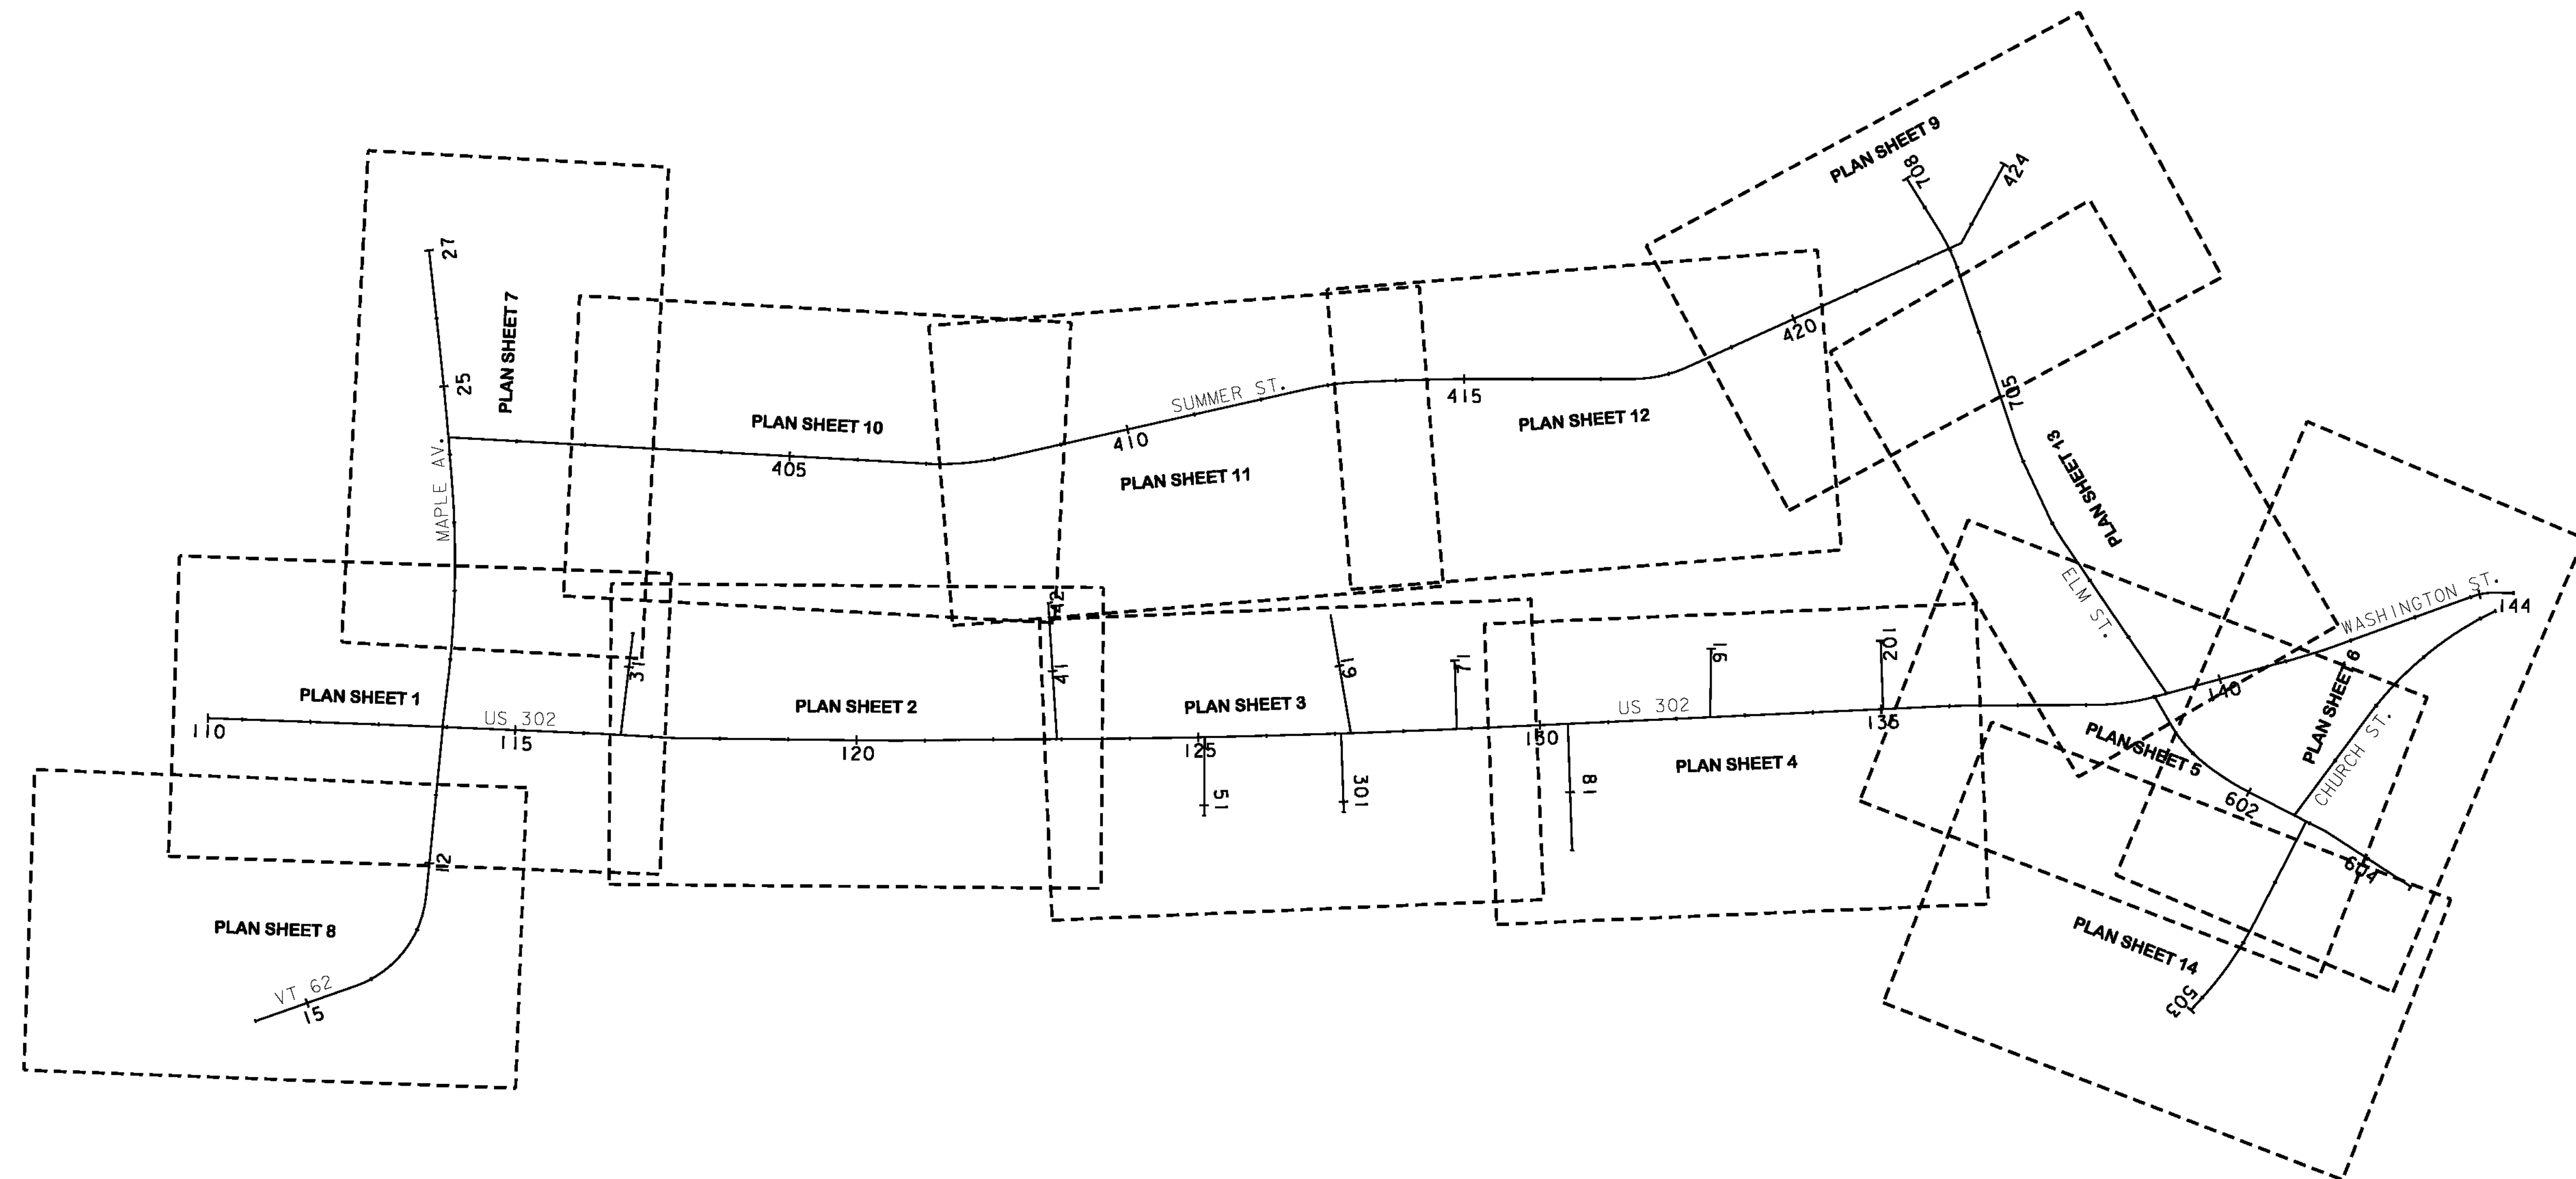

PROJECT NAME: BARRE CITY	
PROJECT NUMBER: FEFC F 026-1(34) C/2	
FILE NAME: z85b010_PLANKEY_C2	PLOT DATE: 3/9/2011
PROJECT LEADER: G. BAKOS	DRAWN BY: DMP / JAR
DESIGNED BY: DMP / MDS	CHECKED BY:
PLAN SHEET KEY	SHEET 29 OF 339