


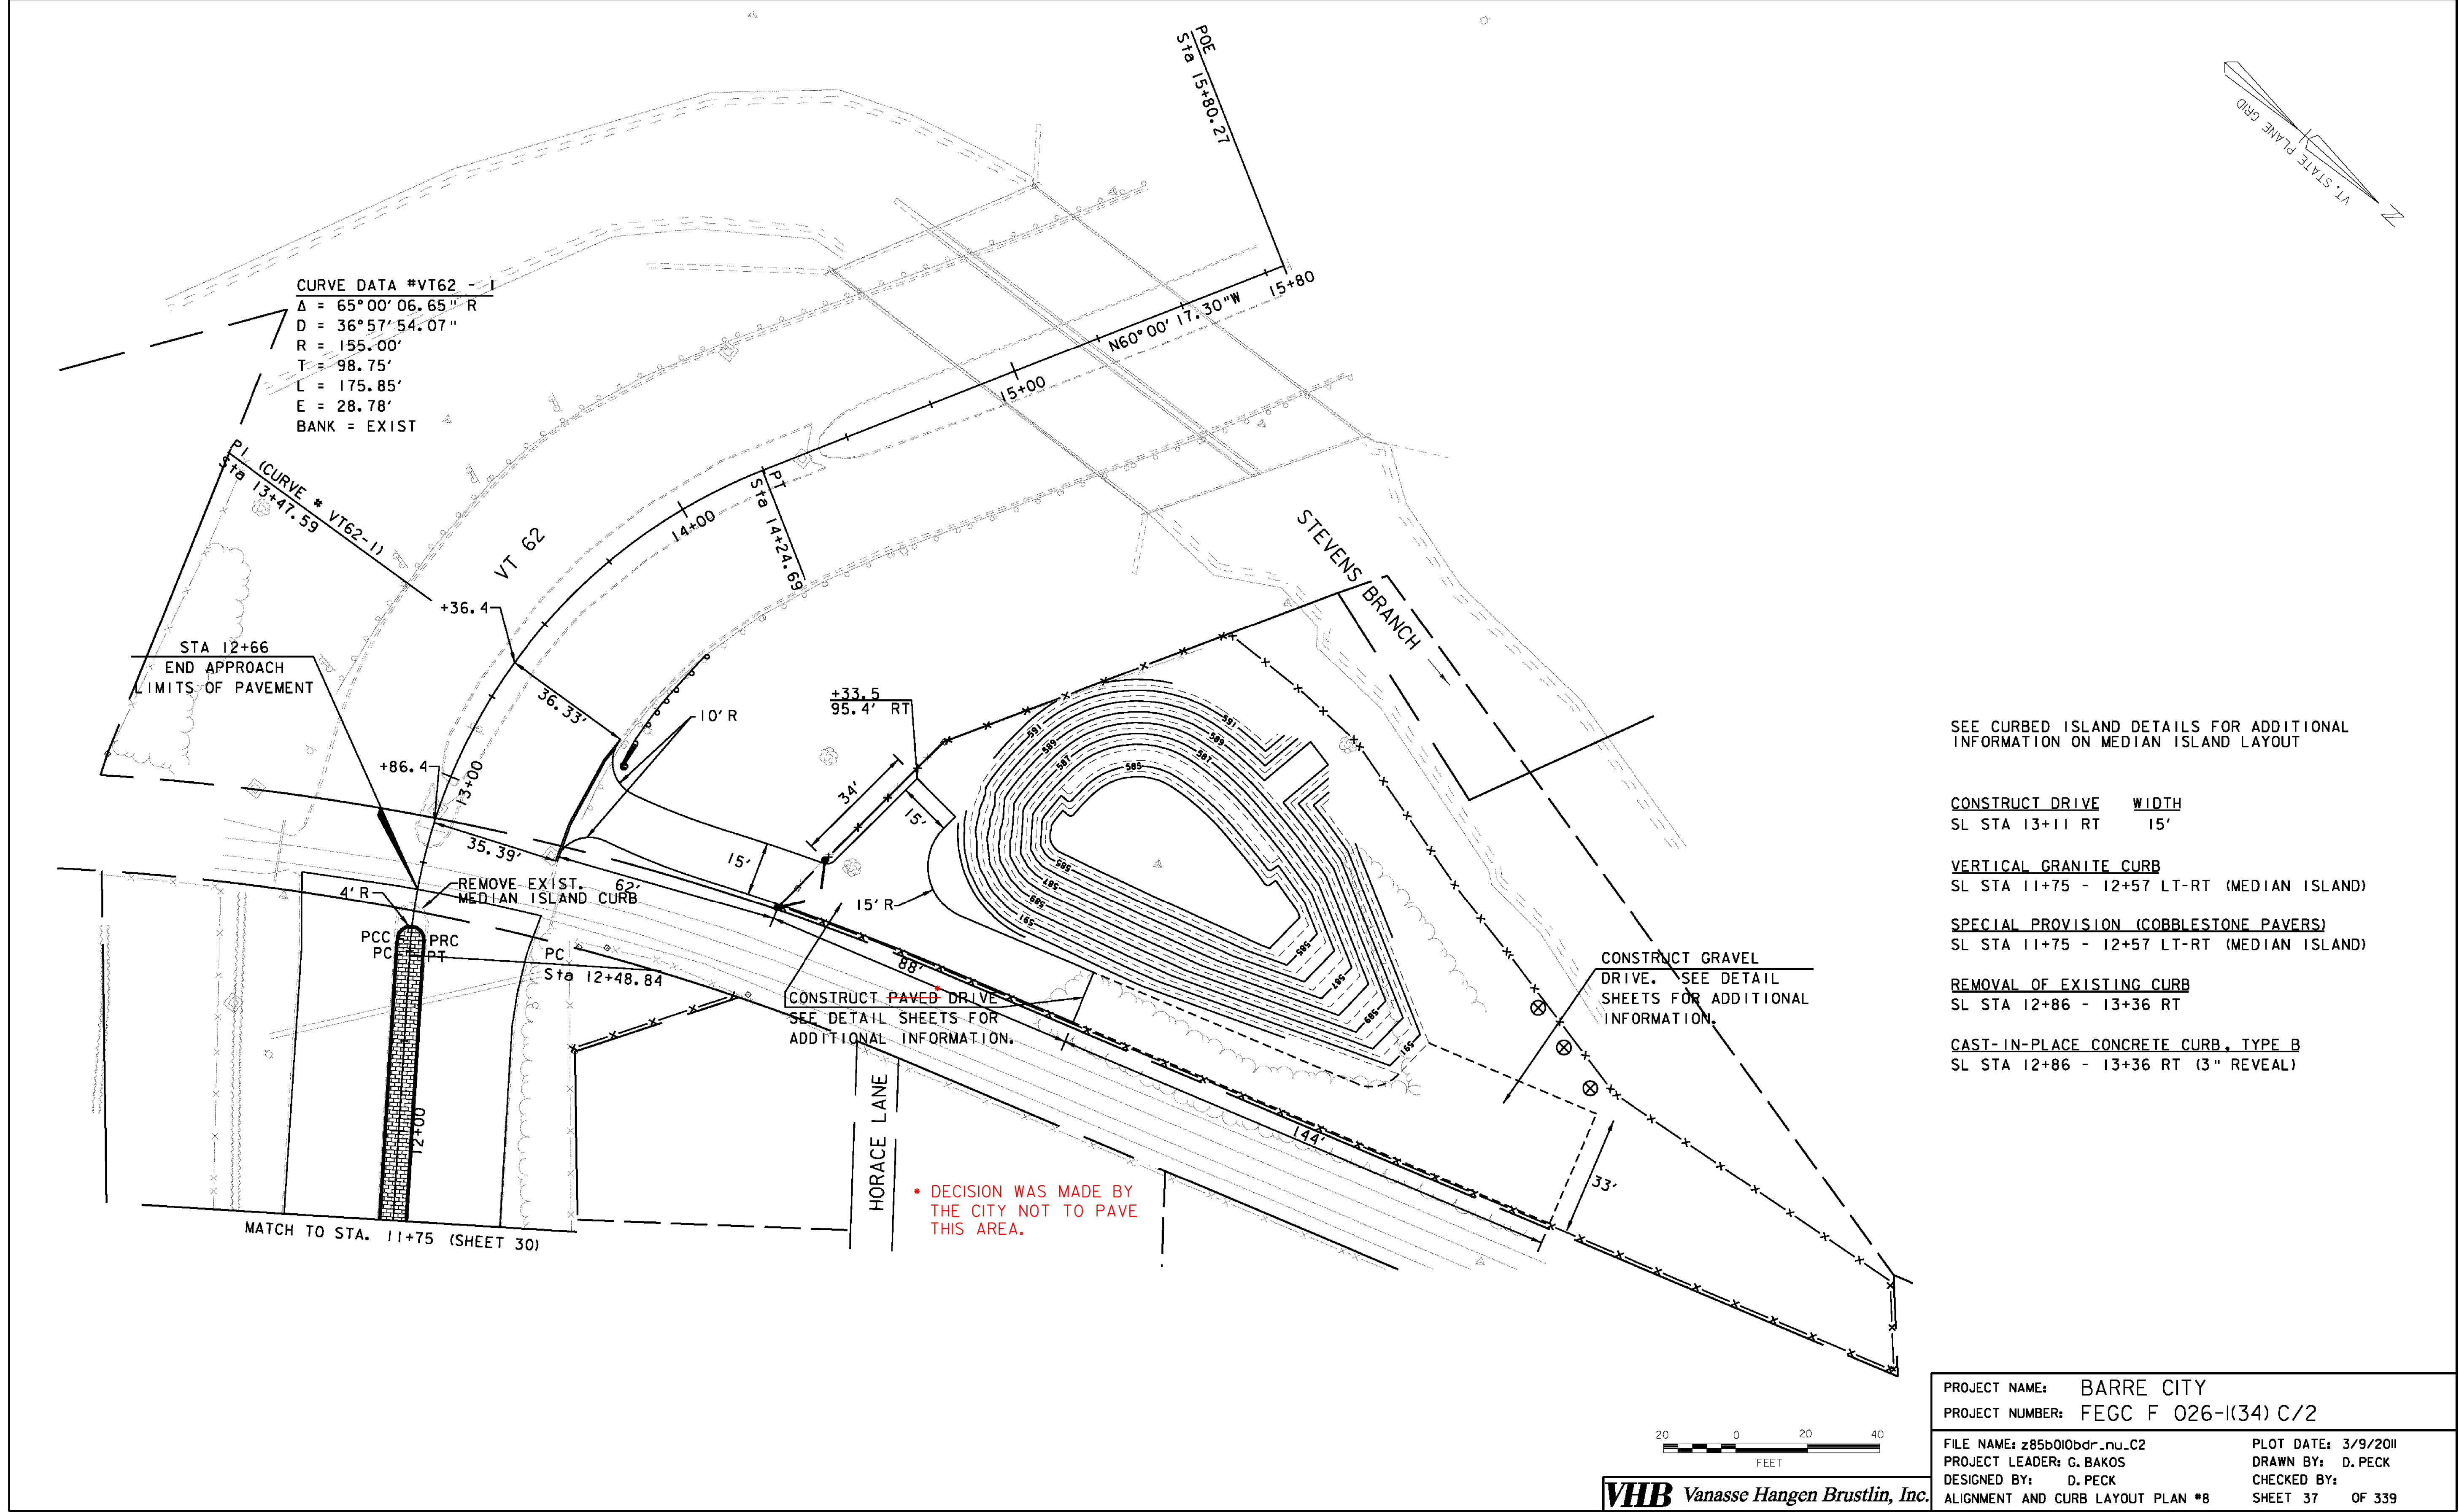

SEE CURBED ISLAND DETAILS FOR ADDITIONAL
INFORMATION ON MEDIAN ISLAND LAYOUT

CONSTRUCT DRIVE WIDTH
SL STA 13+11 RT 15'

VERTICAL GRANITE CURB
SL STA 11+75 - 12+57 LT-RT (MEDIAN ISLAND)

SPECIAL PROVISION (COBBLESTONE PAVERS)
SL STA 11+75 - 12+57 LT-RT (MEDIAN ISLAND)

REMOVAL OF EXISTING CURB
SL STA 12+86 - 13+36 RT

CAST-IN-PLACE CONCRETE CURB, TYPE B
SL STA 12+86 - 13+36 RT (3" REVEAL)

PROJECT NAME:	BARRE CITY	PLOT DATE:	3/9/2011
PROJECT NUMBER:	FEGC F 026-(134) C/2	DRAWN BY:	D. PECK
FILE NAME:	z85b010bdr_nu_C2	CHECKED BY:	
PROJECT LEADER:	G. BAKOS		
DESIGNED BY:	D. PECK		
ALIGNMENT AND CURB LAYOUT PLAN #8		SHEET 37	OF 339