



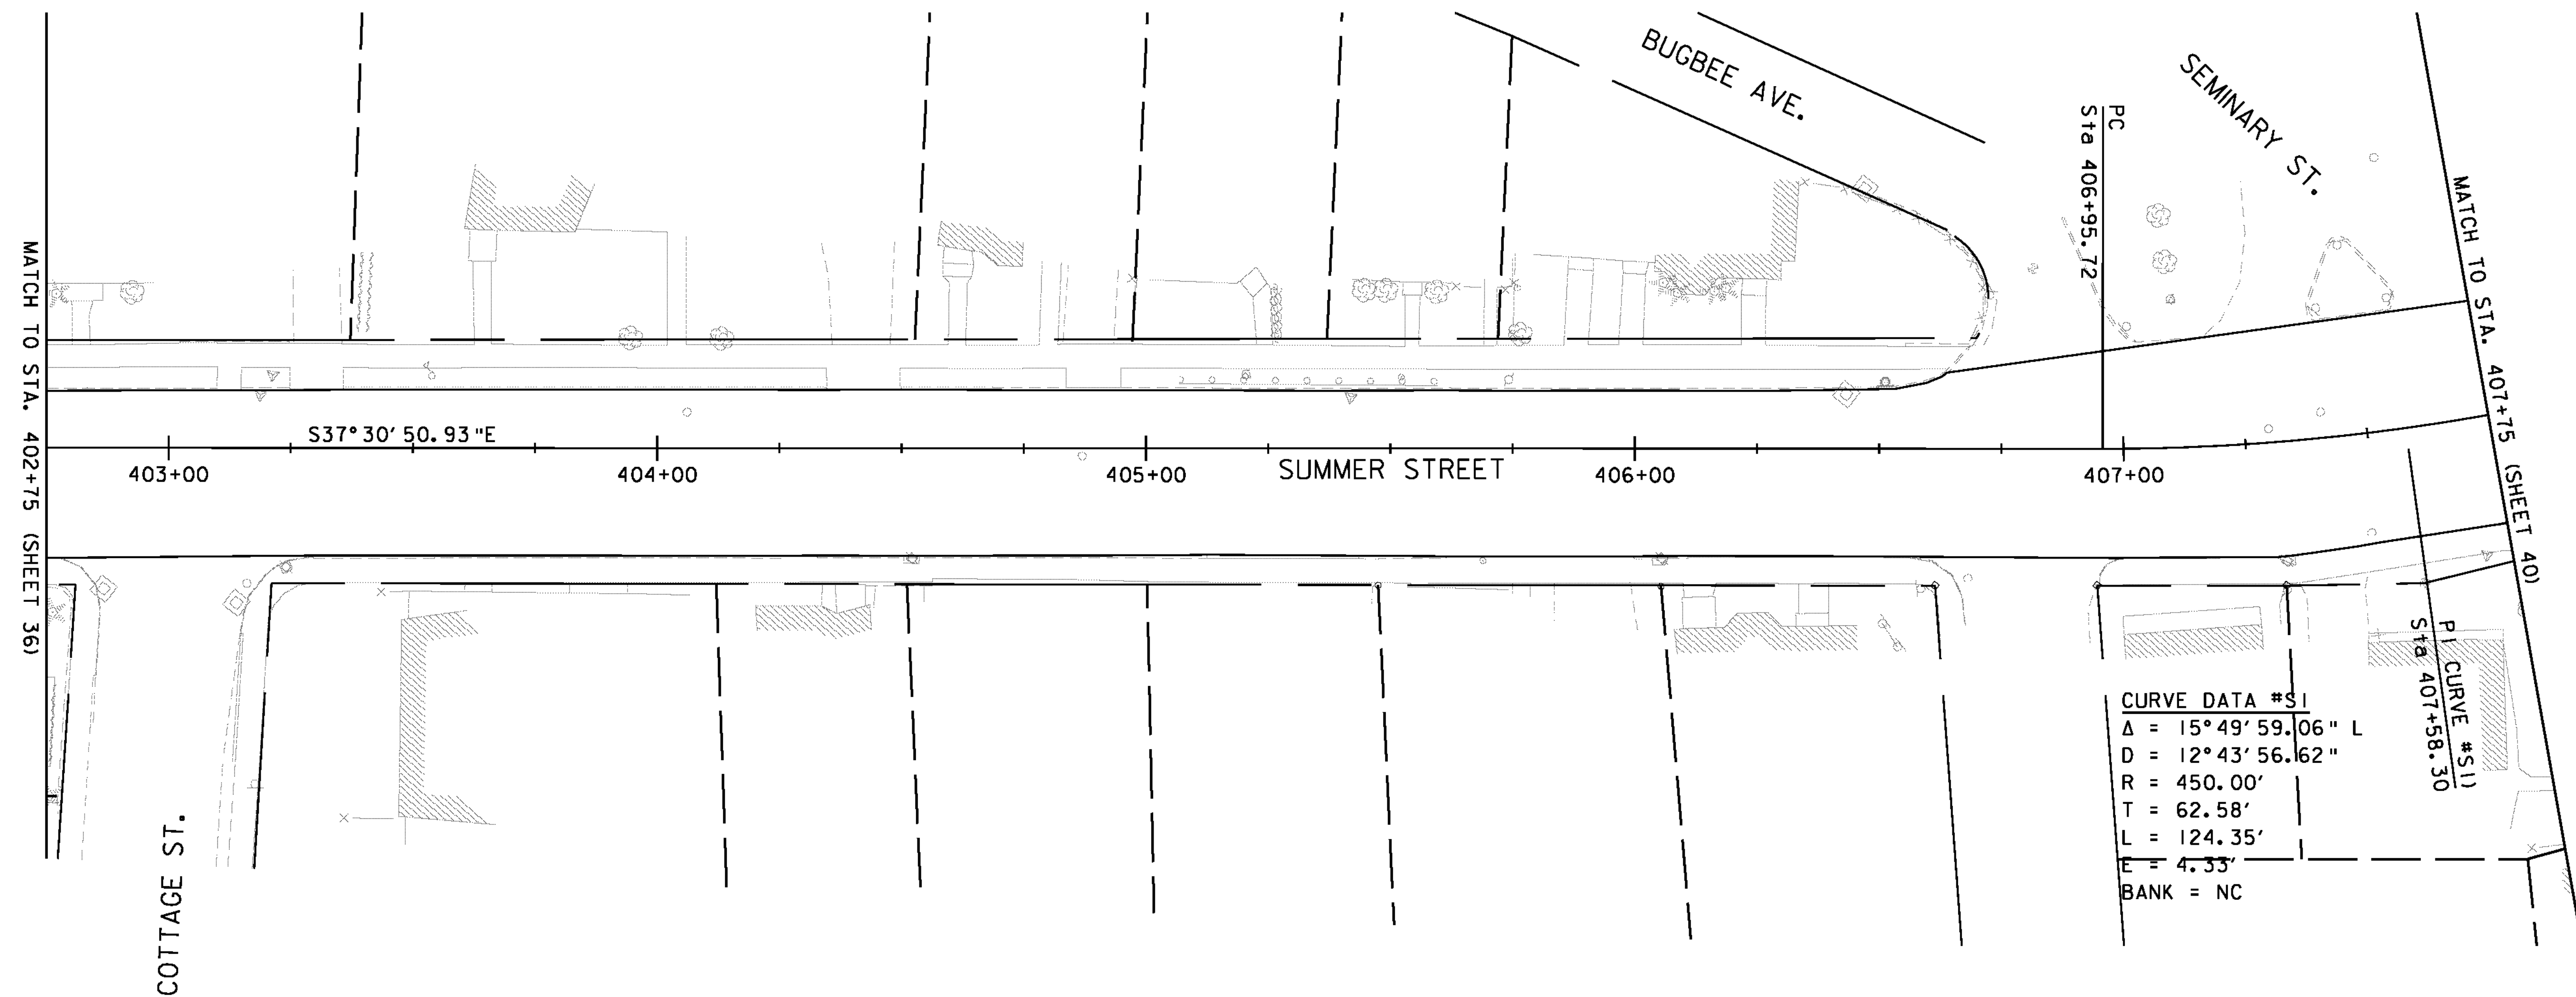

CURVE DATA #S1
Δ = 15° 49' 59.06" L
D = 12° 43' 56.62" L
R = 450.00'
T = 62.58'
L = 124.35'
E = 4.33'
BANK = NC

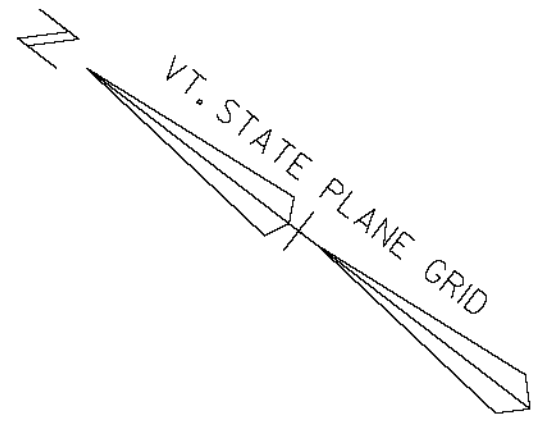

VHB Vanasse Hangen Brustlin, Inc.

PROJECT NAME: BARRE CITY	
PROJECT NUMBER: FECC F 026-I(34) C/2	
FILE NAME: z85b010bdr_nu_C2	PLOT DATE: 3/9/2011
PROJECT LEADER: G. BAKOS	DRAWN BY: D. PECK
DESIGNED BY: D. PECK	CHECKED BY:
ALIGNMENT AND CURB LAYOUT PLAN #10	SHEET 39 OF 339