



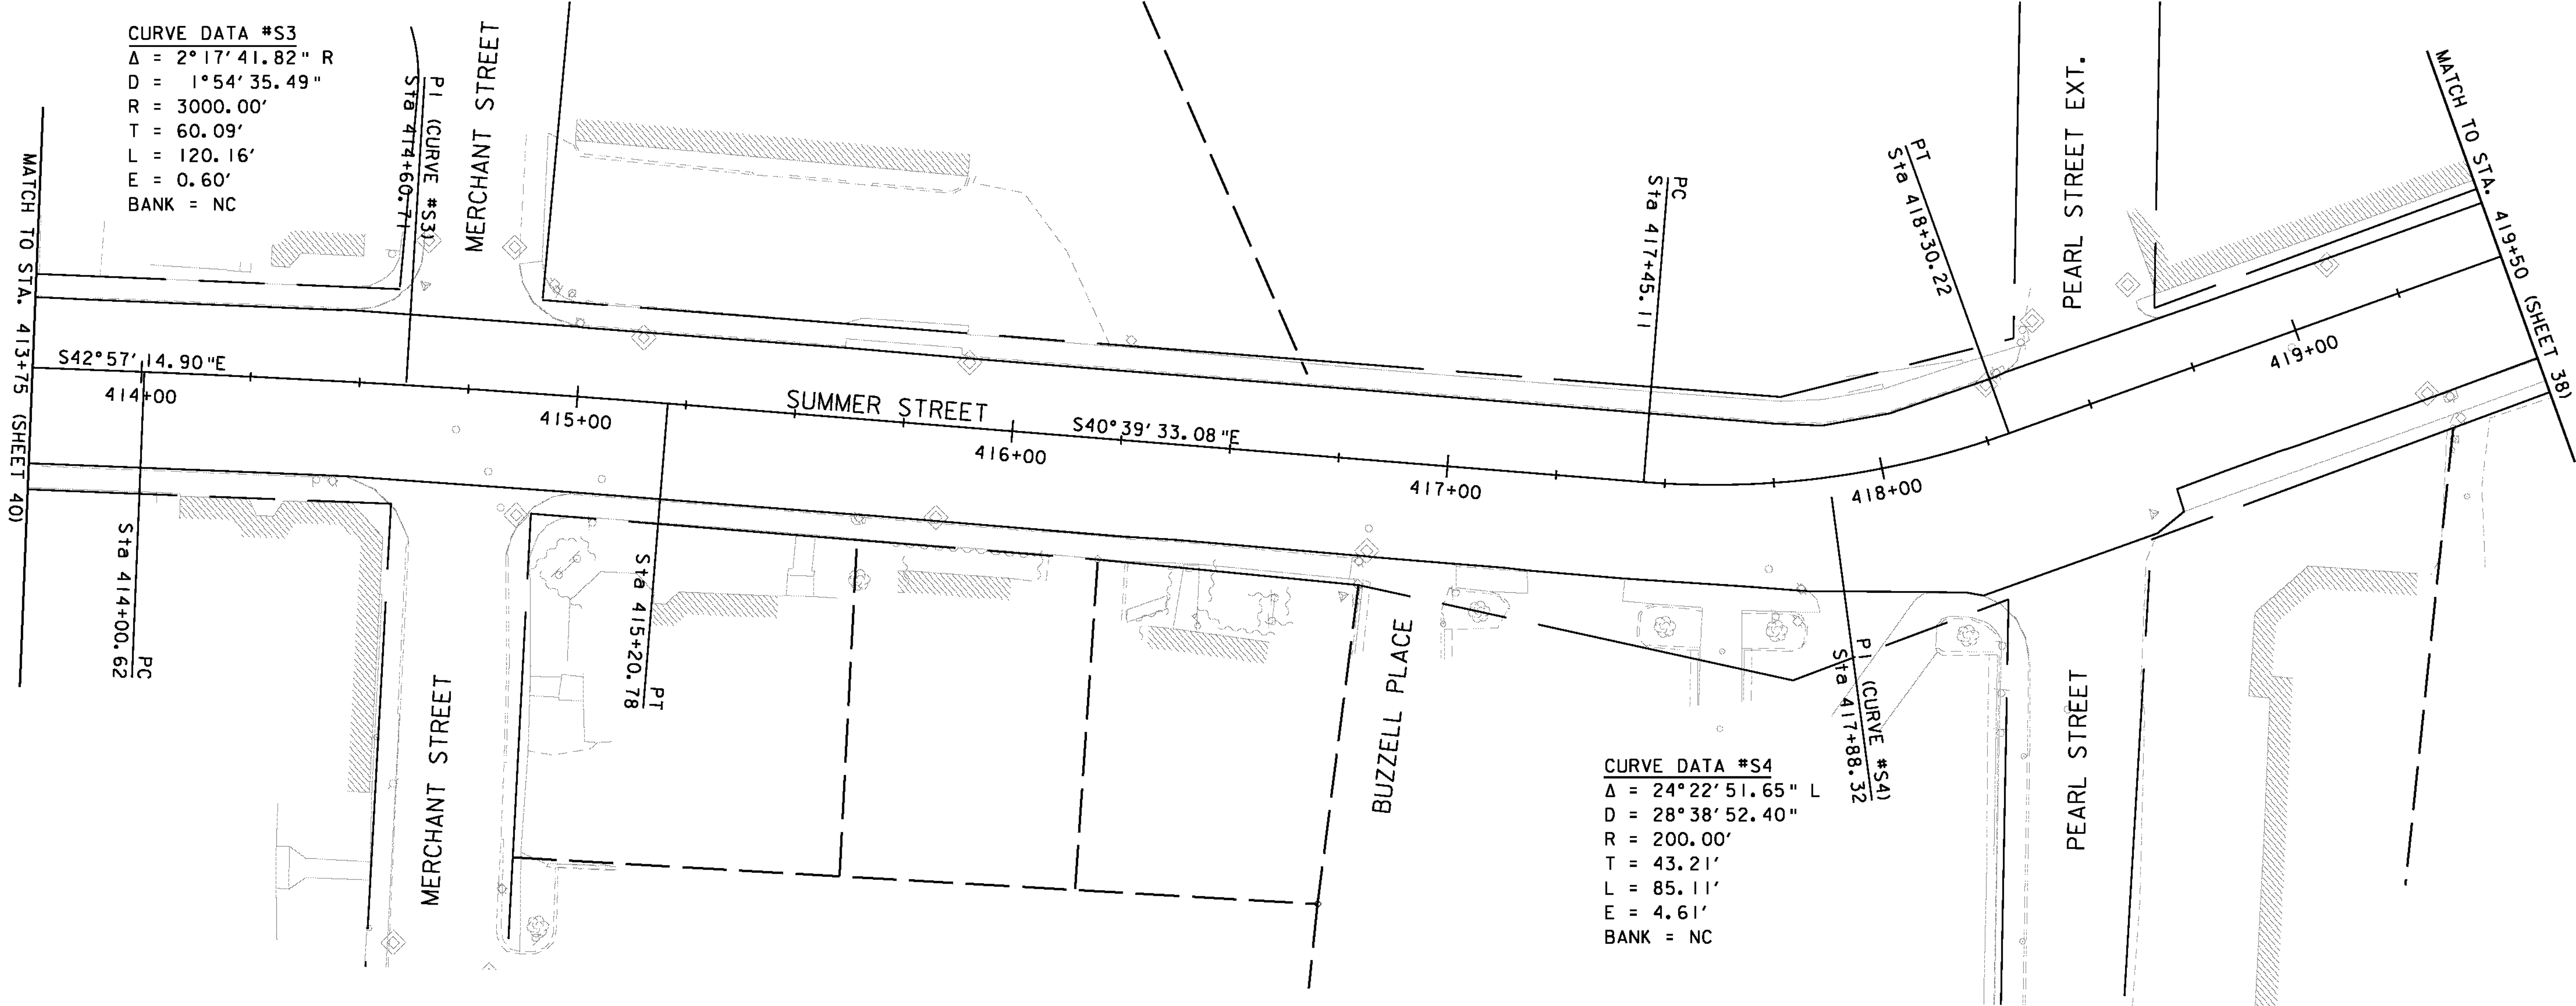

CURVE DATA #S3
Δ = 2°17'41.82" R
D = 1°54'35.49"
R = 3000.00'
T = 60.09'
L = 120.16'
E = 0.60'
BANK = NC

CURVE DATA #S4
Δ = 24°22'51.65" L
D = 28°38'52.40"
R = 200.00'
T = 43.21'
L = 85.11'
E = 4.61'
BANK = NC

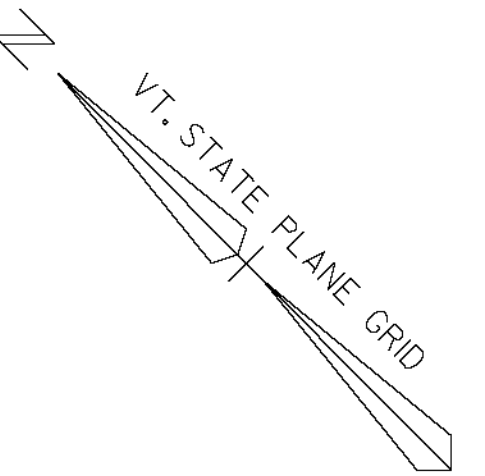

VHB Vanasse Hangen Brustlin, Inc.

PROJECT NAME: BARRE CITY	
PROJECT NUMBER: FECC F 026-I(34) C/2	
FILE NAME: z85b010bdr_nu.C2	PLOT DATE: 3/9/2011
PROJECT LEADER: G. BAKOS	DRAWN BY: D. PECK
DESIGNED BY: D. PECK	CHECKED BY:
ALIGNMENT AND CURB LAYOUT PLAN #12	SHEET 41 OF 339