


• AREA NOT RECONSTRUCTED/REPAVED DUE TO EXISTING (NUMEROUS) MONITORING WELLS.

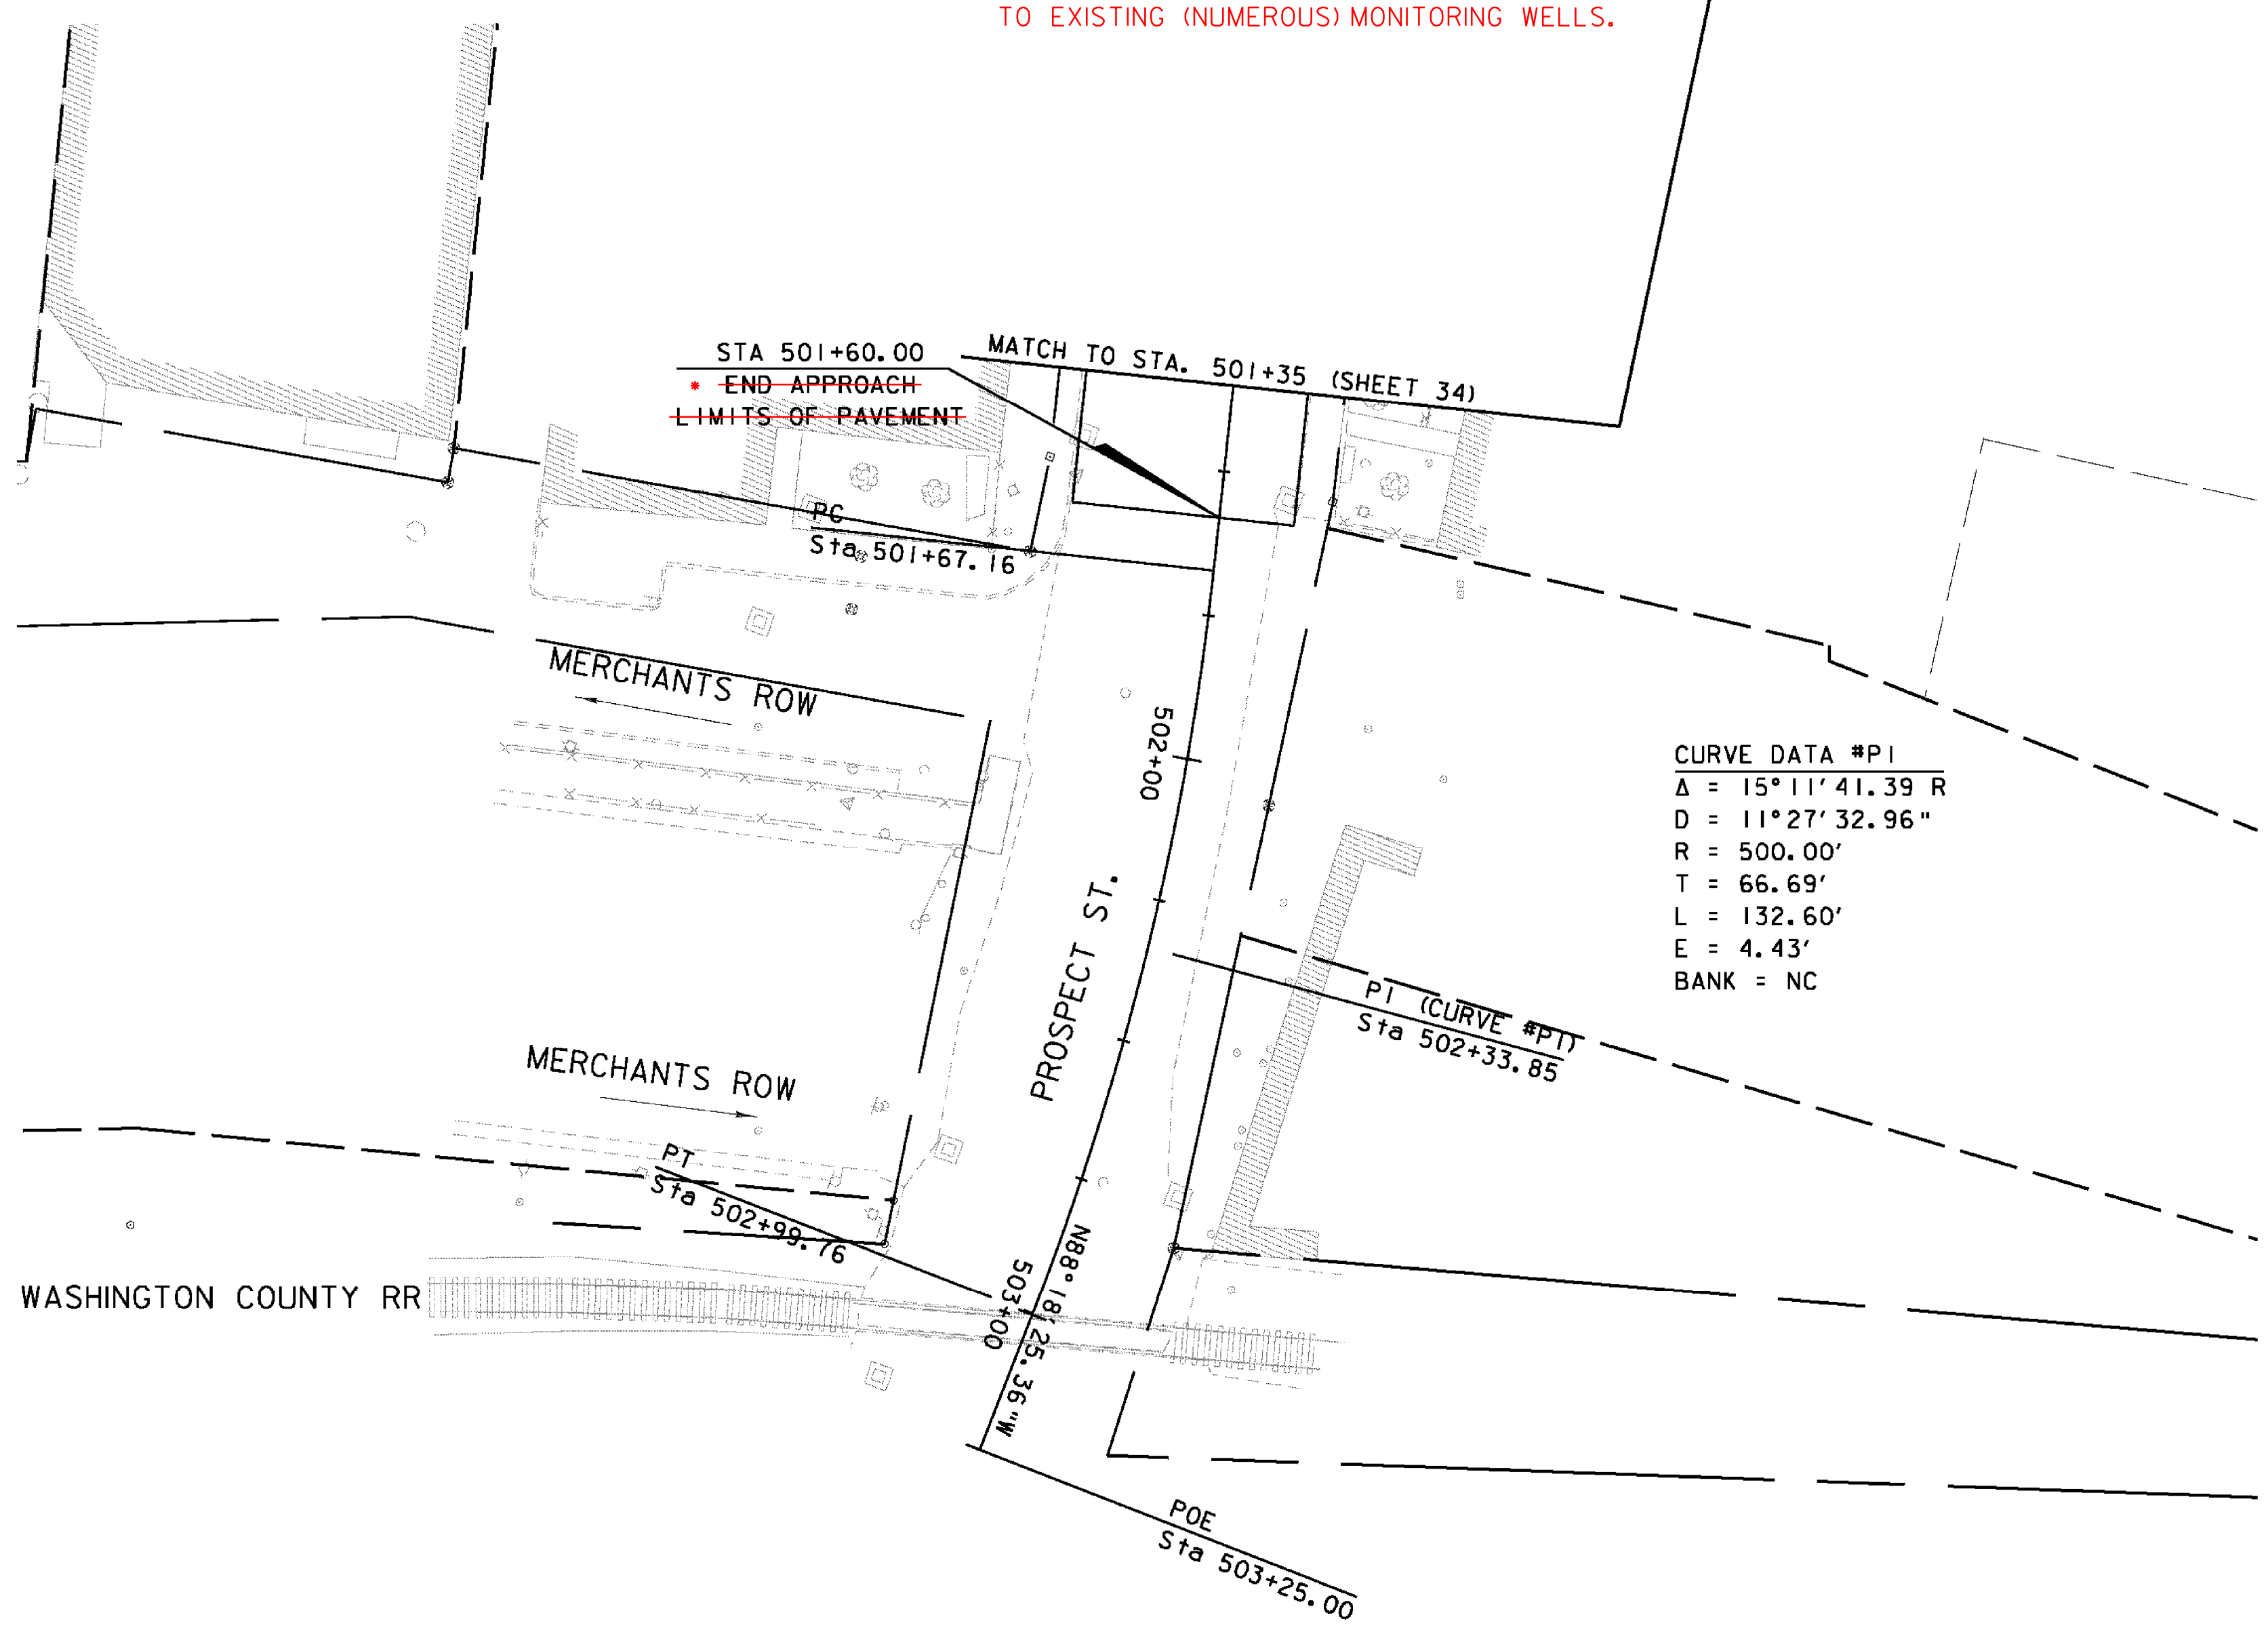

CURVE DATA #P1	
Δ	= 15° 11' 41.39 R
D	= 11° 27' 32.96 "
R	= 500.00'
T	= 66.69'
L	= 132.60'
E	= 4.43'
BANK	= NC



VHB Vanasse Hangen Brustlin, Inc.

PROJECT NAME:	BARRE CITY	PLOT DATE:	3/9/2011
PROJECT NUMBER:	FEGC F 026-(134) C/2	DRAWN BY:	D. PECK
FILE NAME:	z85b010bdr_nu_C2	CHECKED BY:	
PROJECT LEADER:	G. BAKOS	ALIGNMENT AND CURB LAYOUT PLAN #14	SHEET 43 OF 339
DESIGNED BY:	D. PECK		