


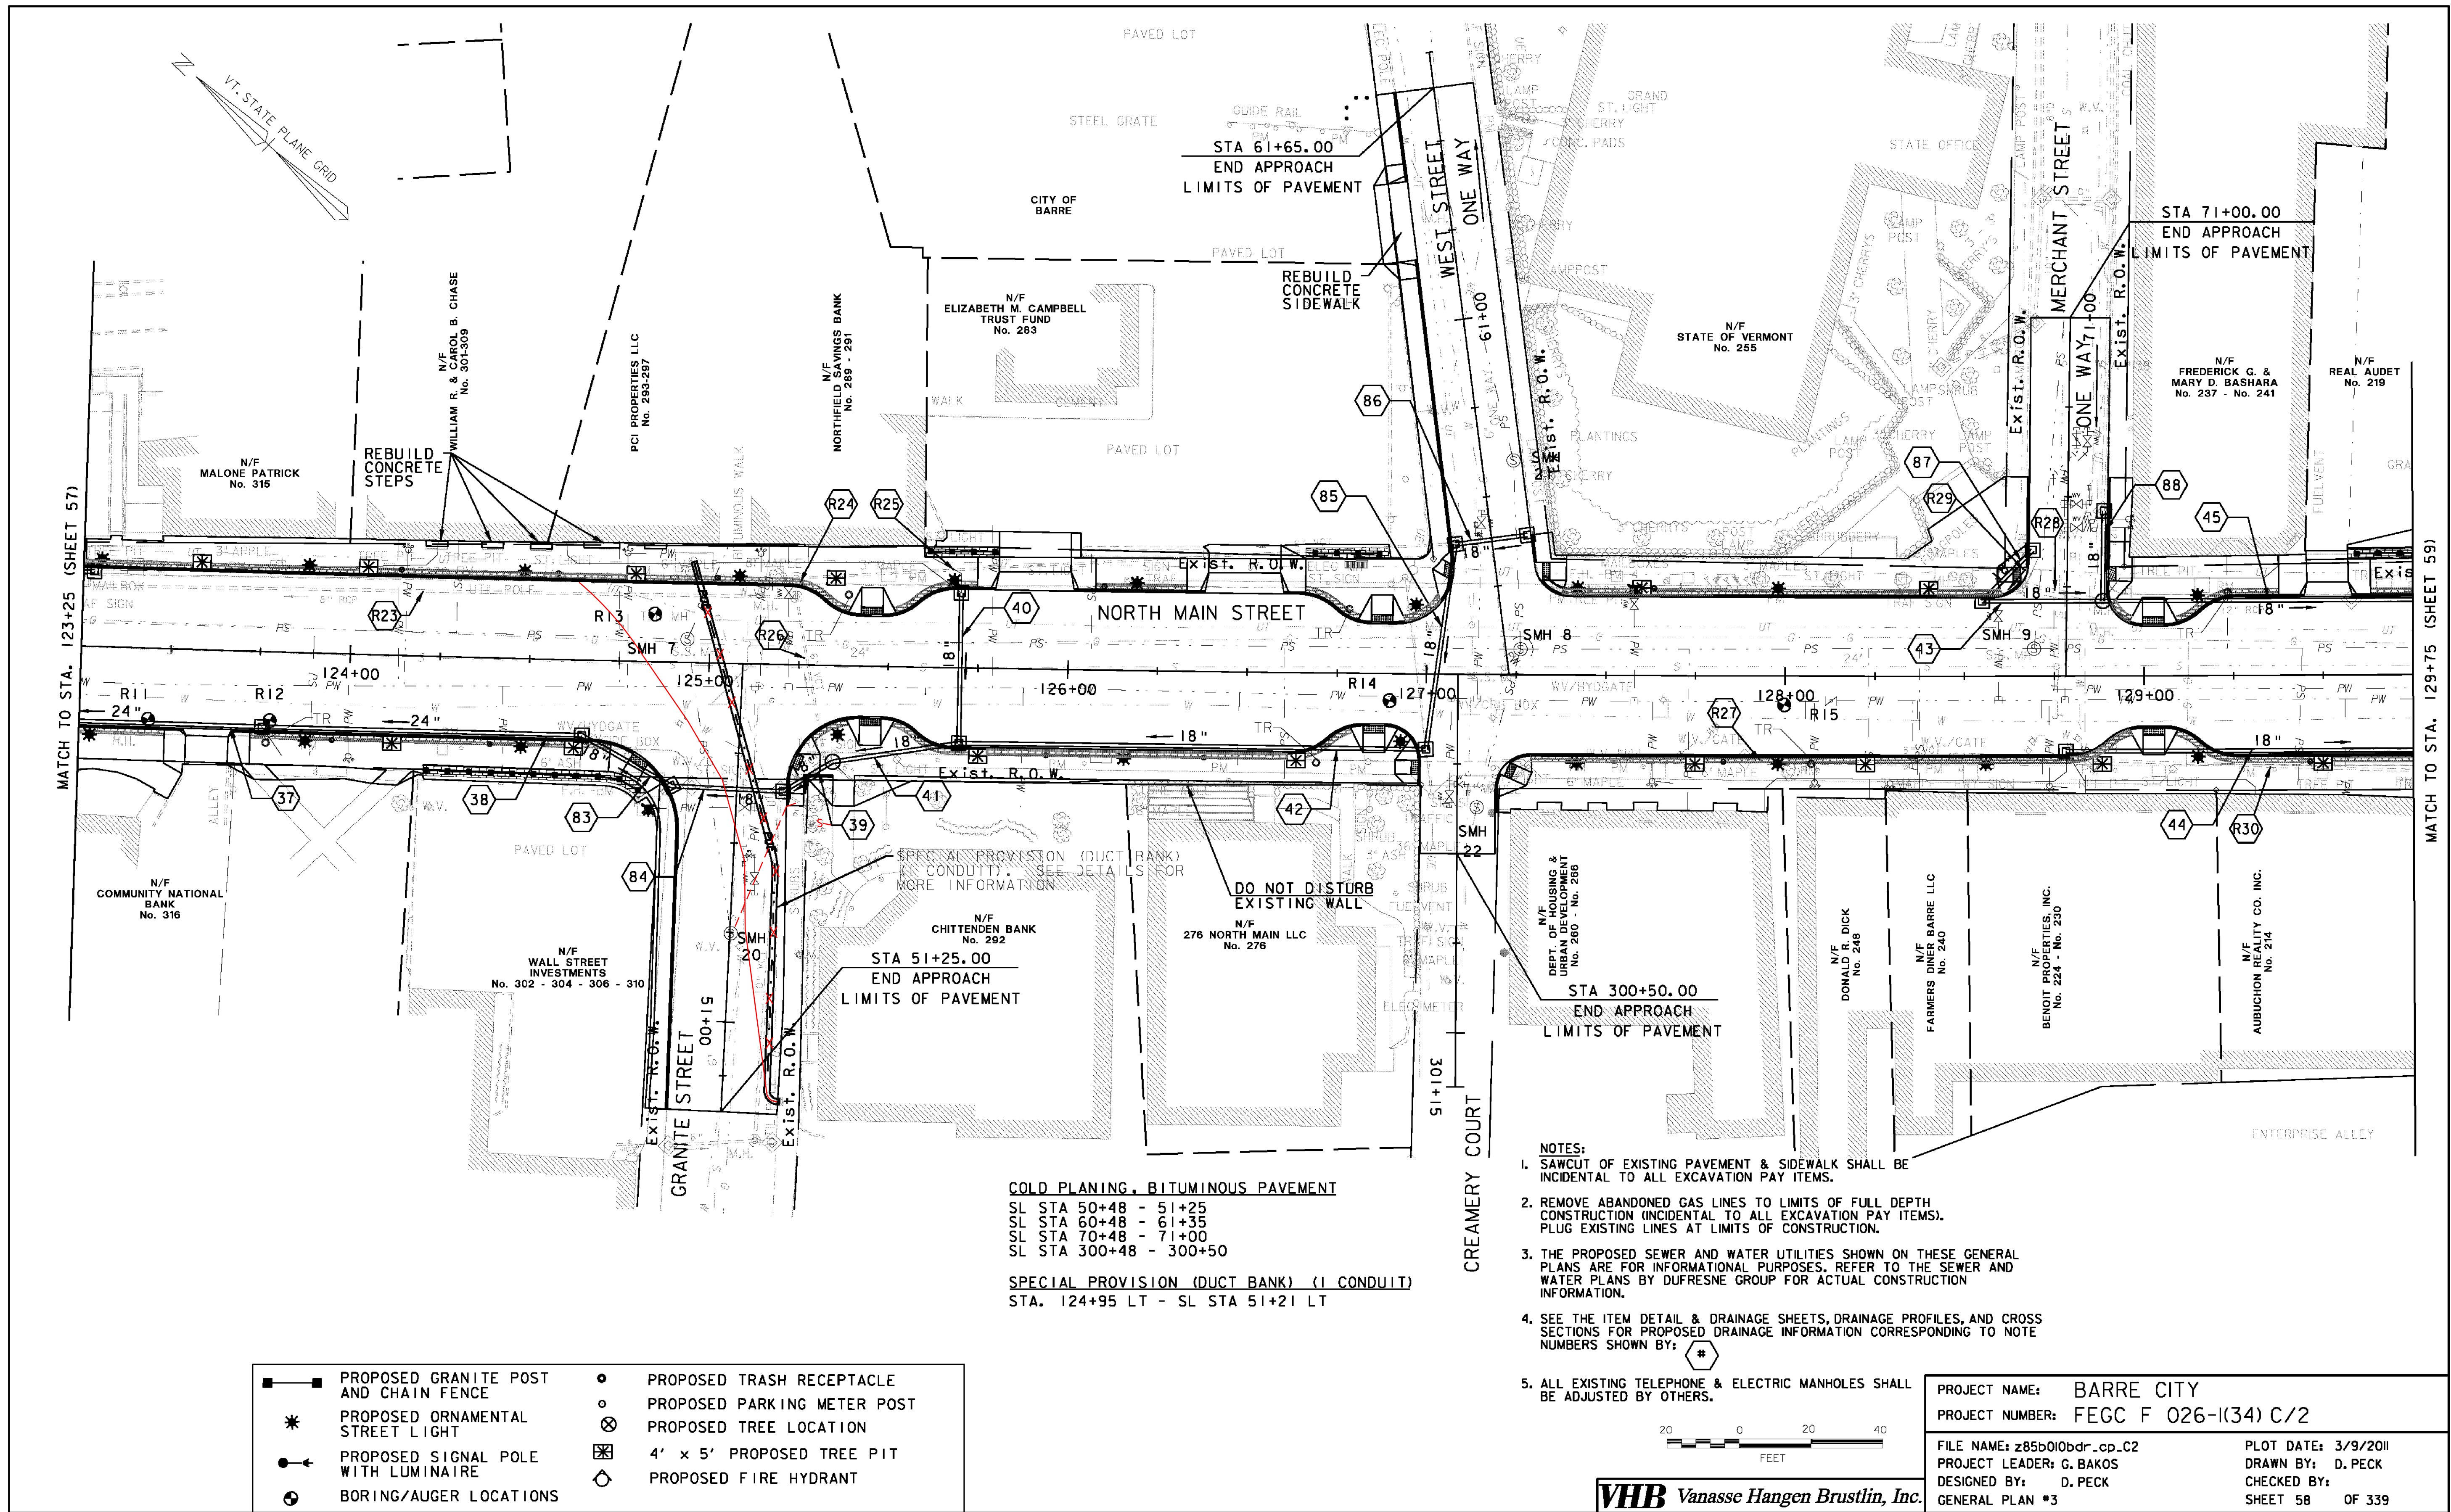

MATCH TO STA. 123+25 (SHEET 57)

MATCH TO STA. 129+75 (SHEET 59)

COLD PLANING, BITUMINOUS PAVEMENT

- SL STA 50+48 - 51+25
- SL STA 60+48 - 61+35
- SL STA 70+48 - 71+00
- SL STA 300+48 - 300+50

SPECIAL PROVISION (DUCT BANK) (1 CONDUIT)
STA. 124+95 LT - SL STA 51+21 LT

- NOTES:
1. SAWCUT OF EXISTING PAVEMENT & SIDEWALK SHALL BE INCIDENTAL TO ALL EXCAVATION PAY ITEMS.
 2. REMOVE ABANDONED GAS LINES TO LIMITS OF FULL DEPTH CONSTRUCTION (INCIDENTAL TO ALL EXCAVATION PAY ITEMS). PLUG EXISTING LINES AT LIMITS OF CONSTRUCTION.
 3. THE PROPOSED SEWER AND WATER UTILITIES SHOWN ON THESE GENERAL PLANS ARE FOR INFORMATIONAL PURPOSES. REFER TO THE SEWER AND WATER PLANS BY DUFRESNE GROUP FOR ACTUAL CONSTRUCTION INFORMATION.
 4. SEE THE ITEM DETAIL & DRAINAGE SHEETS, DRAINAGE PROFILES, AND CROSS SECTIONS FOR PROPOSED DRAINAGE INFORMATION CORRESPONDING TO NOTE NUMBERS SHOWN BY: #
 5. ALL EXISTING TELEPHONE & ELECTRIC MANHOLES SHALL BE ADJUSTED BY OTHERS.



■ PROPOSED GRANITE POST AND CHAIN FENCE	○ PROPOSED TRASH RECEPTACLE
* PROPOSED ORNAMENTAL STREET LIGHT	⊗ PROPOSED PARKING METER POST
● PROPOSED SIGNAL POLE WITH LUMINAIRE	⊠ 4' x 5' PROPOSED TREE PIT
⊙ BORING/AUGER LOCATIONS	⊕ PROPOSED FIRE HYDRANT

VHB Vanasse Hangen Brustlin, Inc.

PROJECT NAME: BARRE CITY	PLOT DATE: 3/9/2011
PROJECT NUMBER: FECC F 026-(K34) C/2	DRAWN BY: D. PECK
FILE NAME: z85b010bdr_cp_c2	CHECKED BY:
PROJECT LEADER: G. BAKOS	SHEET 58 OF 339
DESIGNED BY: D. PECK	
GENERAL PLAN #3	