



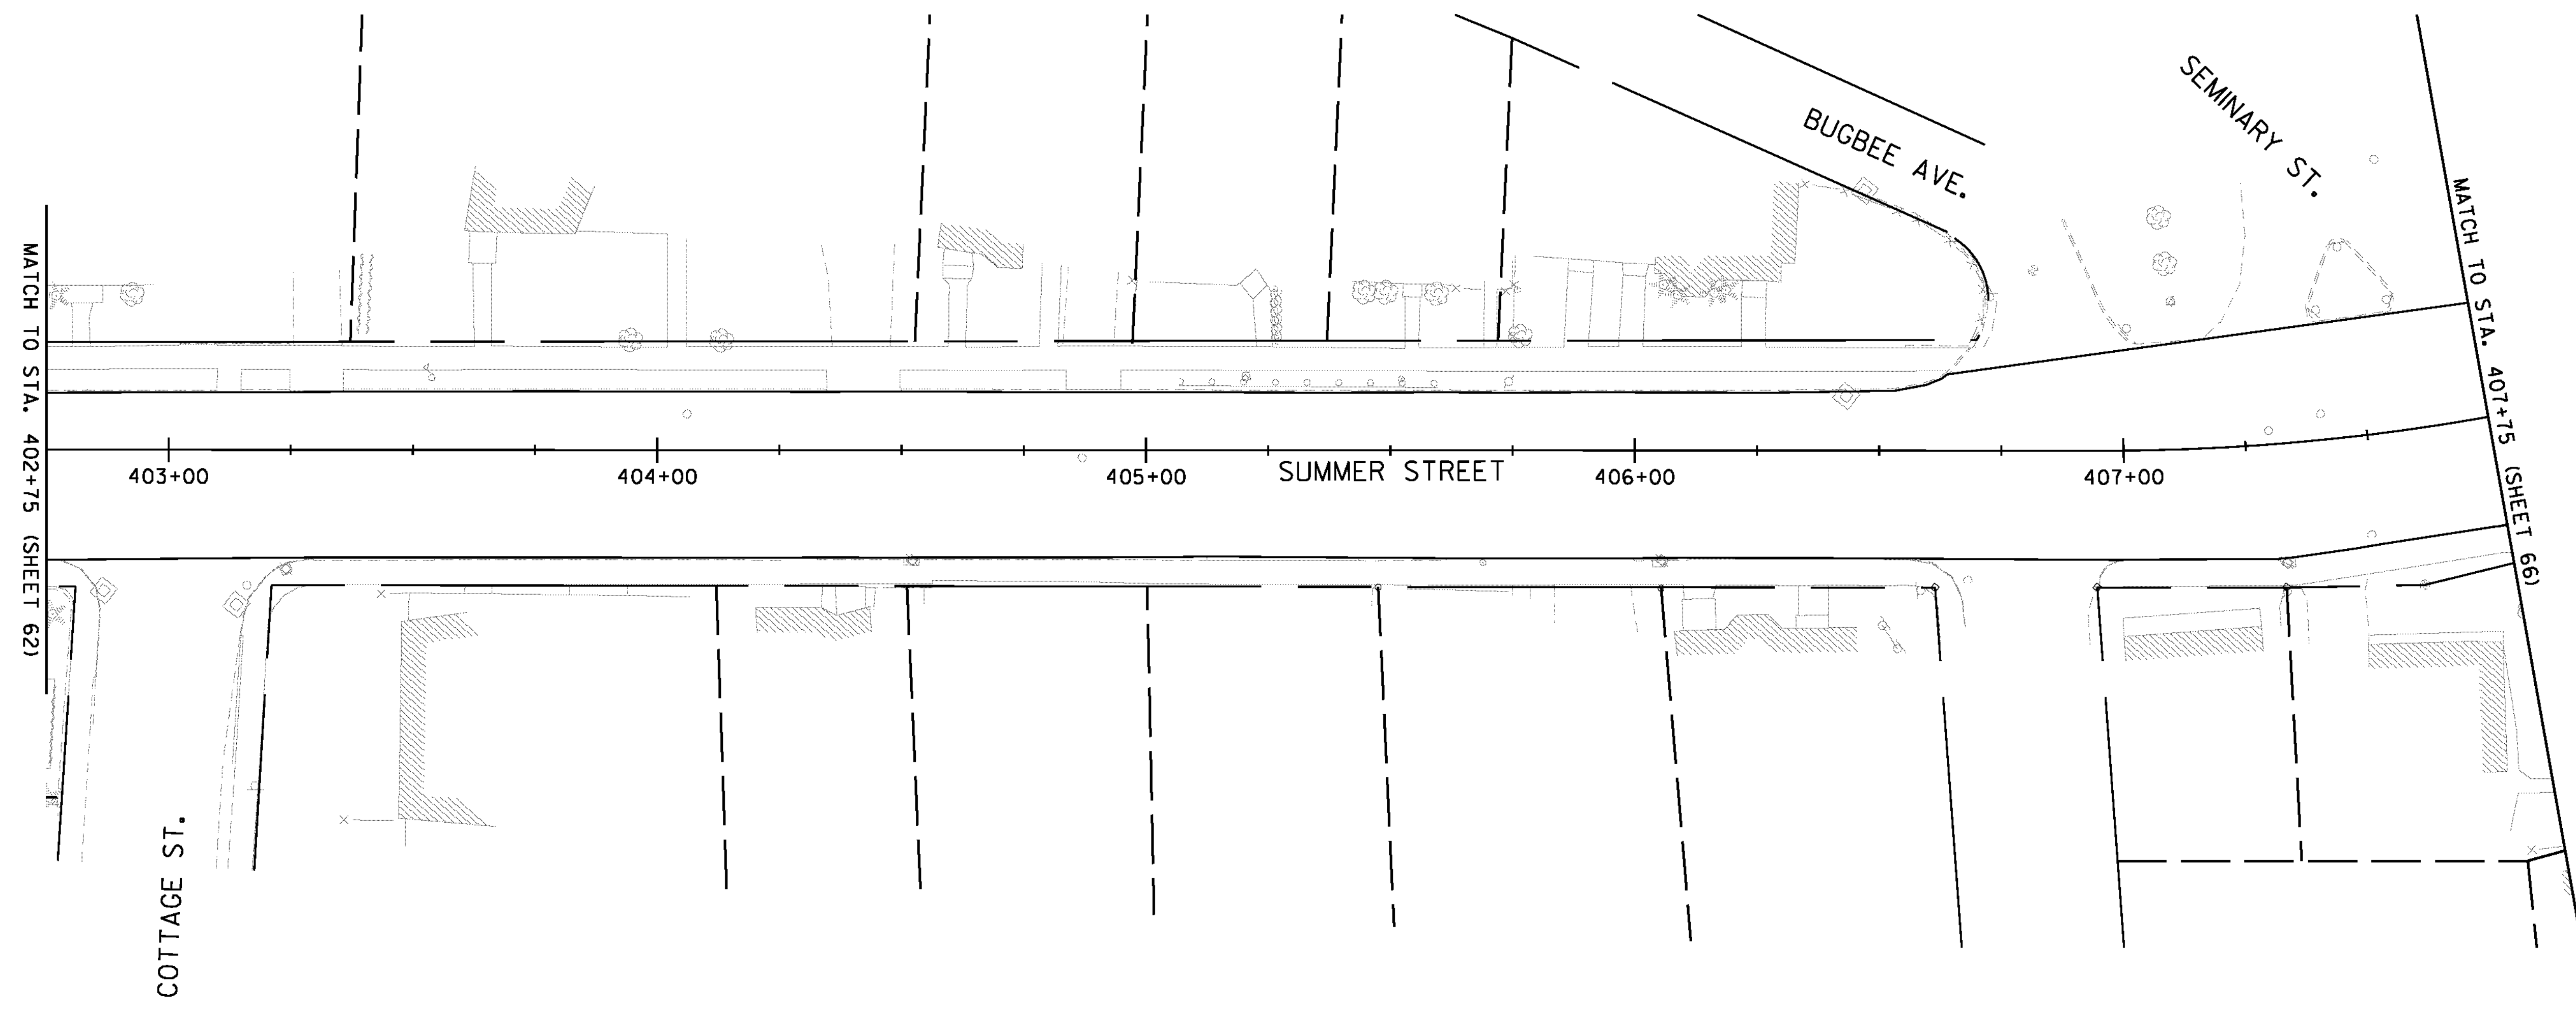

COLD PLANING, BITUMINOUS PAVEMENT
SL STA 402+75 - 407+75

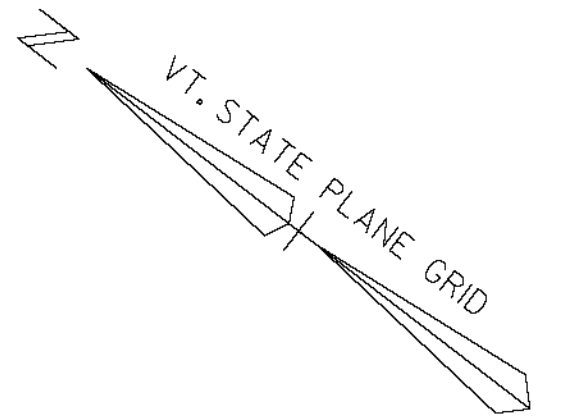

VHB Vanasse Hangen Brustlin, Inc.

PROJECT NAME: BARRE CITY	
PROJECT NUMBER: FECC F 026-I(34) C/2	
FILE NAME: z85b010bdr_cp_C2	PLOT DATE: 3/9/2011
PROJECT LEADER: G. BAKOS	DRAWN BY: D. PECK
DESIGNED BY: D. PECK	CHECKED BY:
GENERAL PLAN #10	SHEET 65 OF 339