



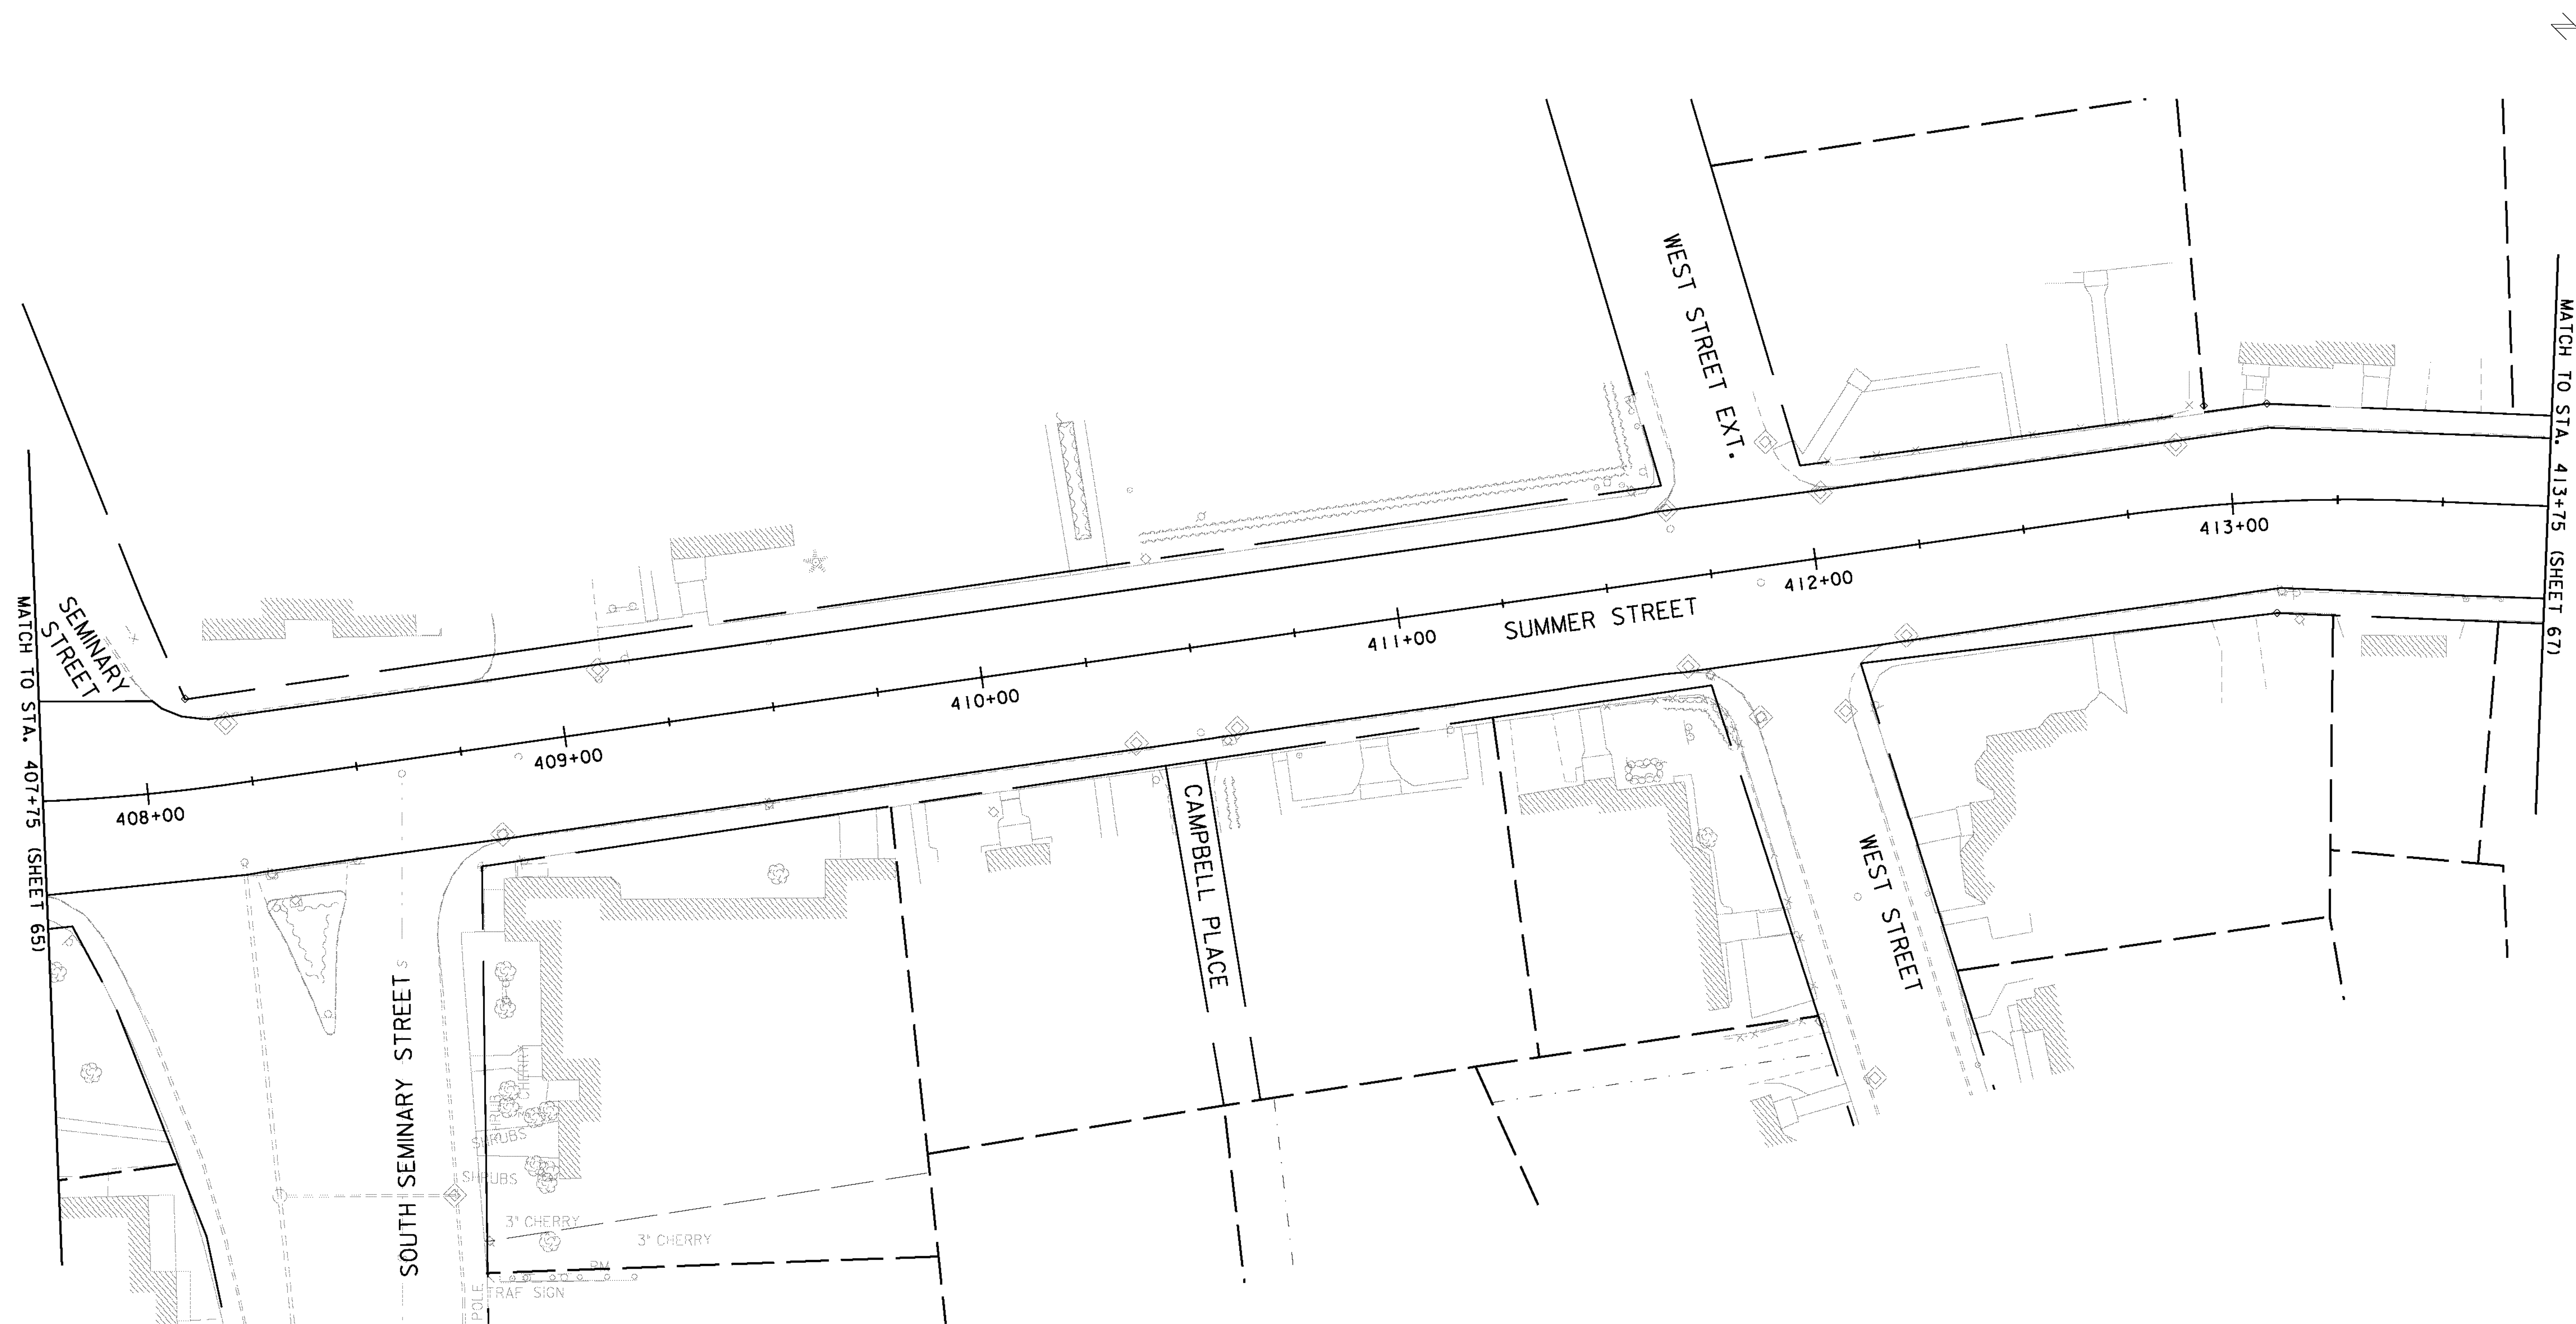

ADJUST ELEVATION OF VALVE BOX
SL STA 409+52, LT

COLD PLANING, BITUMINOUS PAVEMENT
SL STA 407+75 - 413+75

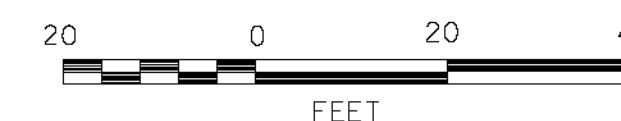

VHB Vanasse Hangen Brustlin, Inc.

PROJECT NAME: BARRE CITY
PROJECT NUMBER: FECC F 026-I(34) C/2

FILE NAME: z85b010bdr_cp_C2
PROJECT LEADER: G. BAKOS
DESIGNED BY: D. PECK
GENERAL PLAN #II

PLOT DATE: 3/9/2011
DRAWN BY: D. PECK
CHECKED BY:
SHEET 66 OF 339