

- —

■

PROPOSED GRANITE POST
AND CHAIN FENCE
- *
- PROPOSED ORNAMENTAL
STREET LIGHT

●

→

PROPOSED SIGNAL POLE
WITH LUMINAIRE

⊙

BORING/AUGER LOCATIONS

●

PROPOSED TRASH RECEPTACLE

○

PROPOSED PARKING METER POST

⊗



PROPOSED TREE LOCATION

⊠

4' x 5' PROPOSED TREE PIT

⊙

PROPOSED FIRE HYDRANT

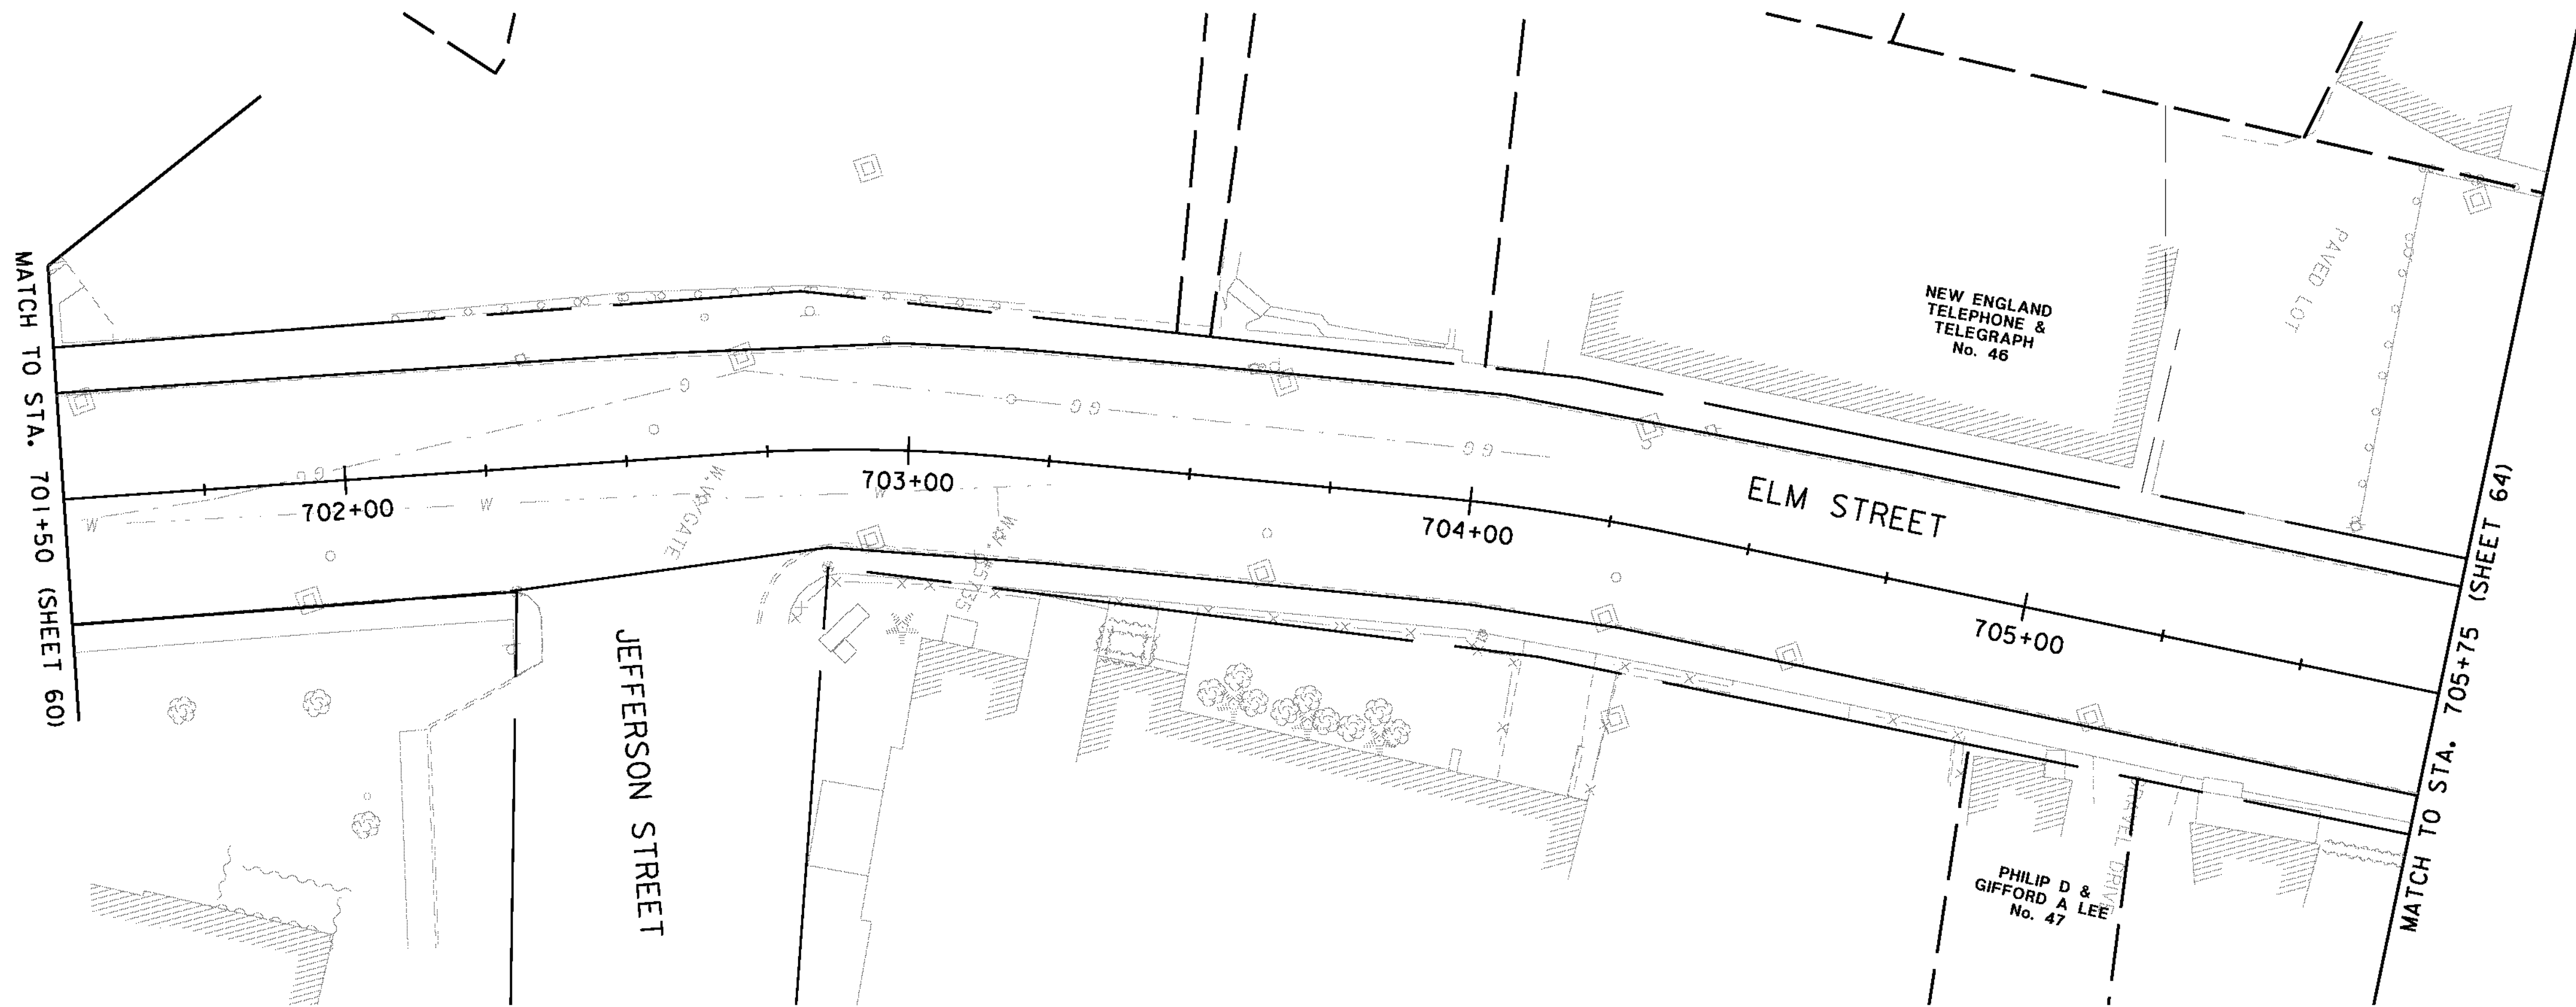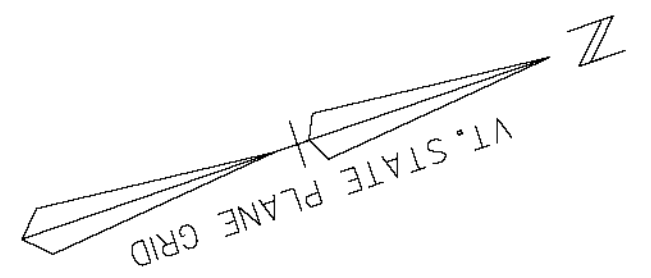

ADJUST ELEVATION OF VALVE BOX
SL STA 702+63, RT
SL STA 703+17, RT

COLD PLANING & BITUMINOUS PAVEMENT
SL STA 701+50 - 705+75



VHB Vanasse Hangen Brustlin, Inc.

PROJECT NAME: BARRE CITY	
PROJECT NUMBER: FECC F 026-(K34) C/2	
FILE NAME: z85b010bdr_cp_C2	PLOT DATE: 3/9/2011
PROJECT LEADER: G. BAKOS	DRAWN BY: D. PECK
DESIGNED BY: D. PECK	CHECKED BY:
GENERAL PLAN #13	SHEET 68 OF 339