


NOTE:
 THE ELEVATIONS SHOWN TO THE NEAREST TENTH ARE THE OLD GROUND ALONG CENTERLINE. THE ELEVATIONS SHOWN TO THE NEAREST HUNDREDTH ARE THE PROPOSED GRADE ALONG CENTERLINE.

DATUM	
VERTICAL	NAVD 1929
HORIZONTAL	NAD 27

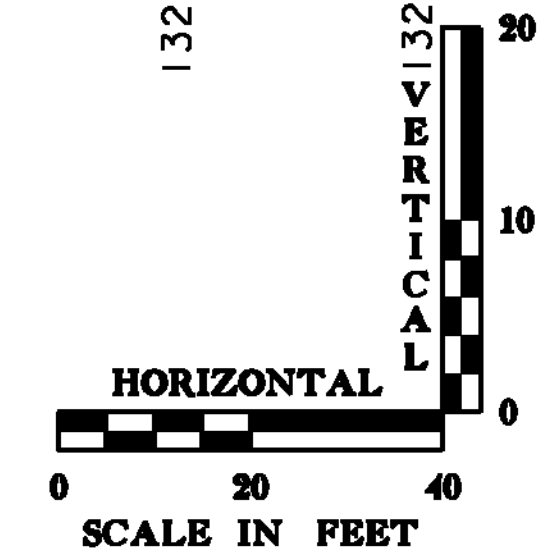

VHB Vanasse Hangen Brustlin, Inc.

PROJECT NAME:	BARRE CITY	FILE NAME:	85b010_PRO2.C2	PLOT DATE:	3/9/2011
PROJECT NUMBER:	FEGC F 026-(134) C/2	DESIGNED BY:	DMP / MDS	DRAWN BY:	DMP / JAR
		PROJECT LEADER:	G. BAKOS	CHECKED BY:	
		PROFILE - NORTH MAIN STREET		SHEET 70	OF 339