


NOTE:
THE ELEVATIONS SHOWN TO THE NEAREST TENTH ARE THE OLD GROUND ALONG CENTERLINE. THE ELEVATIONS SHOWN TO THE NEAREST HUNDREDTH ARE THE PROPOSED GROUND ALONG CENTERLINE.

DATUM
VERTICAL NAVD 1929
HORIZONTAL NAD 27

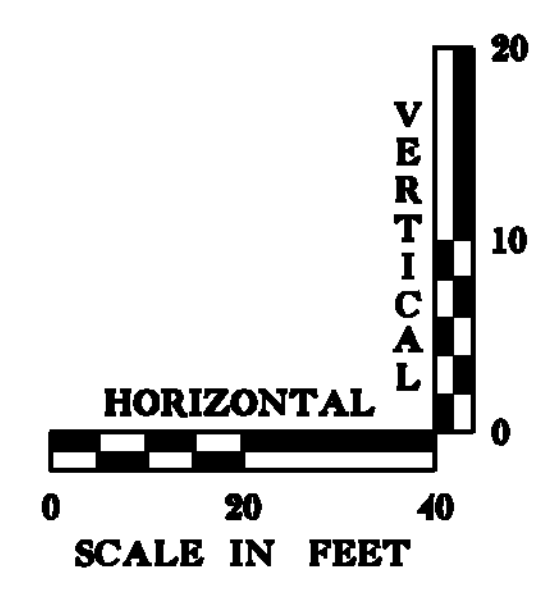

PROJECT NAME: BARRE CITY	PROJECT NUMBER: FECC F 026-I(34) C/2
FILE NAME: 85b010_PRO4_C2	PLOT DATE: 3/9/2011
PROJECT LEADER: G. BAKOS	DRAWN BY: DMP / JAR
DESIGNED BY: DMP / MDS	CHECKED BY:
PROFILE - MAPLE AVENUE	SHEET 72 OF 339

VHB Vanasse Hangen Brustlin, Inc.