


NOTE:

THE ELEVATIONS SHOWN TO THE NEAREST TENTH ARE THE OLD GROUND ALONG CENTERLINE. THE ELEVATIONS SHOWN TO THE NEAREST HUNDREDTH ARE THE PROPOSED GROUND ALONG CENTERLINE.

DATUM	
VERTICAL	NAVD 1929
HORIZONTAL	NAD 27

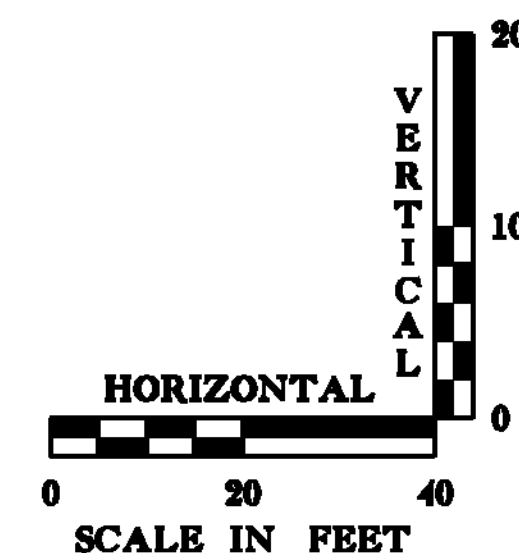

PROJECT NAME: BARRE CITY
PROJECT NUMBER: FECC F 026-(134) C/2

FILE NAME: 85b010_PRO5_C2
PROJECT LEADER: G. BAKOS
DESIGNED BY: DMP / MDS
PROFILES - SIDE ROADS *1

PLOT DATE: 3/9/2011
DRAWN BY: DMP / JAR
CHECKED BY:
SHEET 73 OF 339