



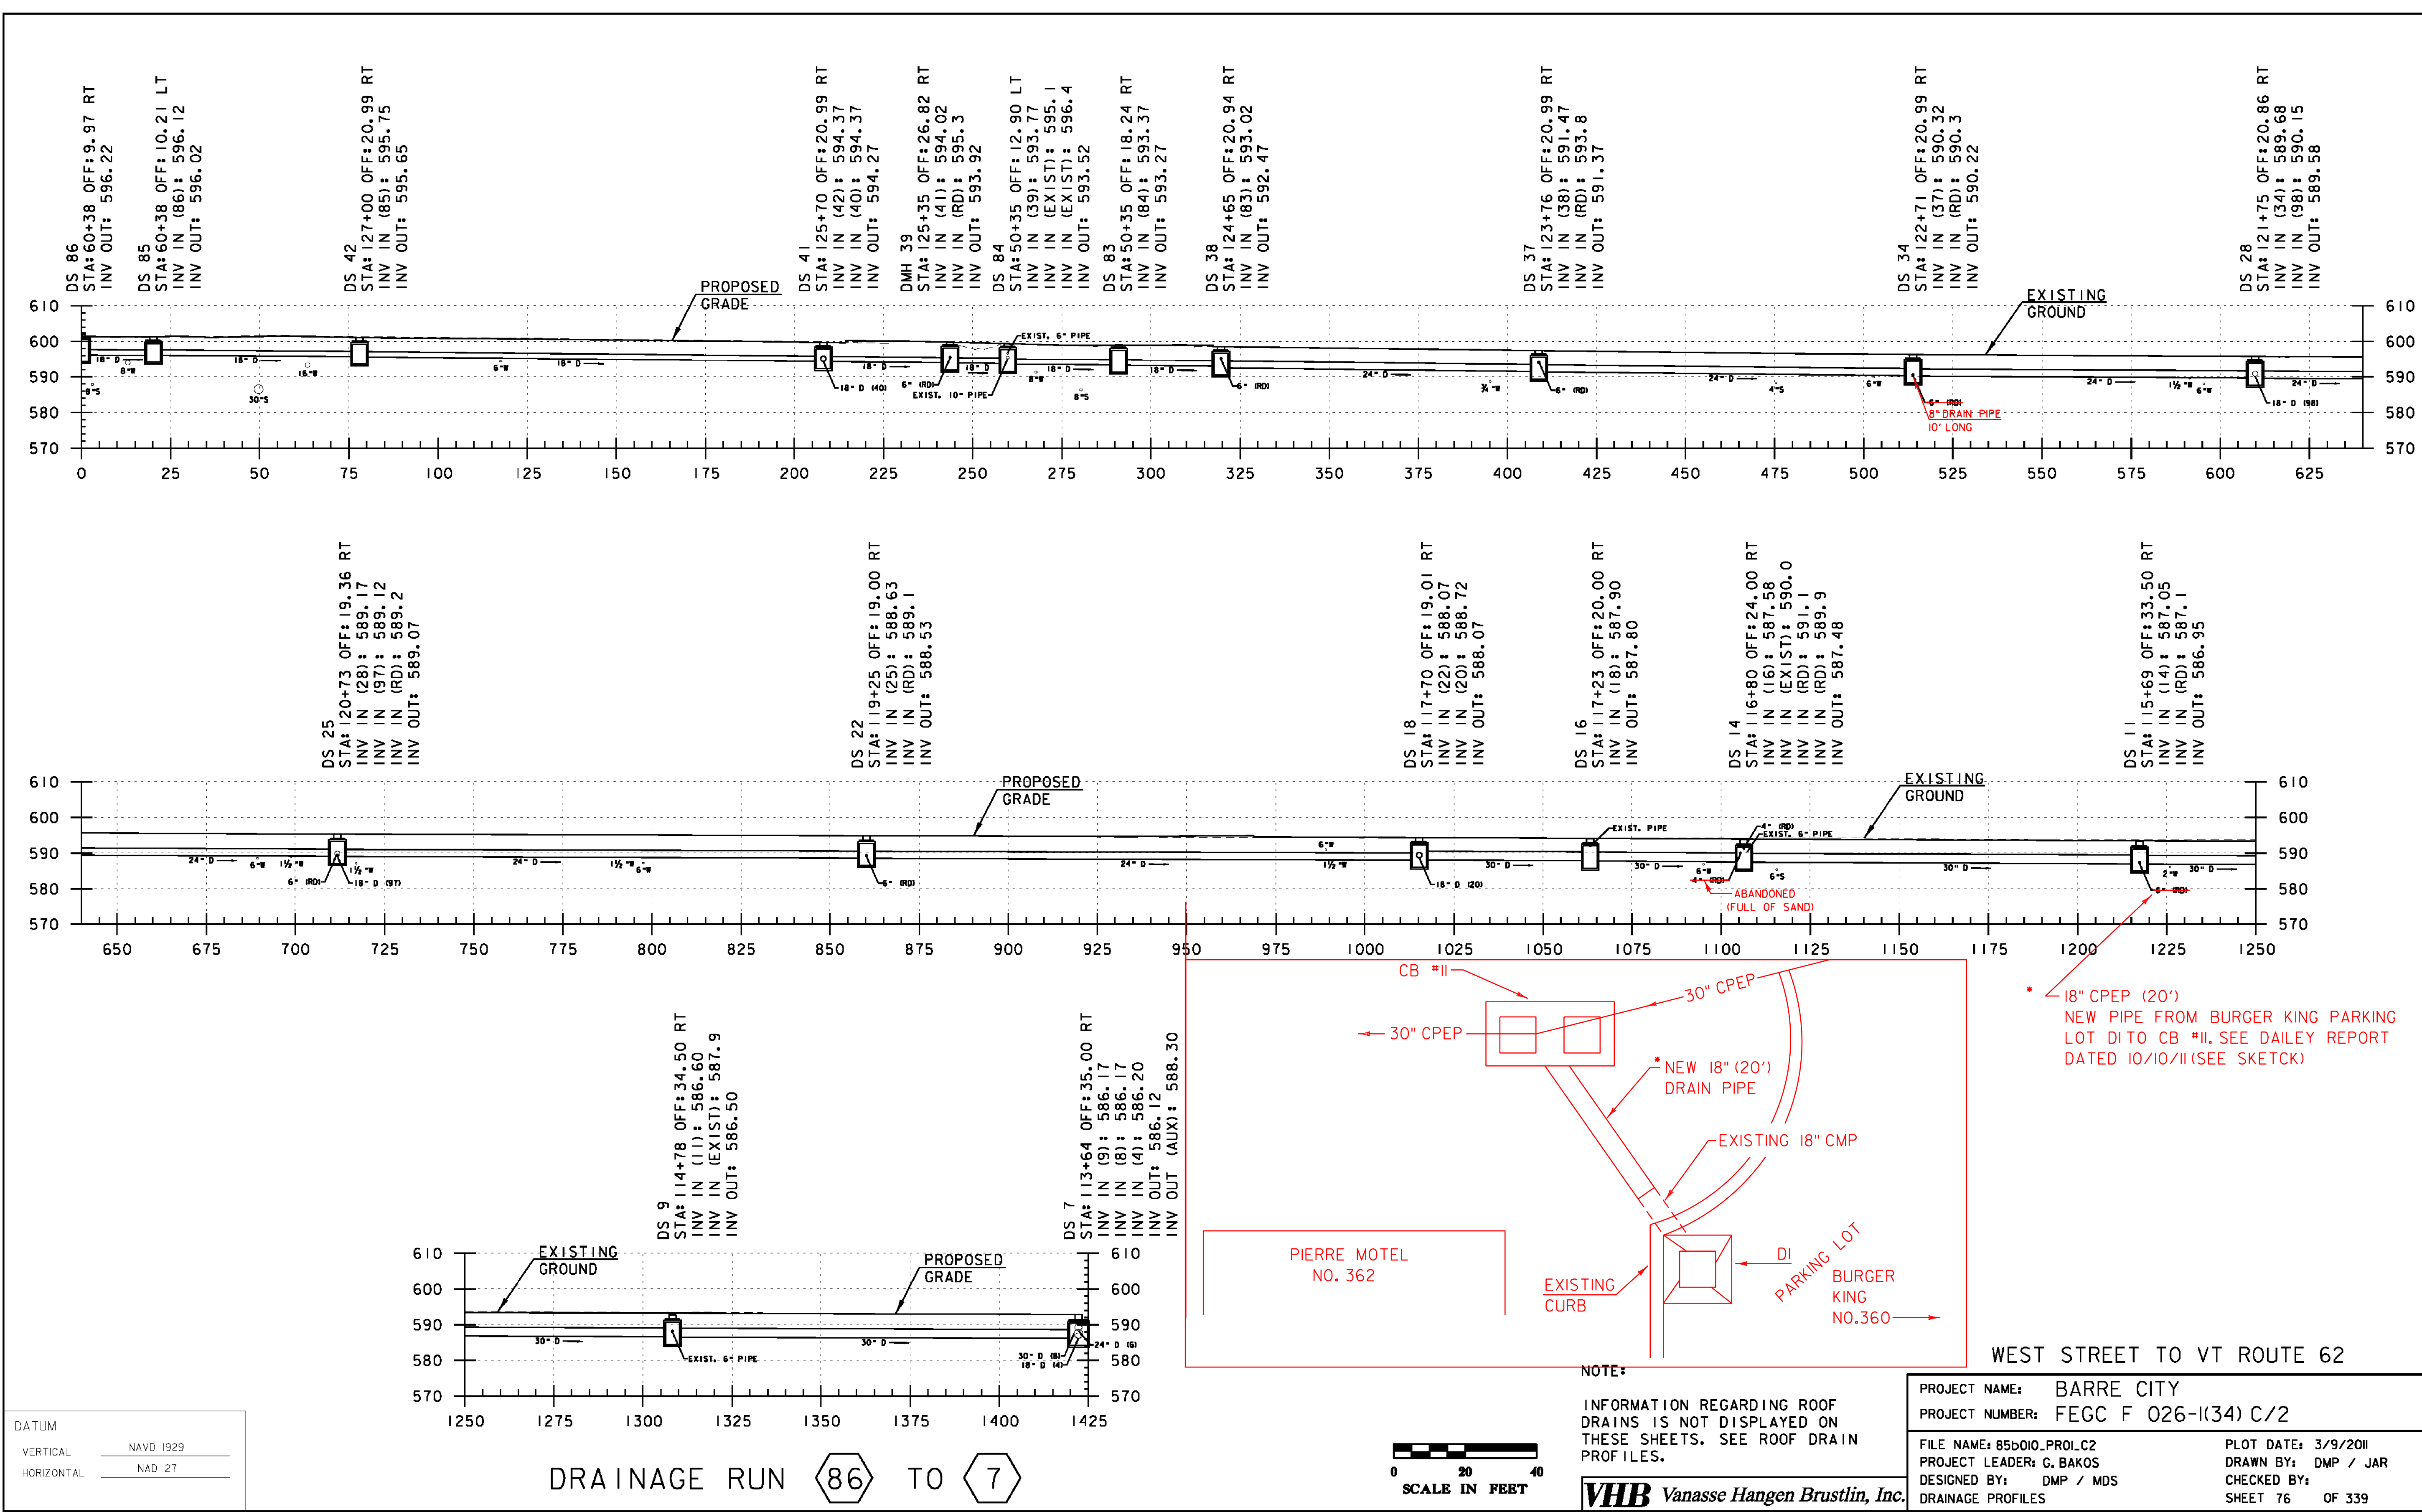

DATUM	
VERTICAL	NAVD 1929
HORIZONTAL	NAD 27

DRAINAGE RUN 86 TO 7

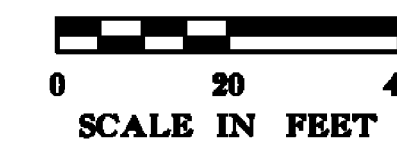

INFORMATION REGARDING ROOF DRAINS IS NOT DISPLAYED ON THESE SHEETS. SEE ROOF DRAIN PROFILES.



PROJECT NAME:	BARRE CITY	PLOT DATE:	3/9/2011
PROJECT NUMBER:	FEGC F 026-(K34) C/2	DRAWN BY:	DMP / JAR
FILE NAME:	85b010_PROJ.C2	CHECKED BY:	
PROJECT LEADER:	G. BAKOS		
DESIGNED BY:	DMP / MDS		
DRAINAGE PROFILES		SHEET	76 OF 339