


DATUM	
VERTICAL	NAVD 1929
HORIZONTAL	NAD 27



NOTE:
 INFORMATION REGARDING ROOF DRAINS IS NOT DISPLAYED ON THESE SHEETS. SEE ROOF DRAIN PROFILES.

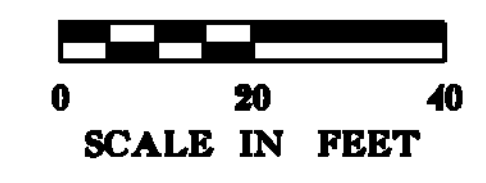

POTASH BROOK BOX CULVERT

PROJECT NAME:	BARRE CITY	FILE NAME:	85b010_PROJ_C2	PLOT DATE:	3/9/2011
PROJECT NUMBER:	FEGC F 026-I(34) C/2	PROJECT LEADER:	G. BAKOS	DRAWN BY:	DMP / JAR
DESIGNED BY:	DMP / MDS	DRAINAGE PROFILES:		CHECKED BY:	
				SHEET 77	OF 339