



DRAINAGE RUN 55 TO 60

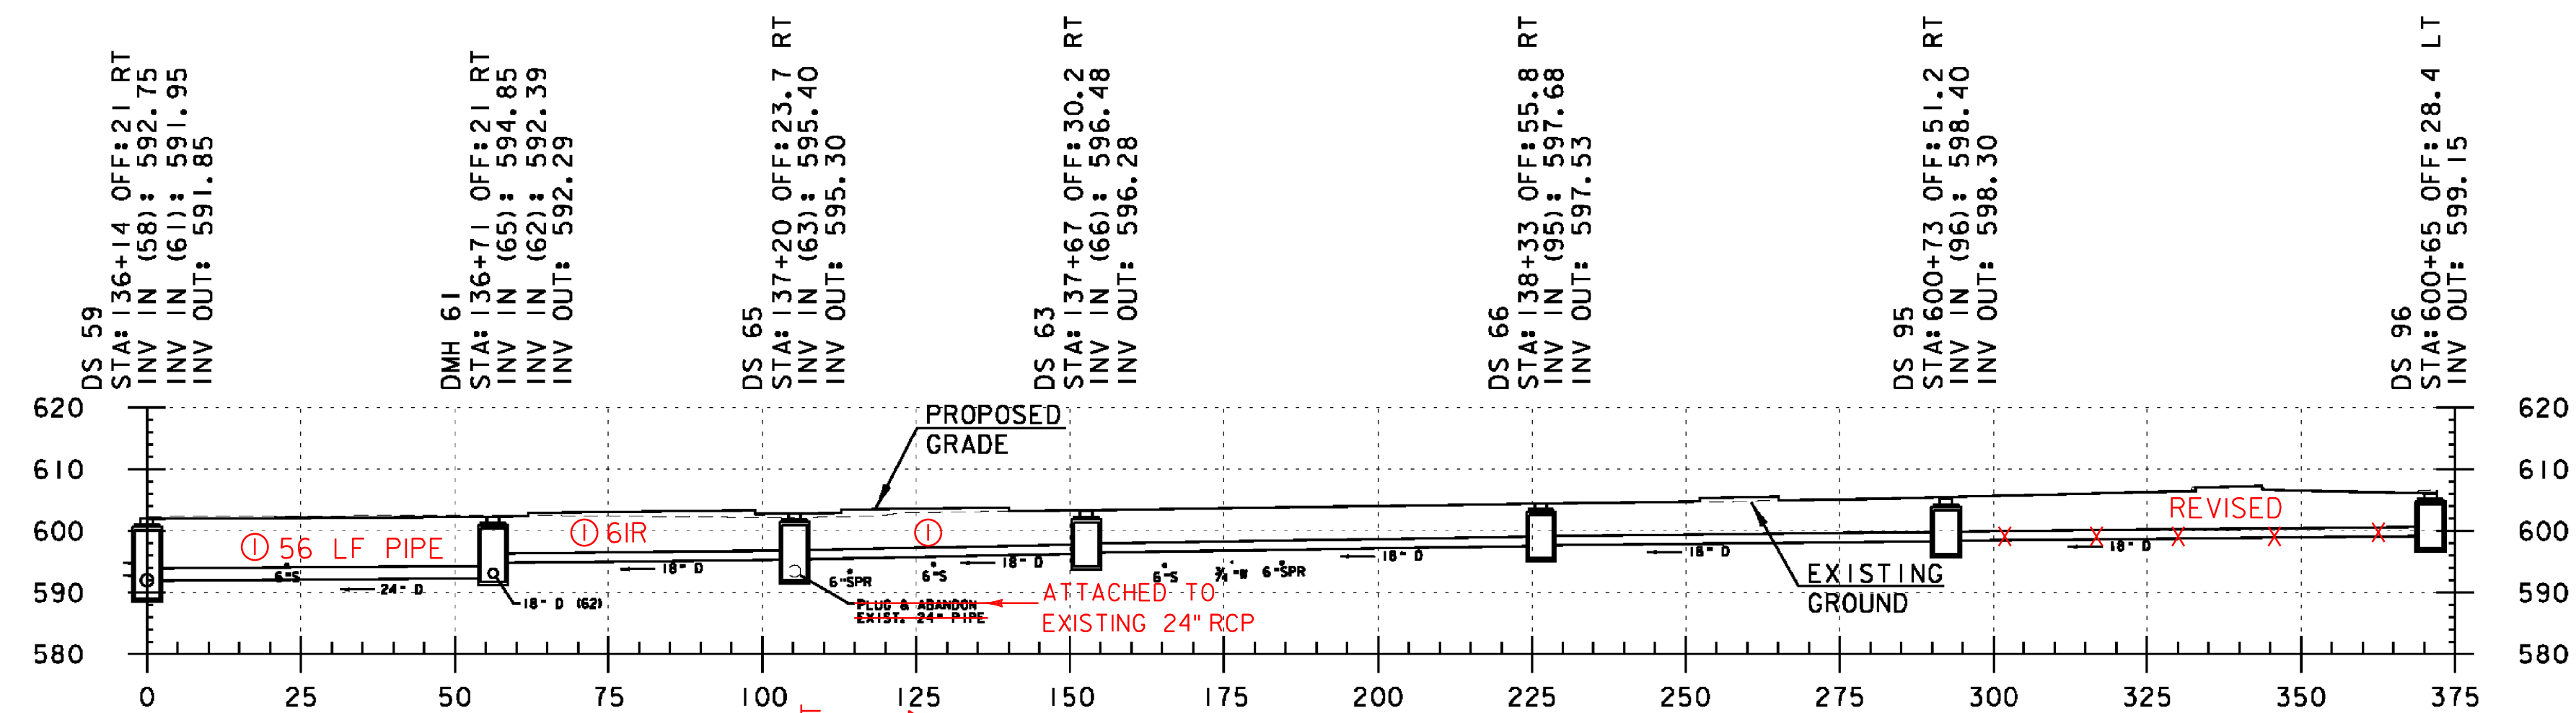

DRAINAGE RUN 96 TO 59

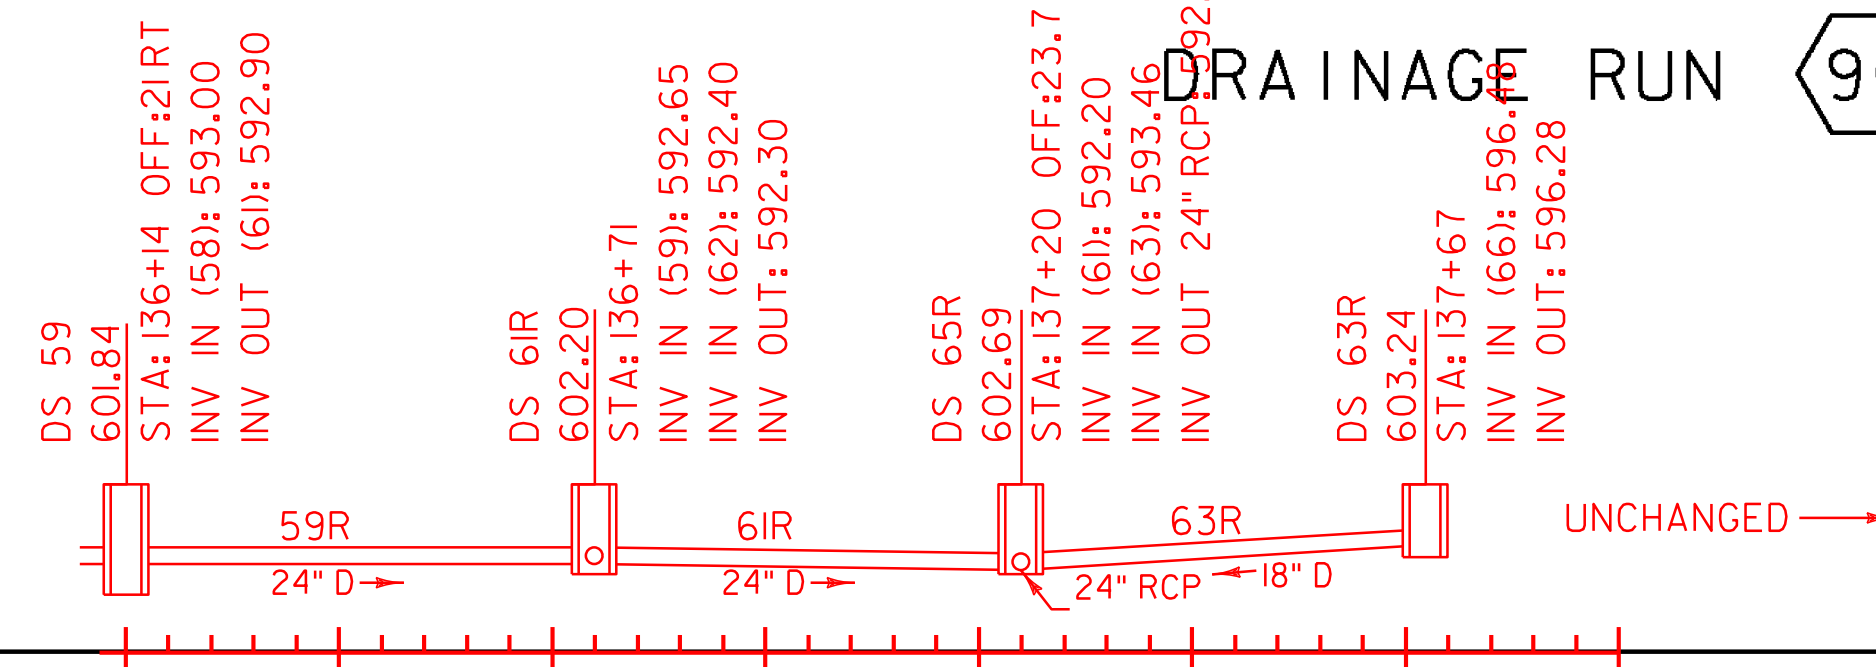

NOTE:
INFORMATION REGARDING ROOF DRAINS IS NOT DISPLAYED ON THESE SHEETS. SEE ROOF DRAIN PROFILES.



VHB Vanasse Hangen Brustlin, Inc.

ALLEY WAY OUTLET

PROJECT NAME: BARRE CITY
PROJECT NUMBER: FECC F 026-(134) C/2

FILE NAME: 85b010_PROJ.C2
PROJECT LEADER: G. BAKOS
DESIGNED BY: DMP / MDS
DRAINAGE PROFILES

PLOT DATE: 3/9/2011
DRAWN BY: DMP / JAR
CHECKED BY:
SHEET 78 OF 339

① DRAINAGE RUN REVISED TO UTILIZE EXISTING 24" RCP RATHER THAN INSTALL DRAINAGE RUN #59. DRAINAGE RUN #59 COULD NOT BE CONSTRUCTED DUE TO UNKNOWN OBSTACLES BENEATH THE PEDESTRIAN WALKWAY.