



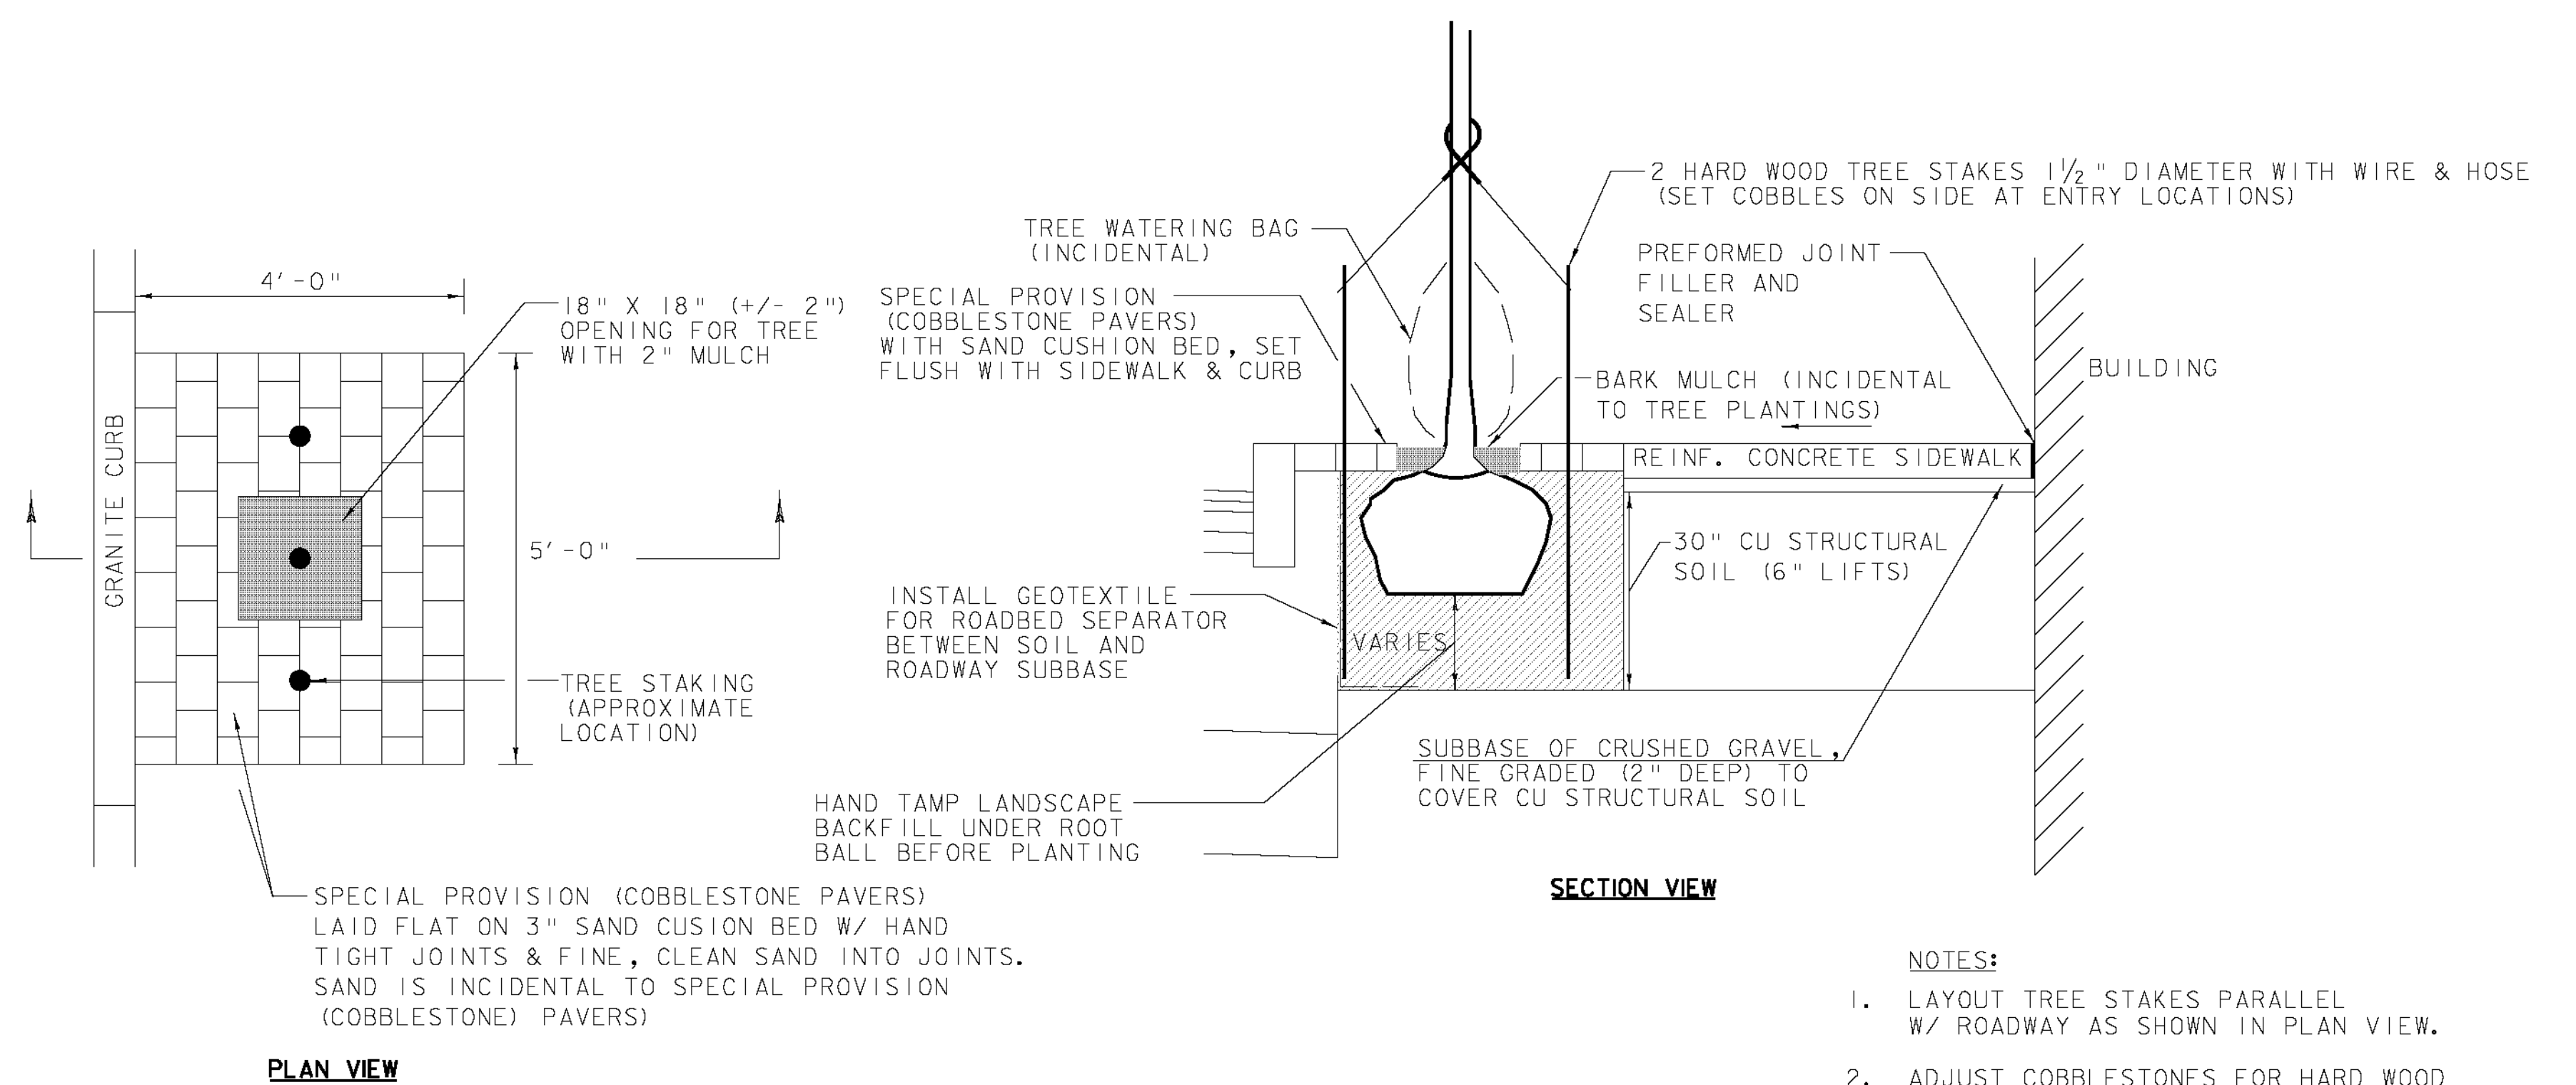

SPECIAL PROVISION (GRANITE POST AND CHAIN FENCE) SECTION DETAIL
N.T.S.

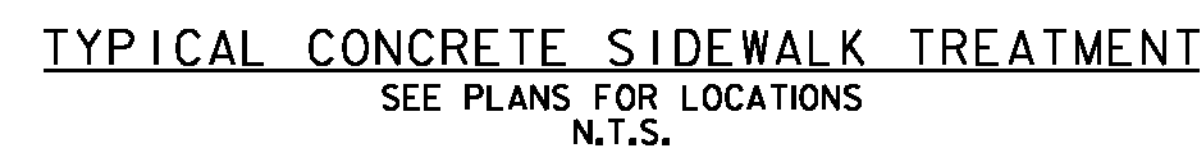

TREE PIT IN SIDEWALK DETAIL
N.T.S.

- NOTES:
1. LAYOUT TREE STAKES PARALLEL W/ ROADWAY AS SHOWN IN PLAN VIEW.
 2. ADJUST COBBLESTONES FOR HARD WOOD STAKES

