
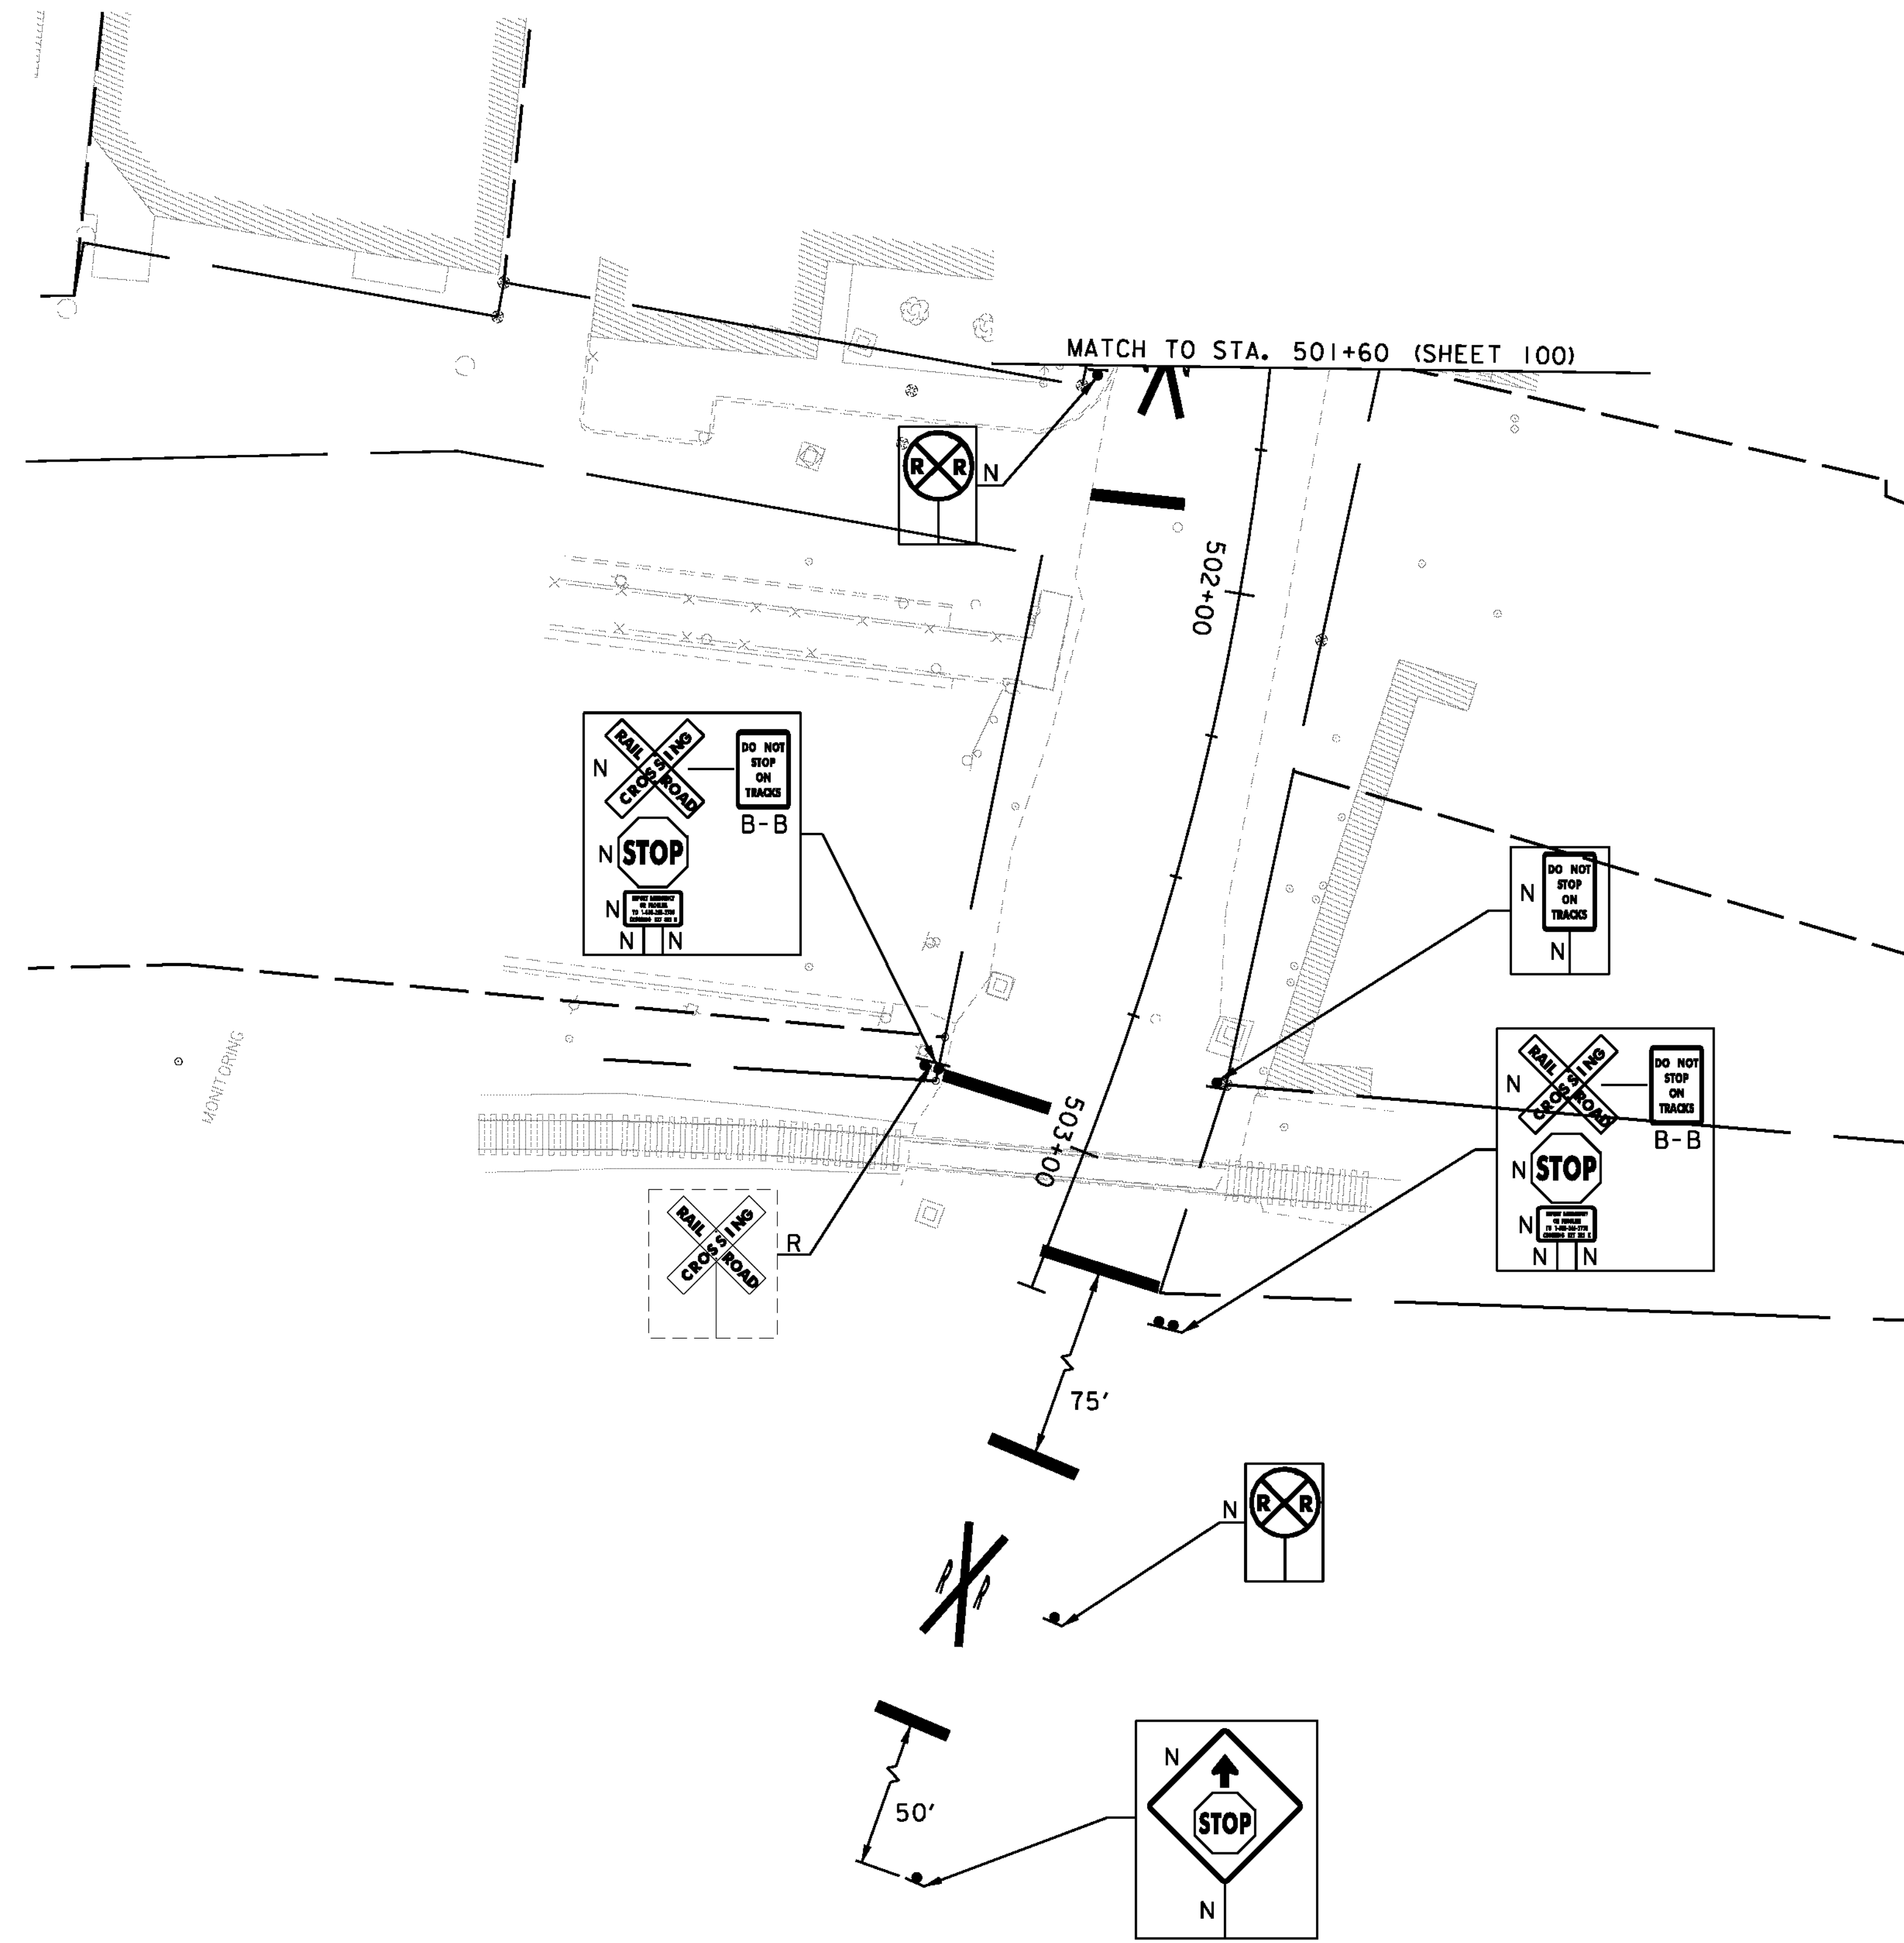


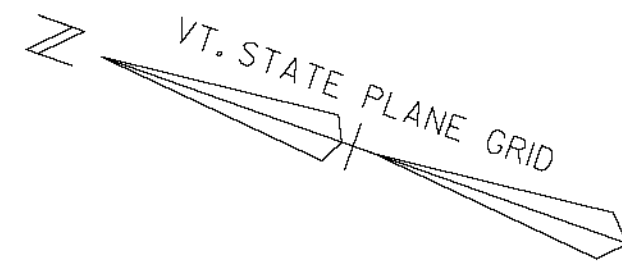

REMOVING SIGNS (TYPE A)
SL STA 502+95 RT

24 INCH STOP BAR
SL STA 502+95 RT
SL STA 503+18 LT

RAILROAD CROSSING SYMBOL
PROSPECT STREET RIGHT
PROSPECT STREET LEFT

SIGNING LEGEND

N = NEW
R = REMOVE
R&S = REMOVE AND SALVAGE

STRIPING LEGEND

SWL = SINGLE WHITE LINE
SYL = SINGLE YELLOW LINE
DYL = DOUBLE YELLOW LINE



VHB Vanasse Hangen Brustlin, Inc.

PROJECT NAME: BARRE CITY
PROJECT NUMBER: FECC-F 026-1(34) C/2

FILE NAME: z85b010bdr_spm.C2	PLOT DATE: 3/9/2011
PROJECT LEADER: G. BAKOS	DRAWN BY: D. PECK
DESIGNED BY: D. PECK	CHECKED BY:
SIGNS AND PAVEMENT MARKING PLANS #14	SHEET 109 OF 339