

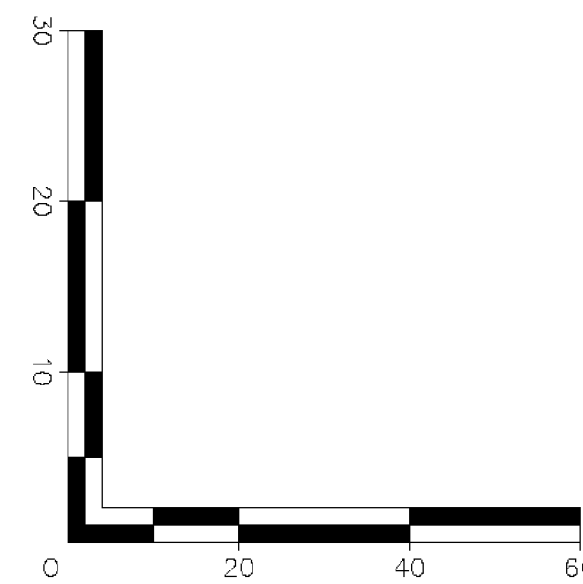
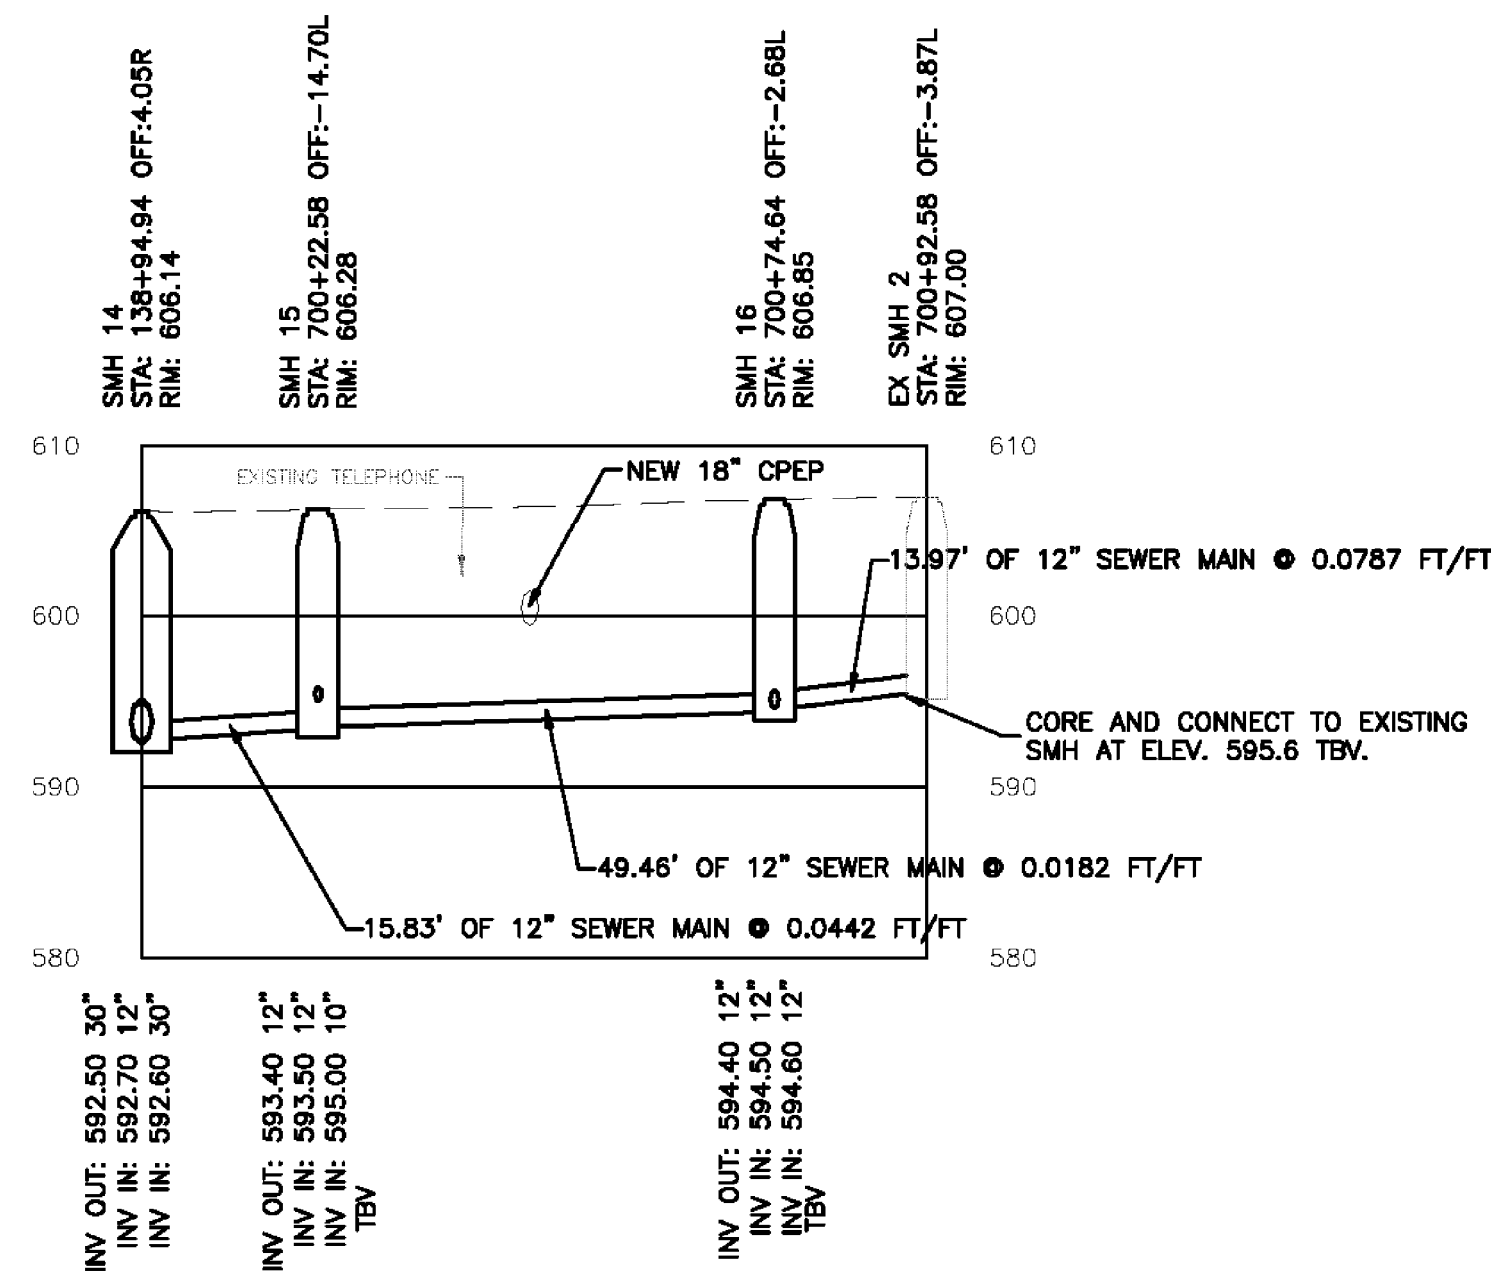


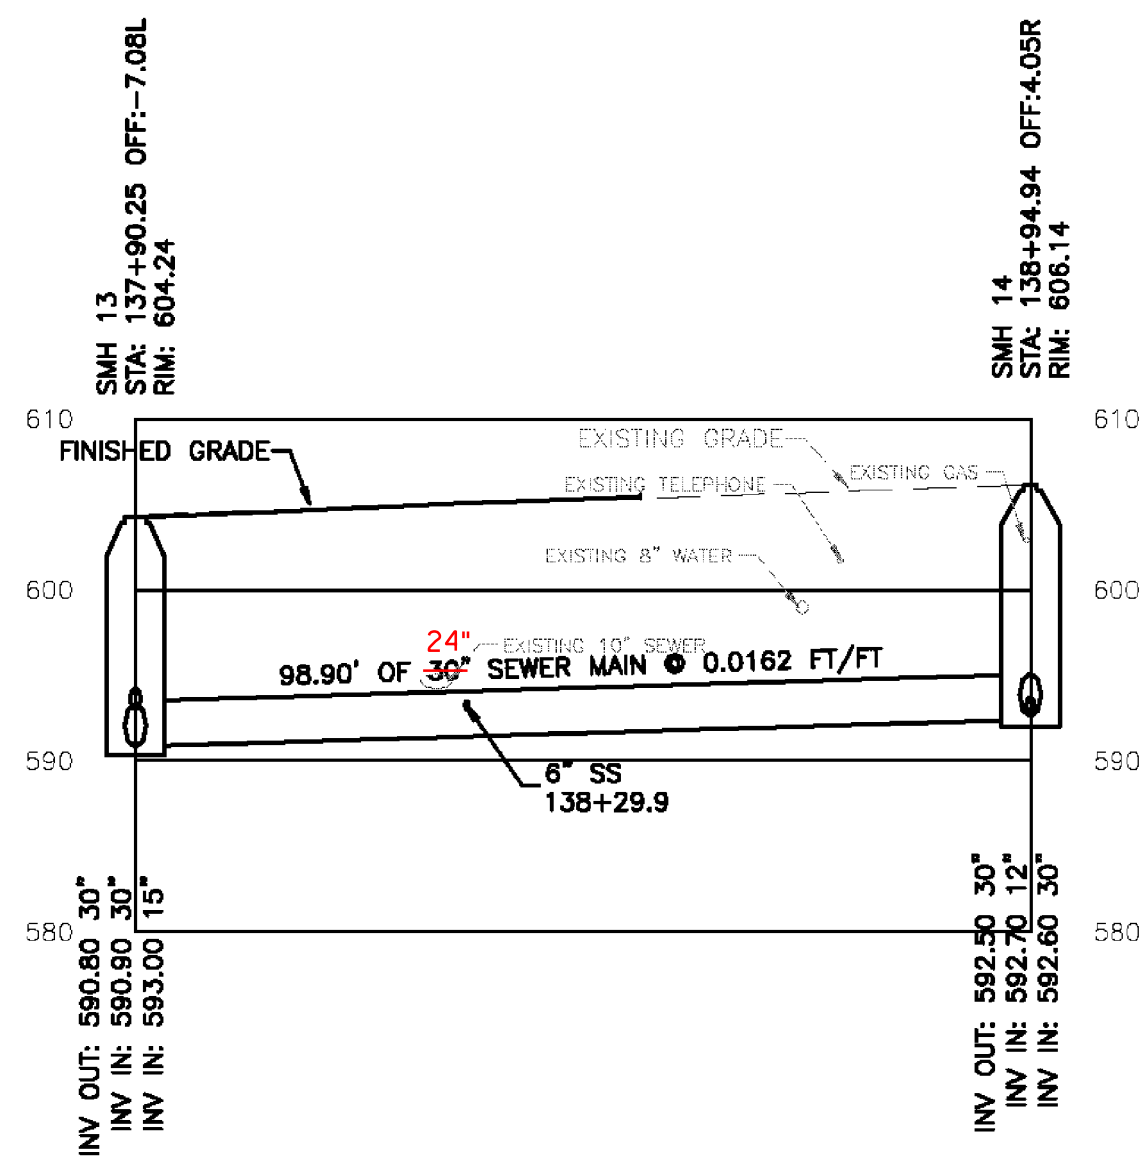

- NOTES:**
1. SEE SHEET 133 FOR GENERAL NOTES, LEGEND, AND ABBREVIATIONS.
 2. STATIONING SHOWN HEREON IS BASED ON ROAD CENTERLINE AS PER VTRANS REQUIREMENTS AND MAY NOT REFLECT PROPER PIPE LENGTHS.
 3. SEE SHEETS 134-138 FOR PLAN INFORMATION.
 4. SEE SHEETS 144-149 FOR SEWER SERVICE PROFILES.
 5. SEE SHEETS 150 AND 154 FOR DETAILS.

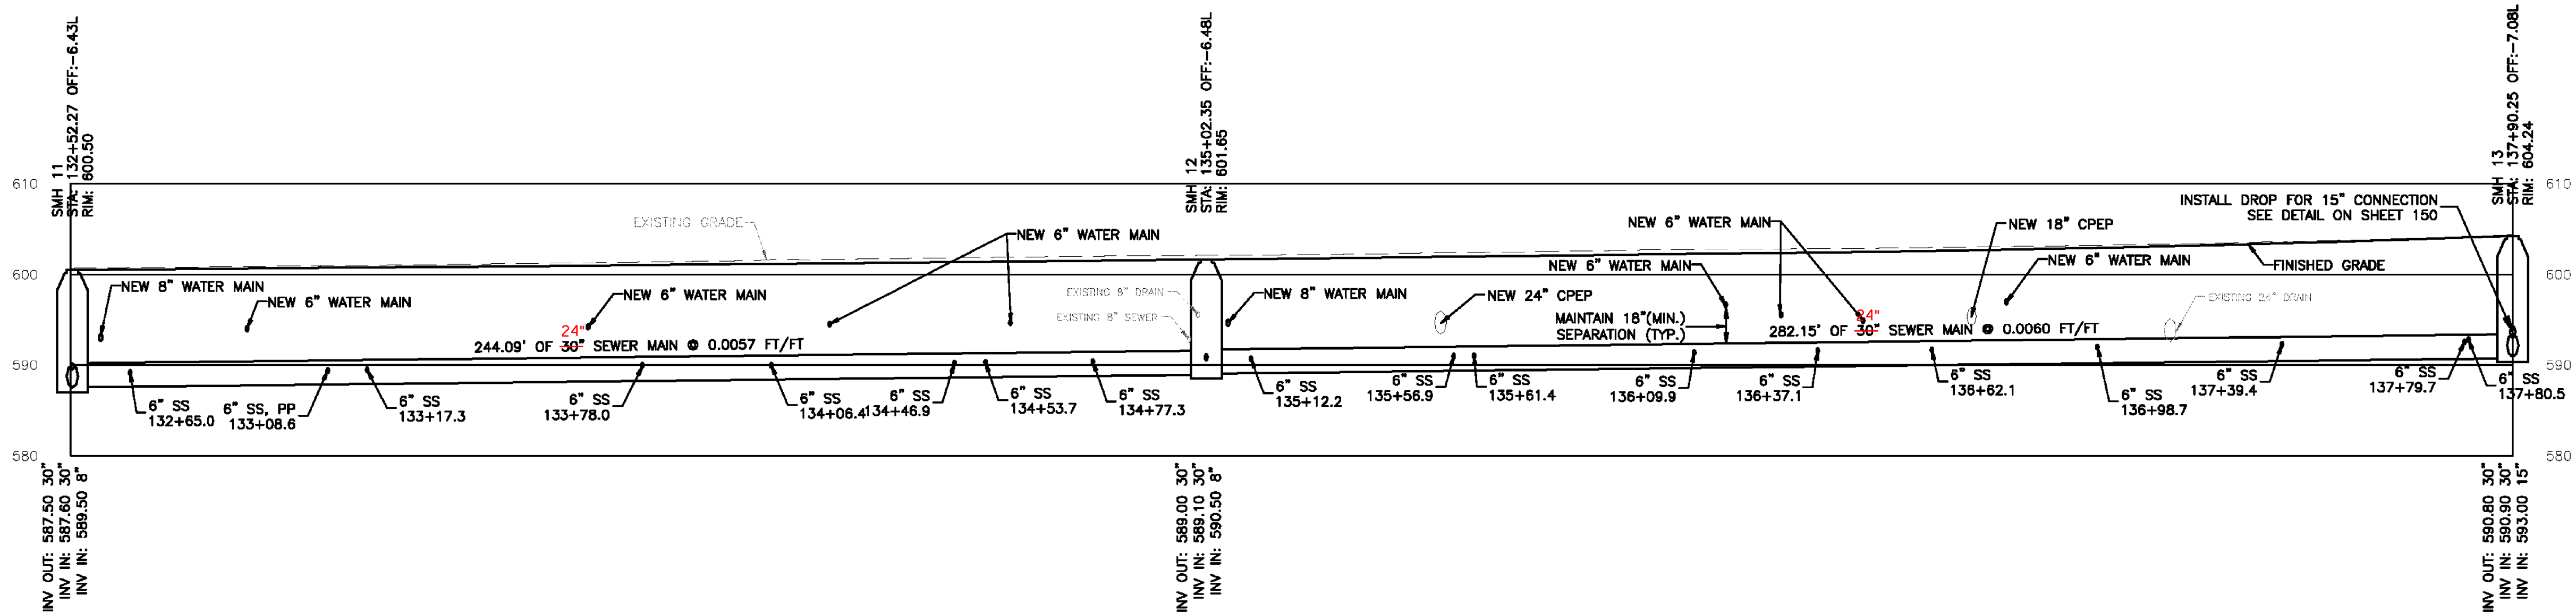

PROJECT NAME: BARRE CITY
 PROJECT NUMBER: FEGC F 026-1(34) C/2

FILE NAME: 717014-PROFILES
 PROJECT LEADER: R.E. DUFRESNE
 DESIGNED BY: B.L. BAKER
 SANITARY SEWER PROFILES

PLOT DATE: Feb. 18, 11
 DRAWN BY: B.L. BAKER
 CHECKED BY: C.L. WHITHEAD
 SHEET 141 OF 339