
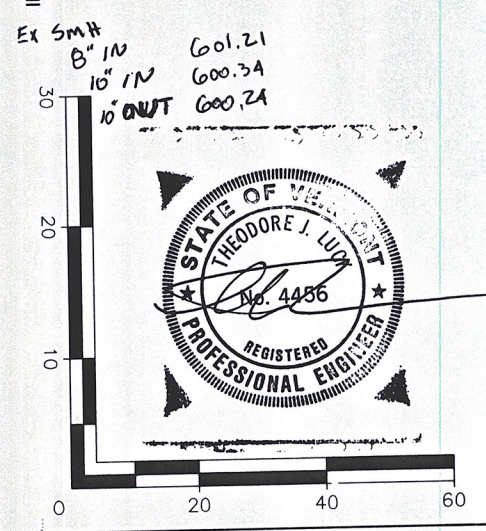
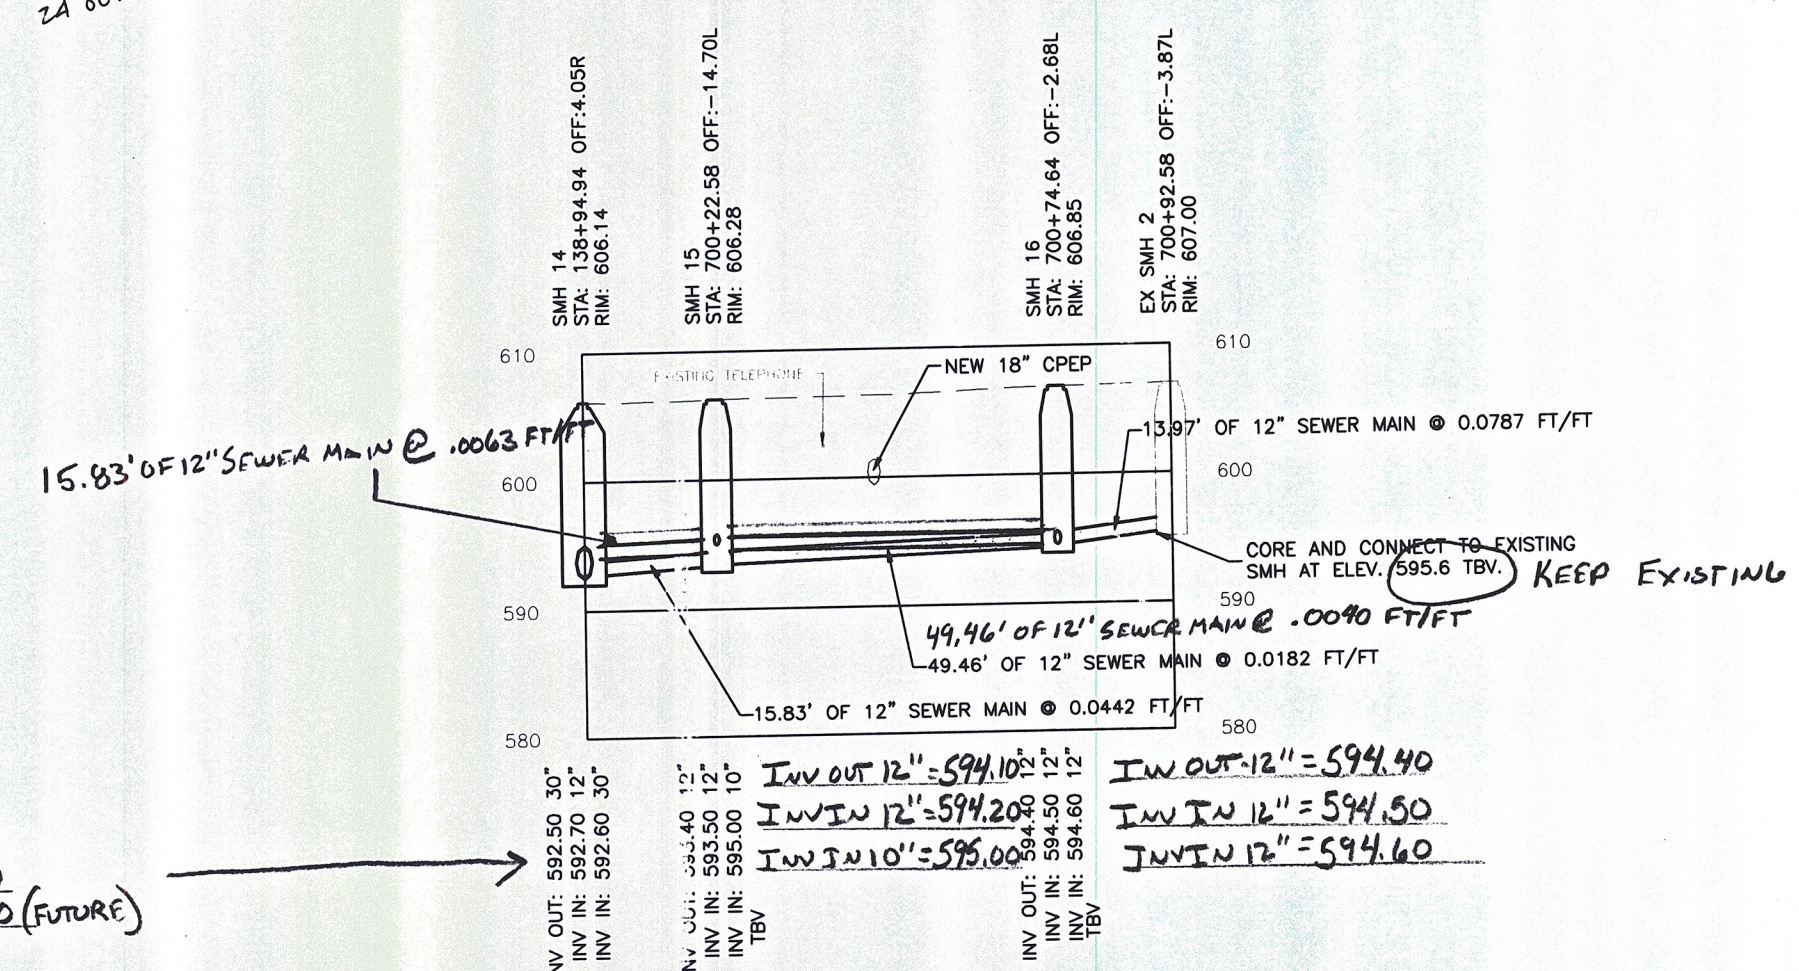
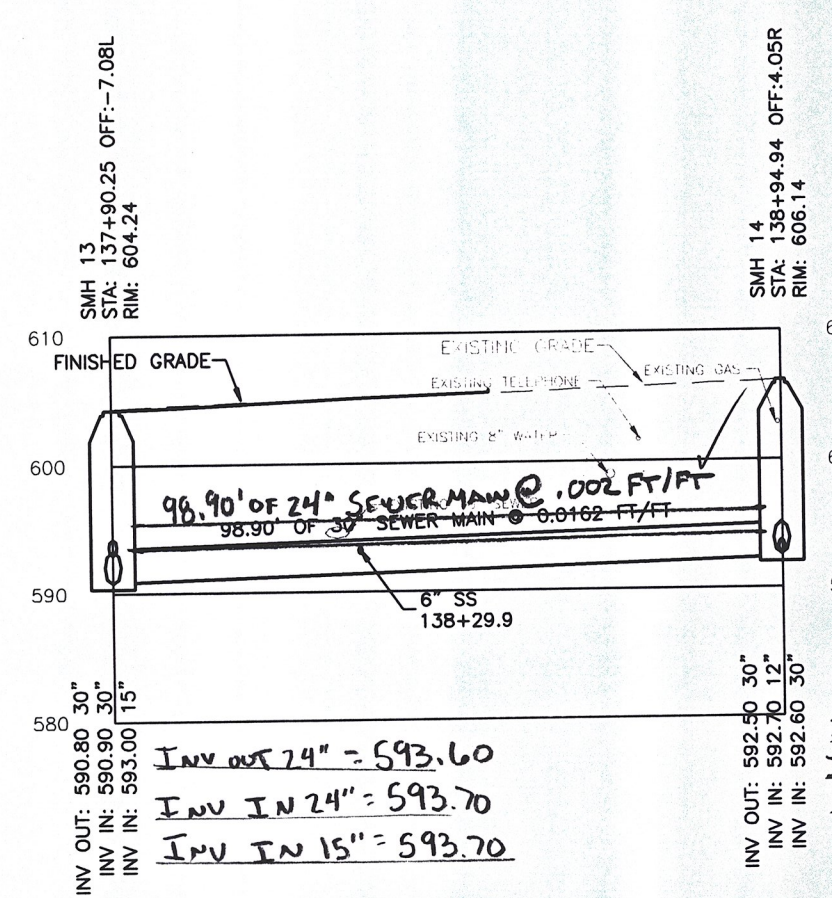


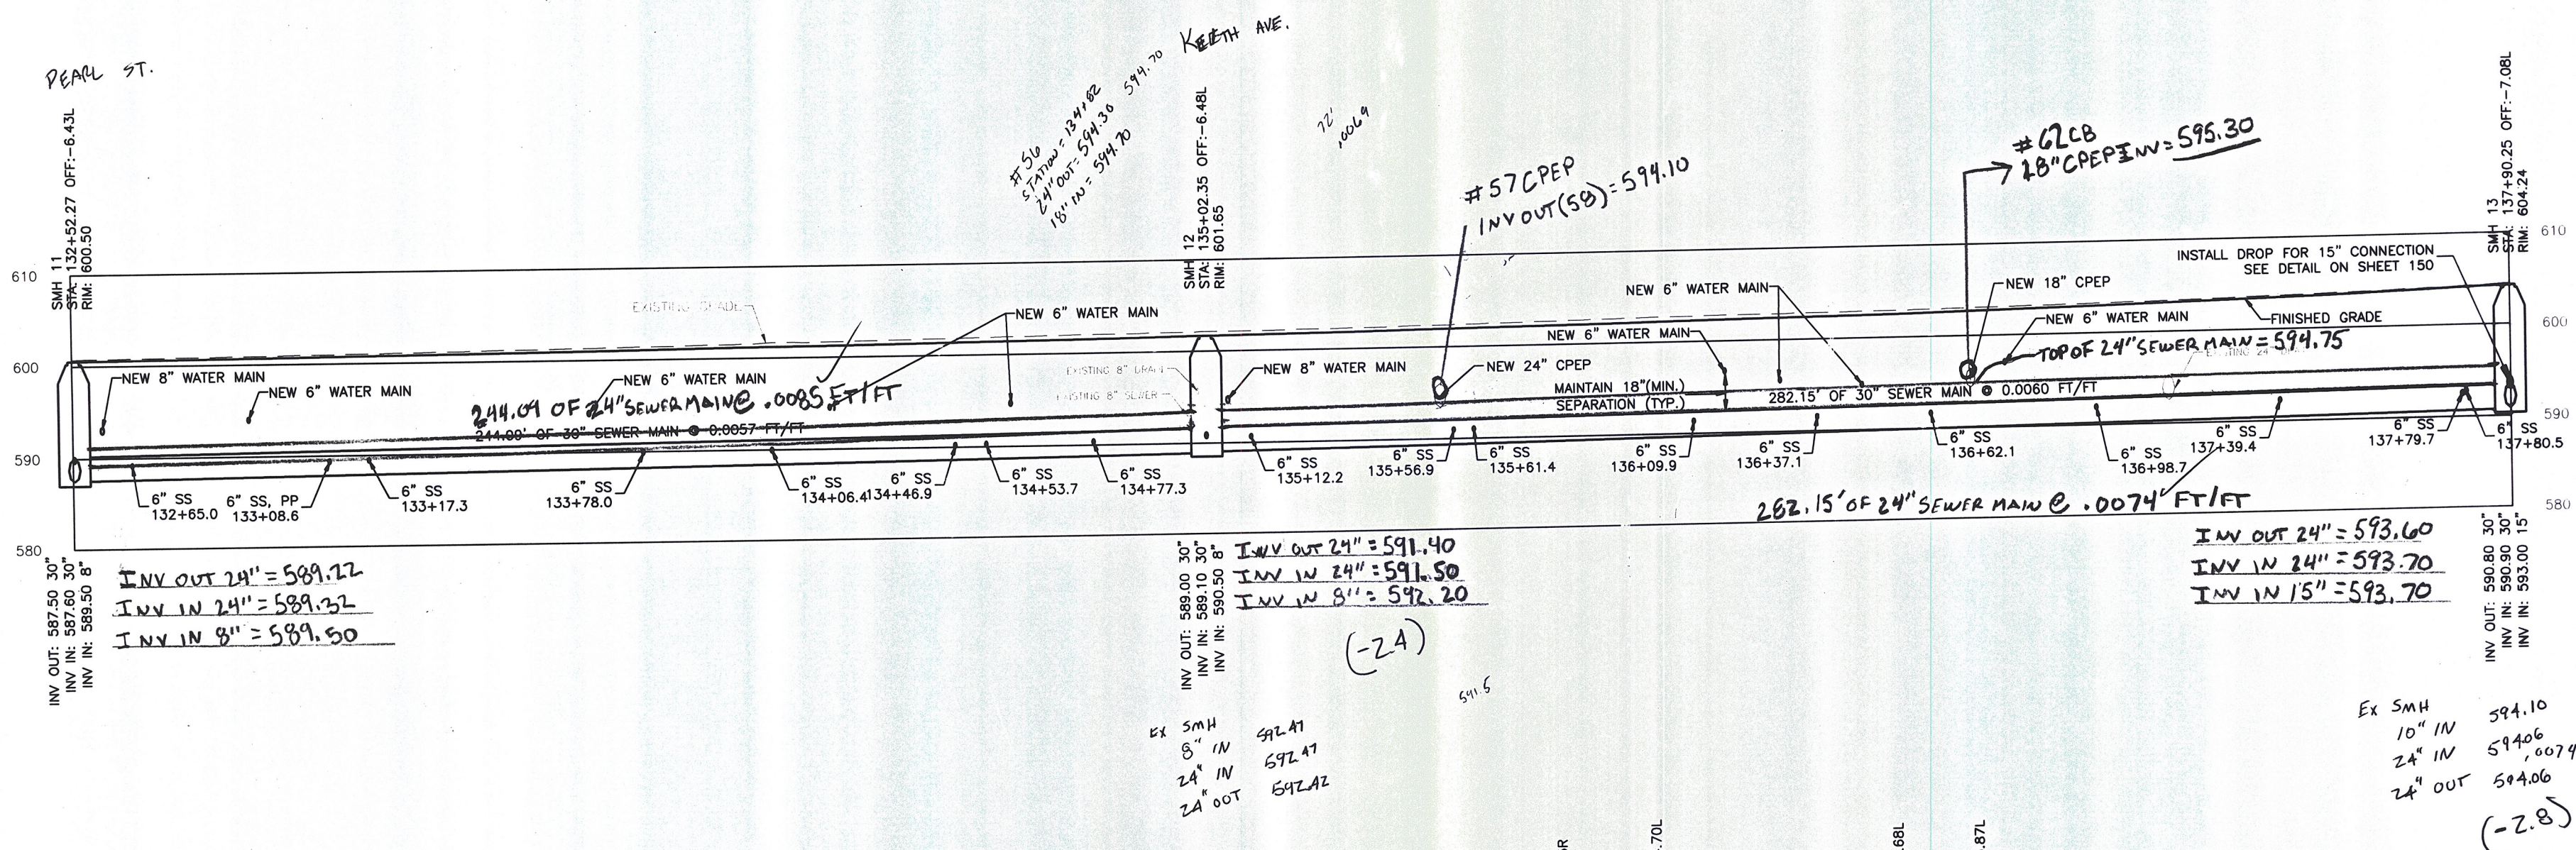

NOTES:

- SEE SHEET 133 FOR GENERAL NOTES, LEGEND, AND ABBREVIATIONS.
- STATISTICS SHOWN HEREON IS BASED ON ROAD CENTERLINE AS PER VTRANS REQUIREMENTS AND MAY NOT REFLECT PROPER PIPE LENGTHS.
- SEE SHEET 134-138 FOR PLAN INFORMATION.
- SEE SHEET 144-149 FOR SEWER SERVICE PROFILES.
- SEE SHEET 150 AND 154 FOR DETAILS.

NOTES / REVISIONS	
ISSUED:	2/7/2012
PROJECT NAME:	BARRE CITY
PROJECT NUMBER:	FECC F 026-134) C/2
FILE NAME:	SAN PROFILES
MANAGER:	J. LUCK
DRAWN BY:	C. KEMPNEY
PROPOSED REDESIGN SANITARY SEWER PROFILES	