

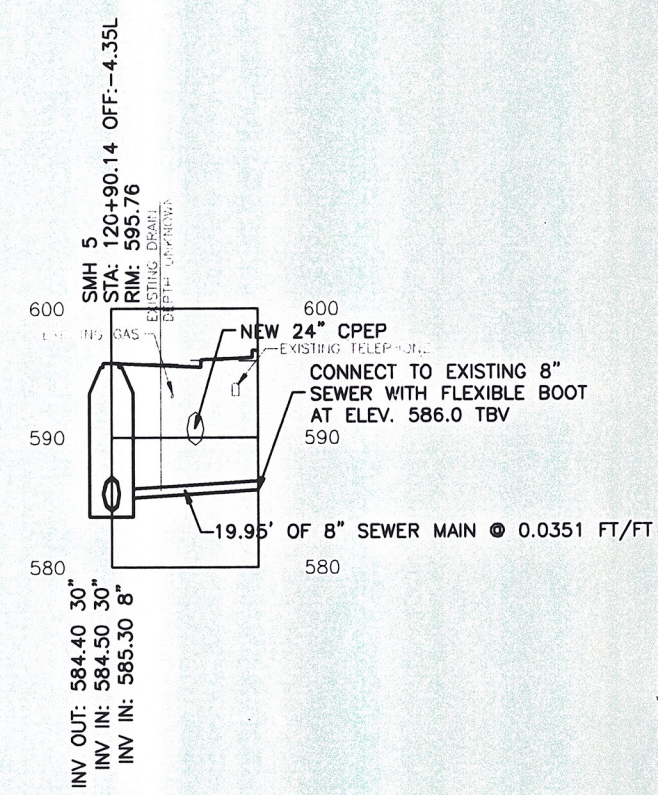
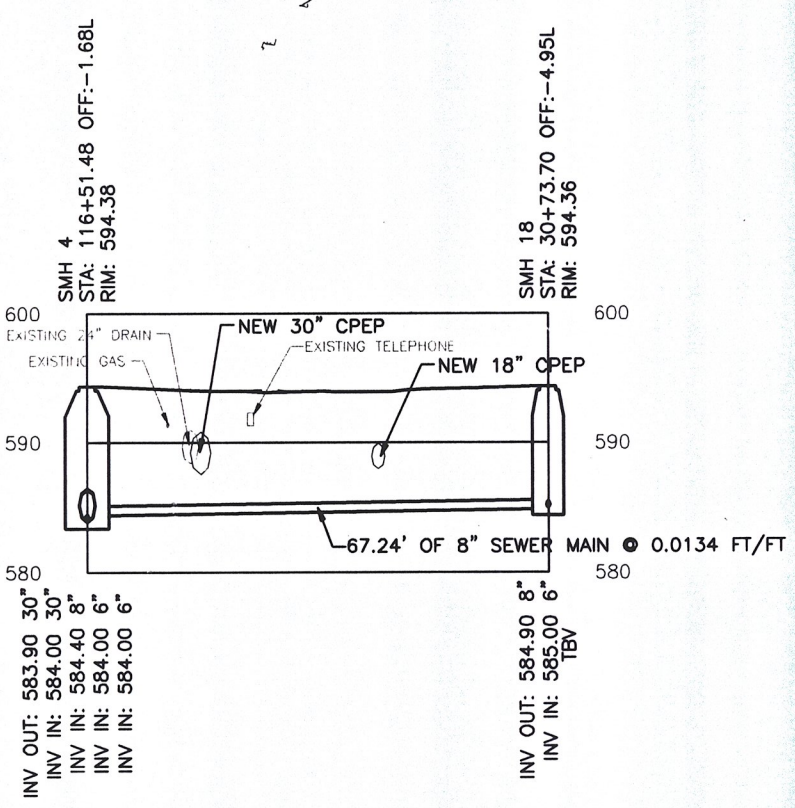
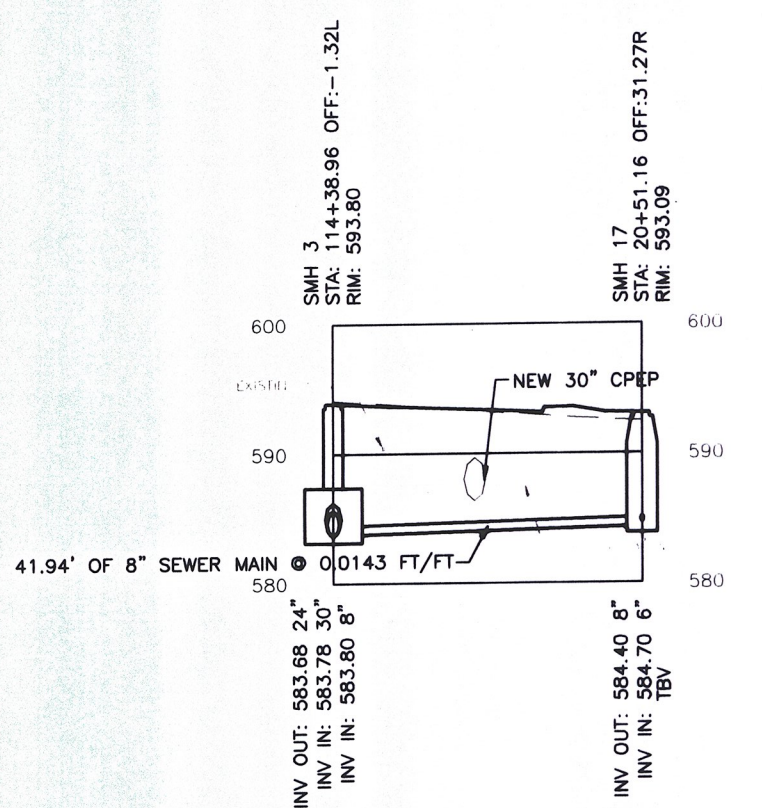
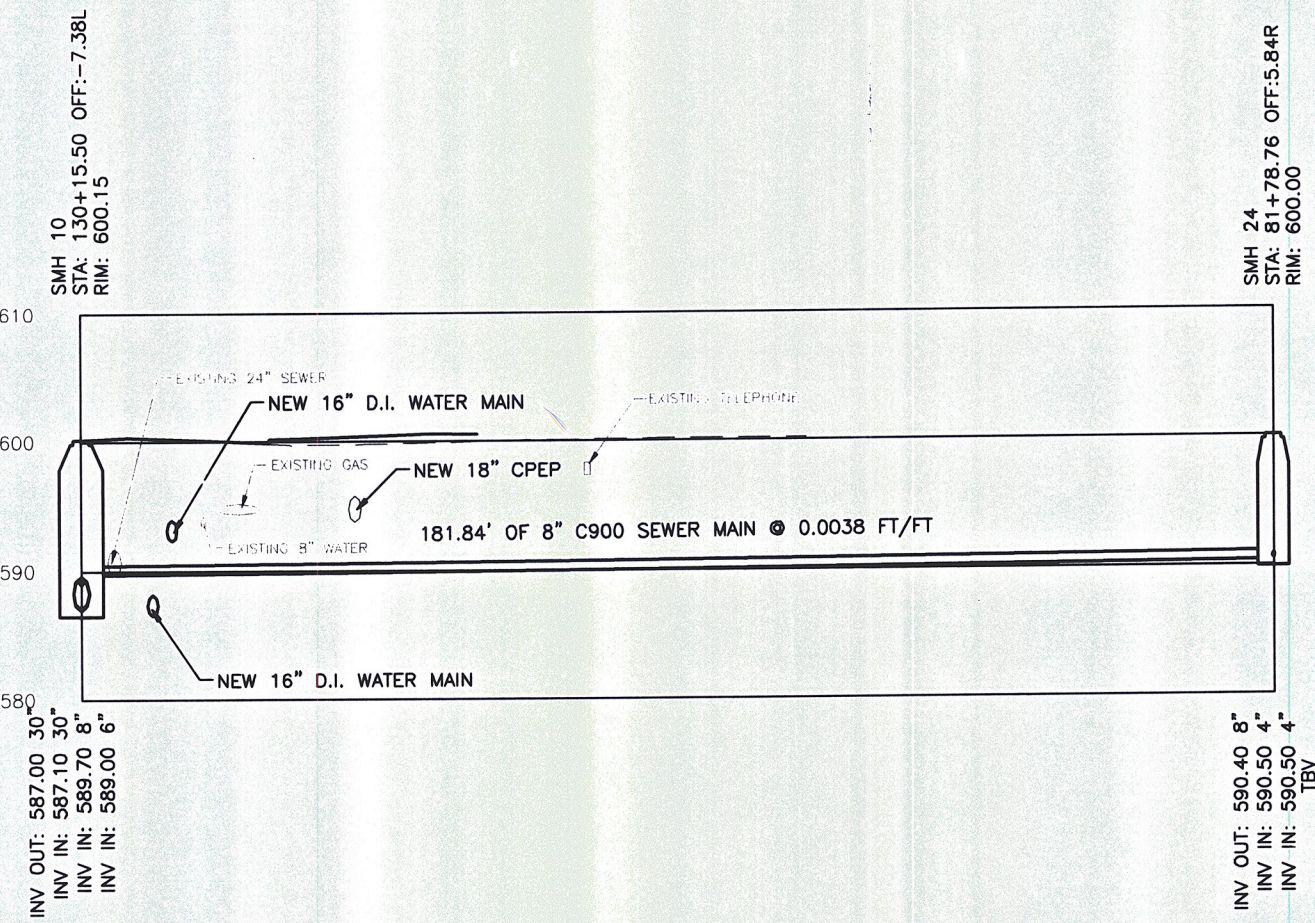
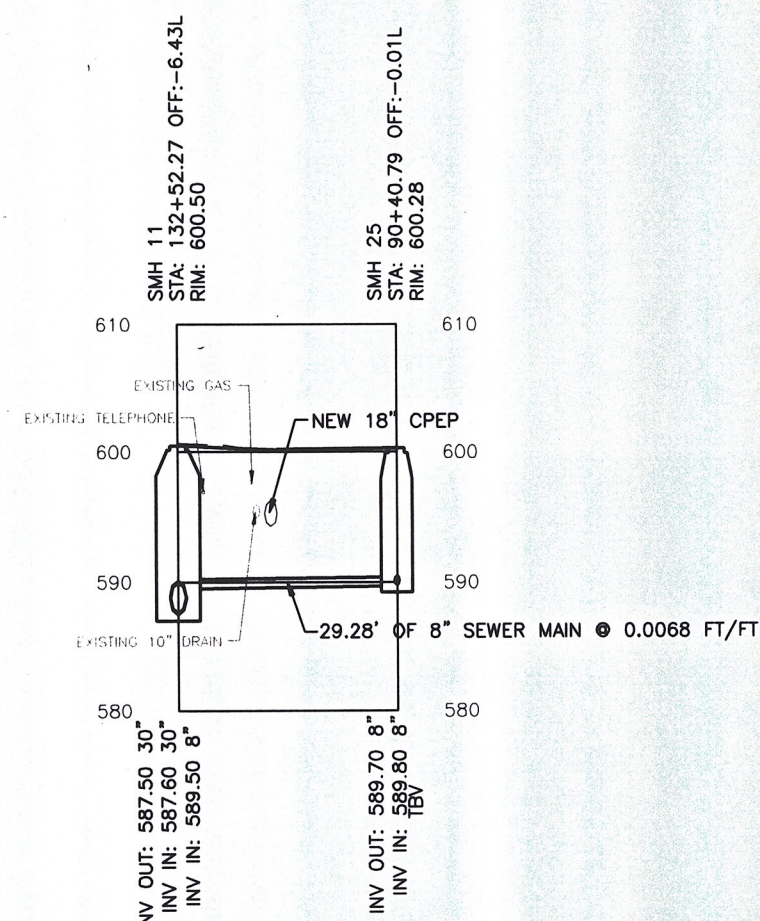
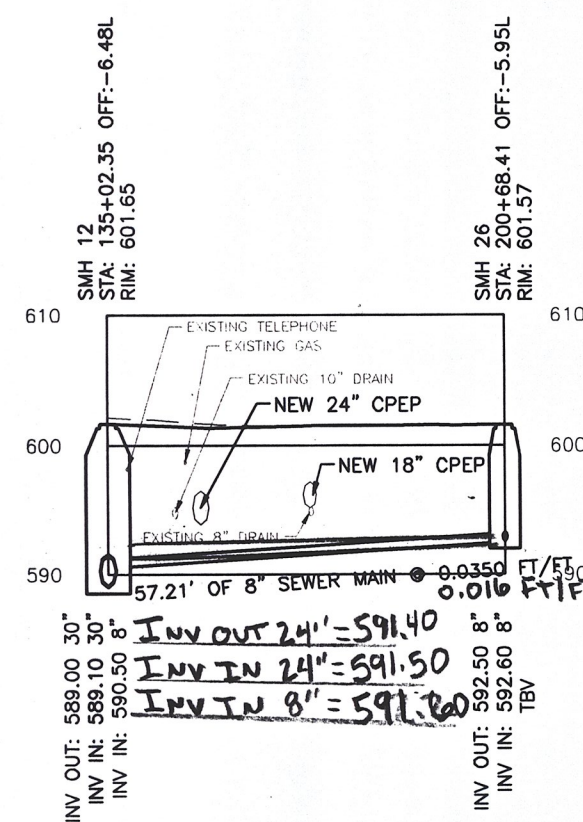



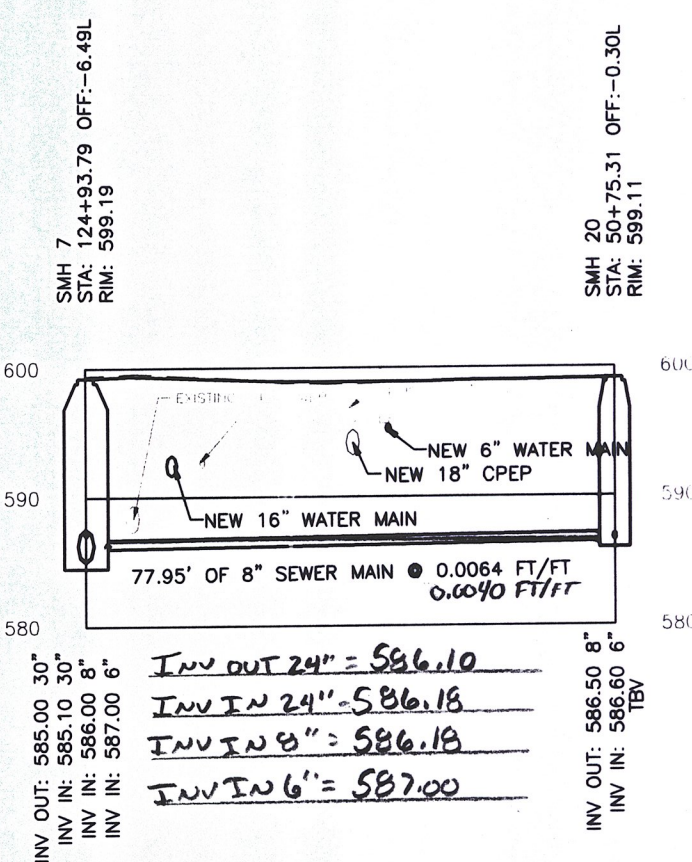


INV OUT 24" = 586.00
INV IN 24" = 586.00
INV IN 18" = 586.00

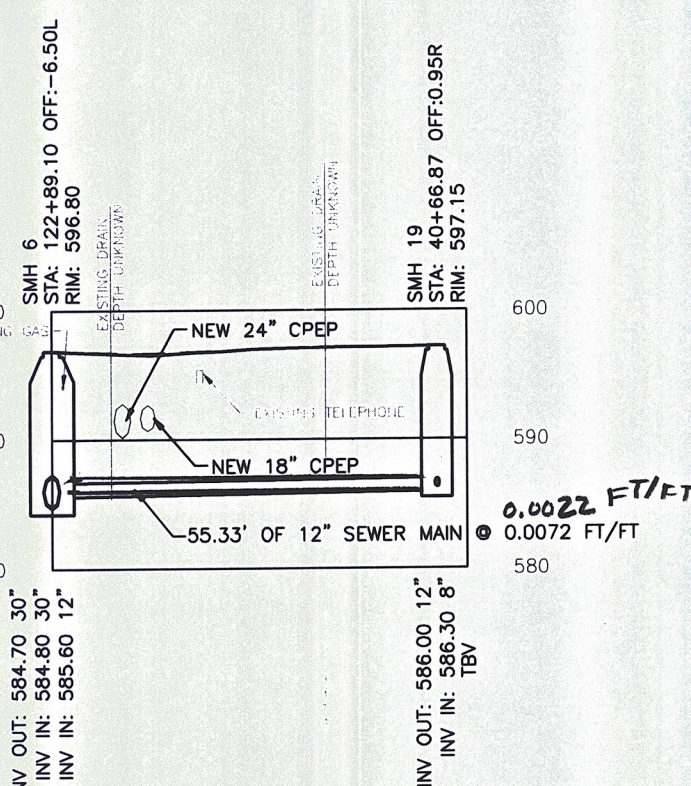

INV OUT 24" = 586.00
INV IN 24" = 586.00
INV IN 18" = 586.00
INV IN 6" = 587.00

- NOTES:**
- SEE SHEET 133 FOR GENERAL NOTES, LEGEND, AND ABBREVIATIONS.
 - STATIONING SHOWN HEREON IS BASED ON ROAD CENTERLINE AS PER VTRANS REQUIREMENTS AND MAY NOT REFLECT PROPER PIPE LENGTHS.
 - SEE SHEETS 134-138 FOR PLAN INFORMATION.
 - SEE SHEETS 144-149 FOR SEWER SERVICE PROFILES.
 - SEE SHEETS 150 AND 154 FOR DETAILS.

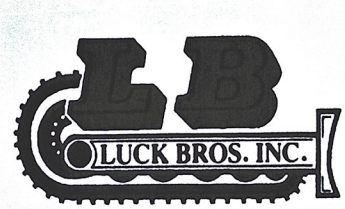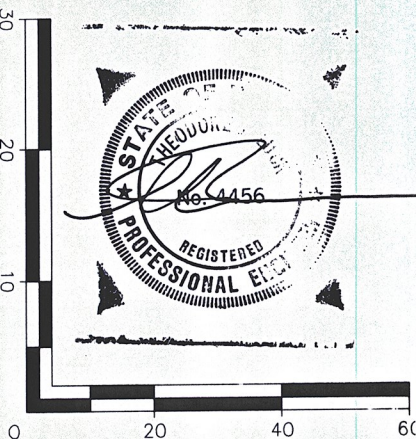

PROJECT NAME:	BARRE CITY
PROJECT NUMBER:	FEGC F 026-1(B) C/2
FILE NAME:	SAN PROFILES
MANAGER:	J. LUCK
DRAWN BY:	C. KEMPNEY

NOTES / REVISIONS
ISSUED: 2/7/2012

PROPOSED REDESIGN SANITARY SEWER PROFILES
Sheet 142 revised