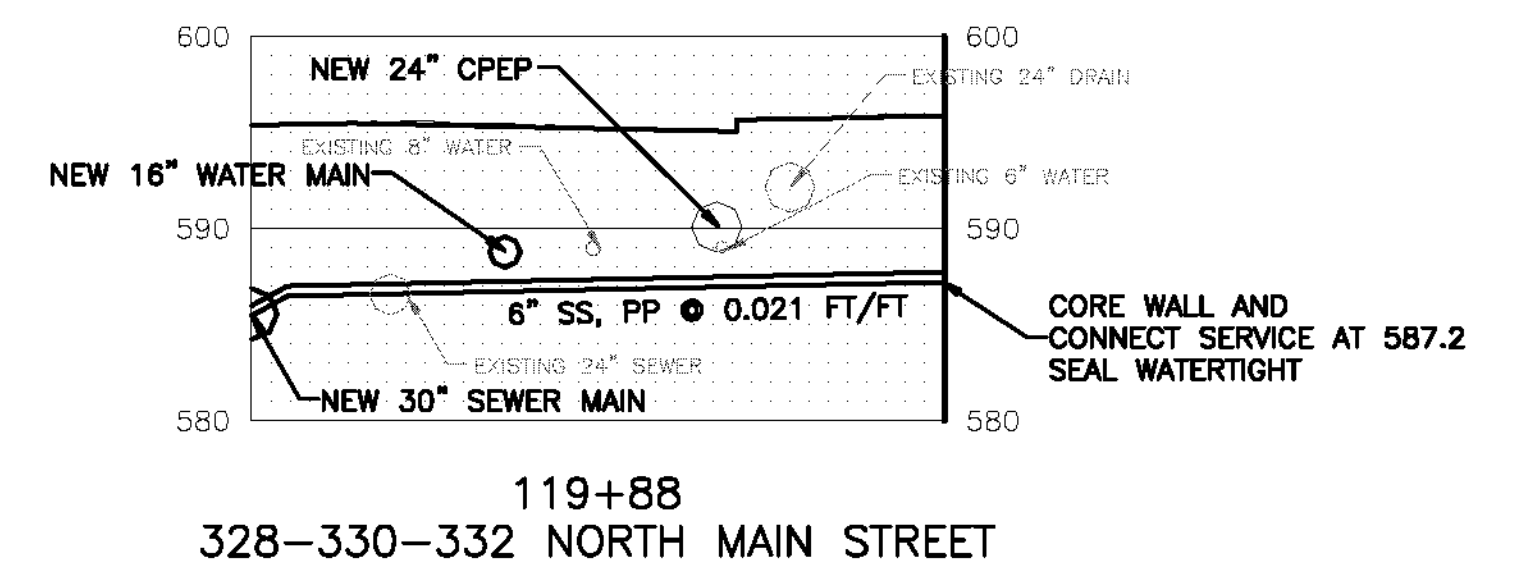
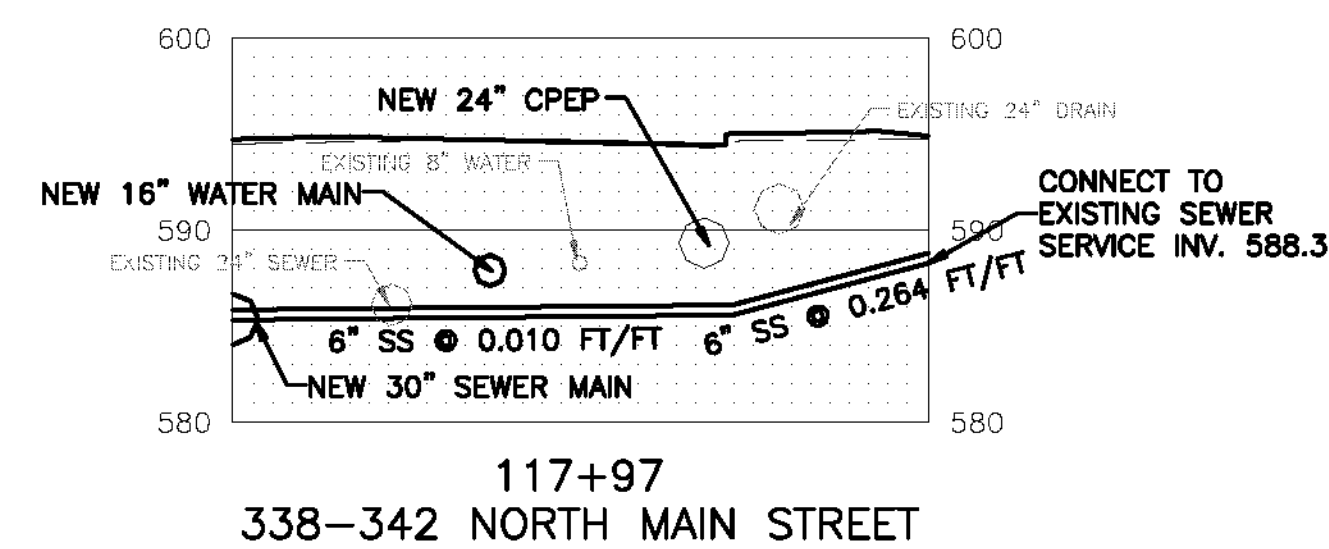
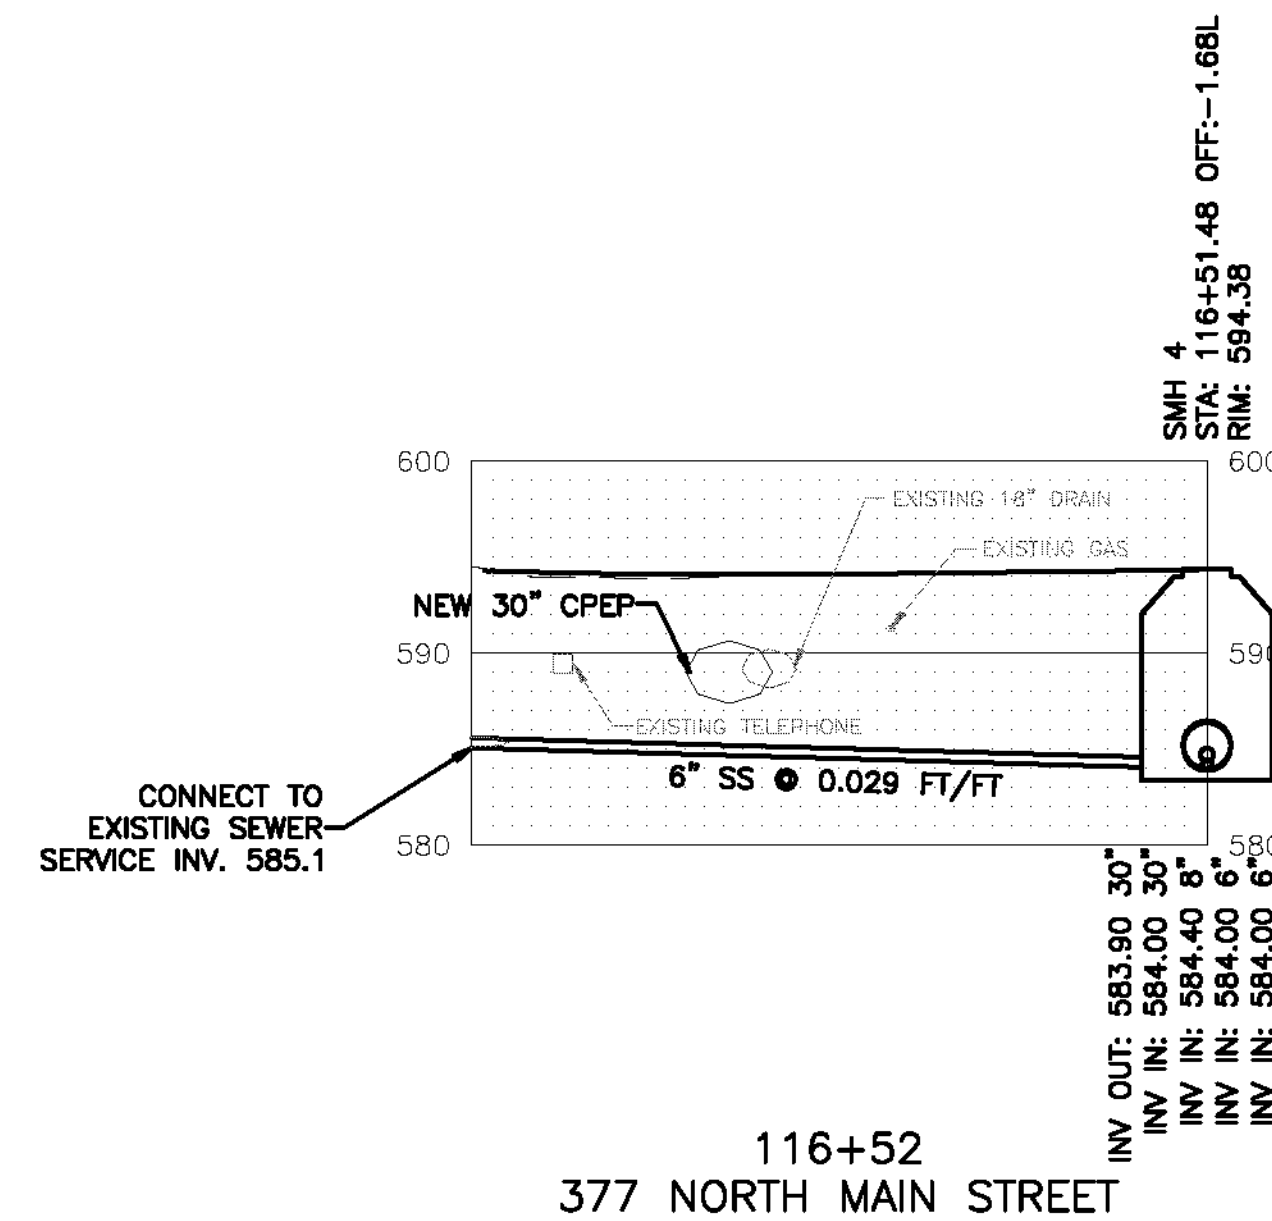
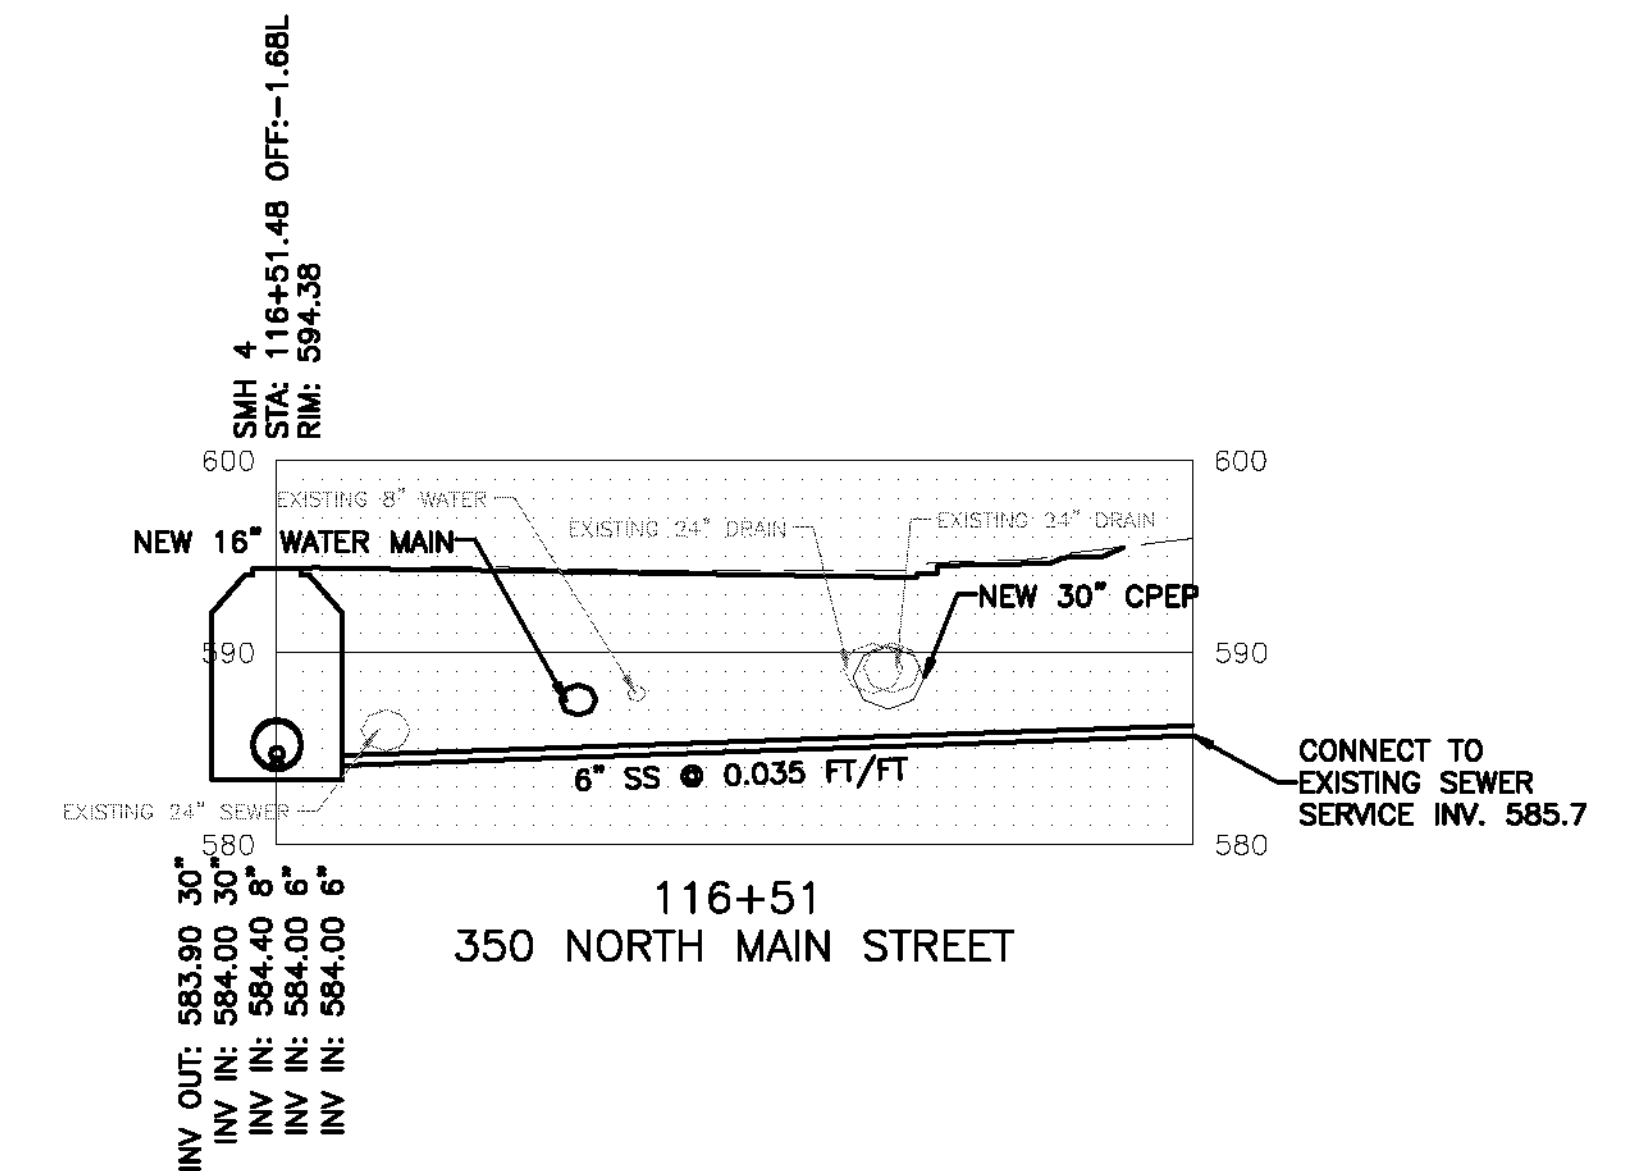
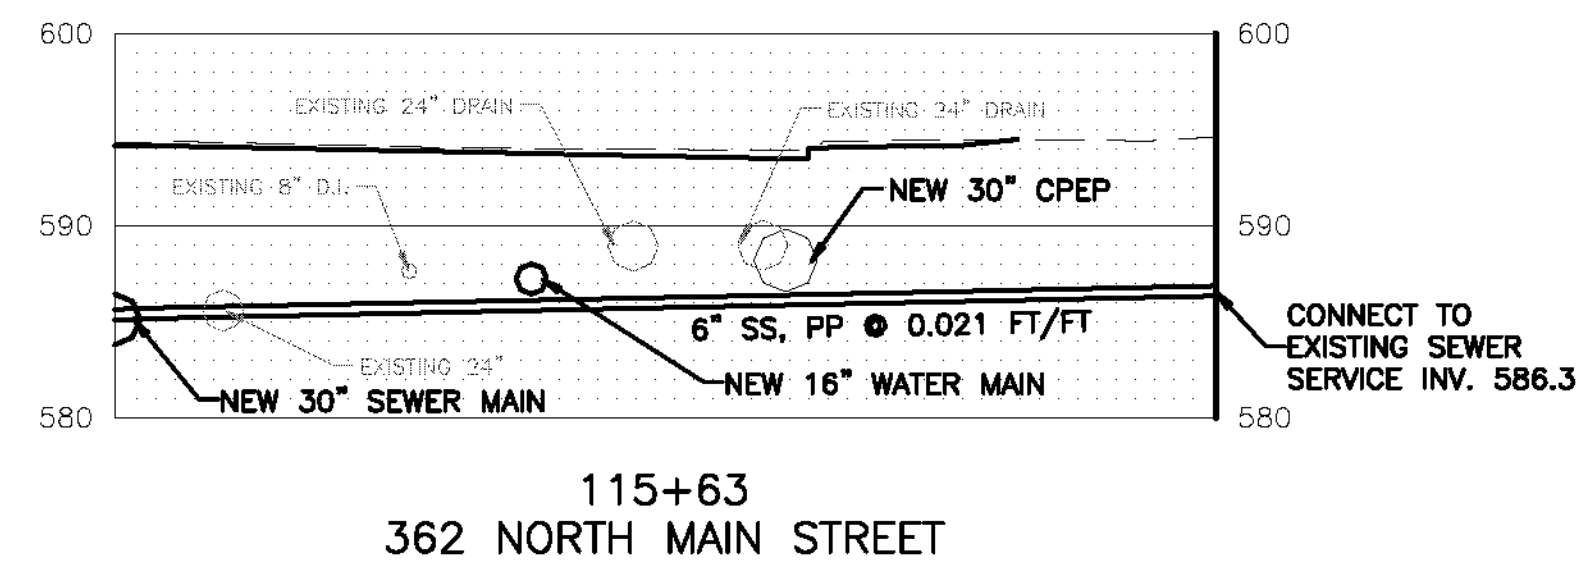
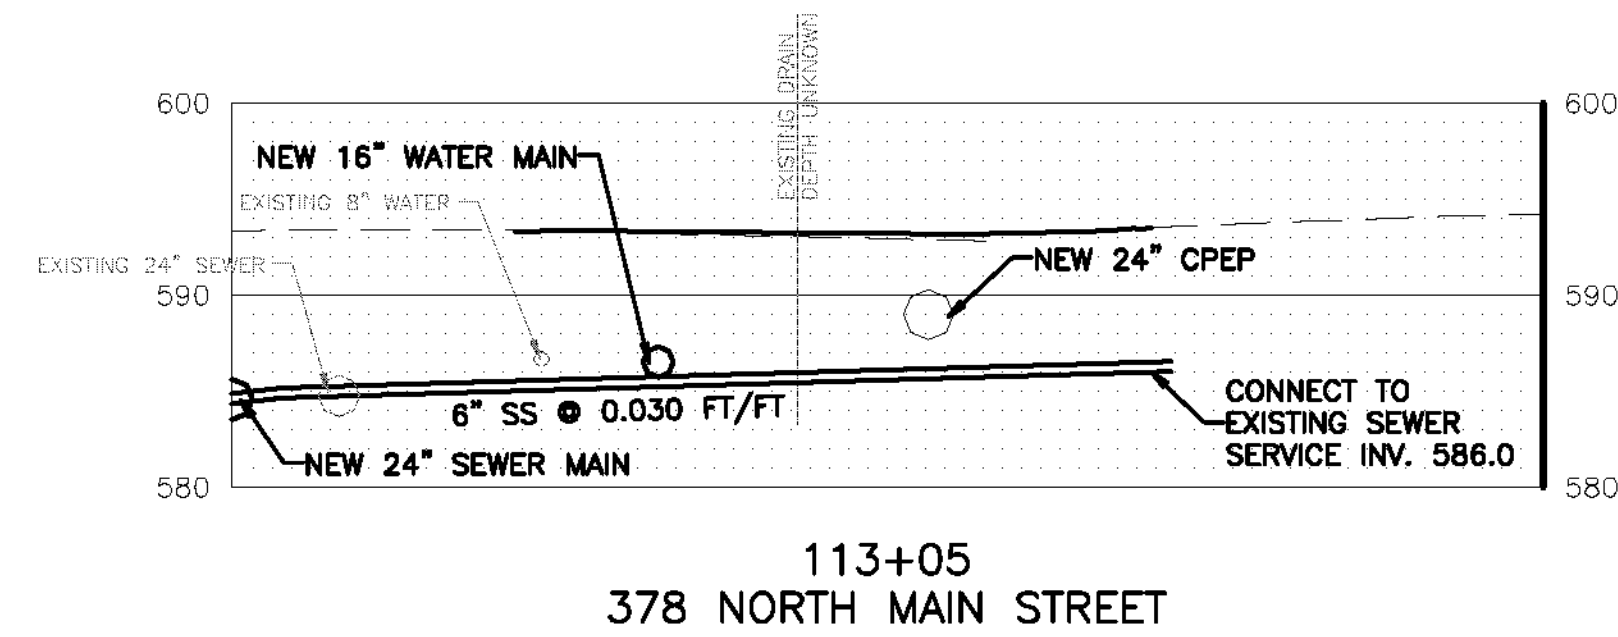
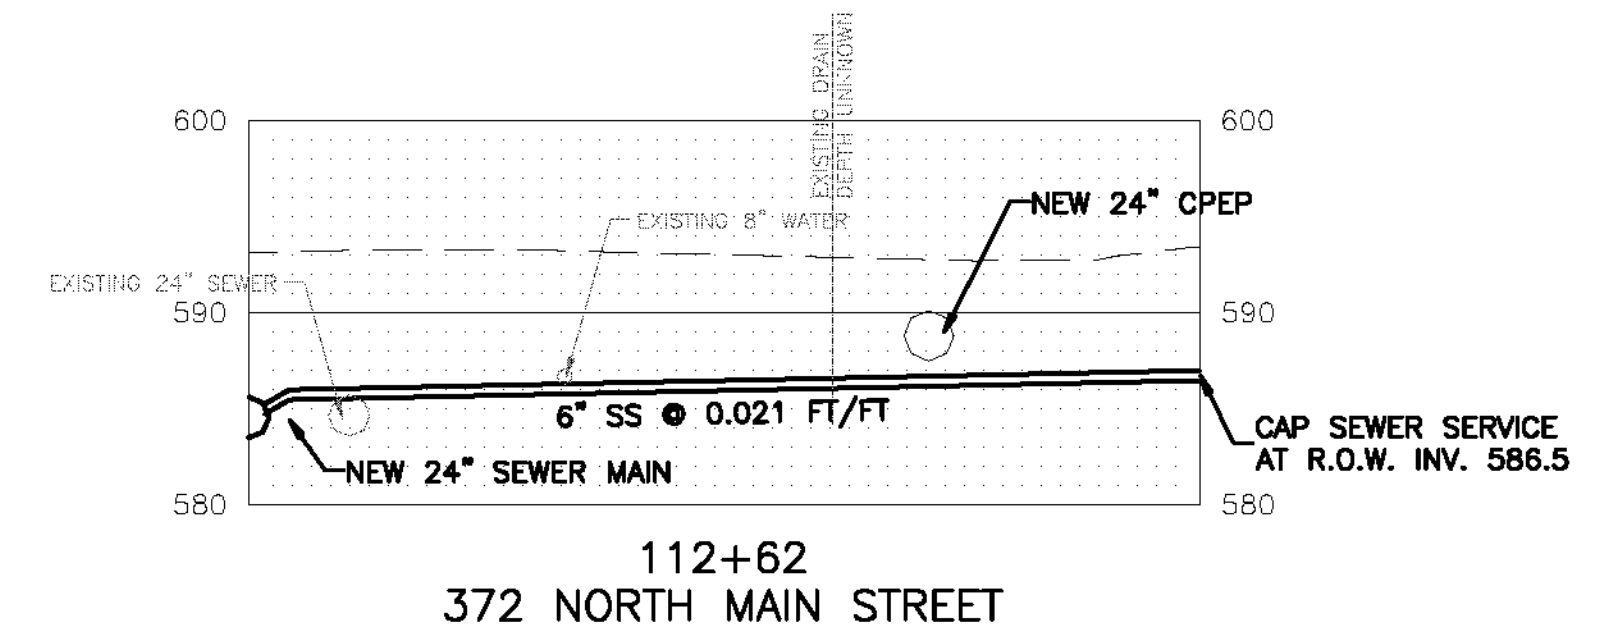
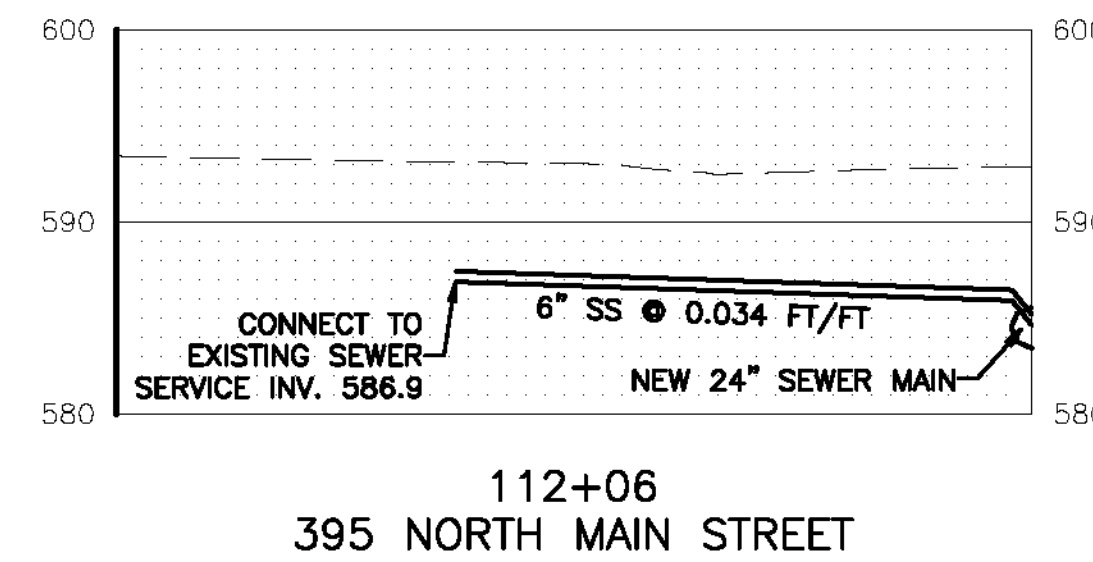
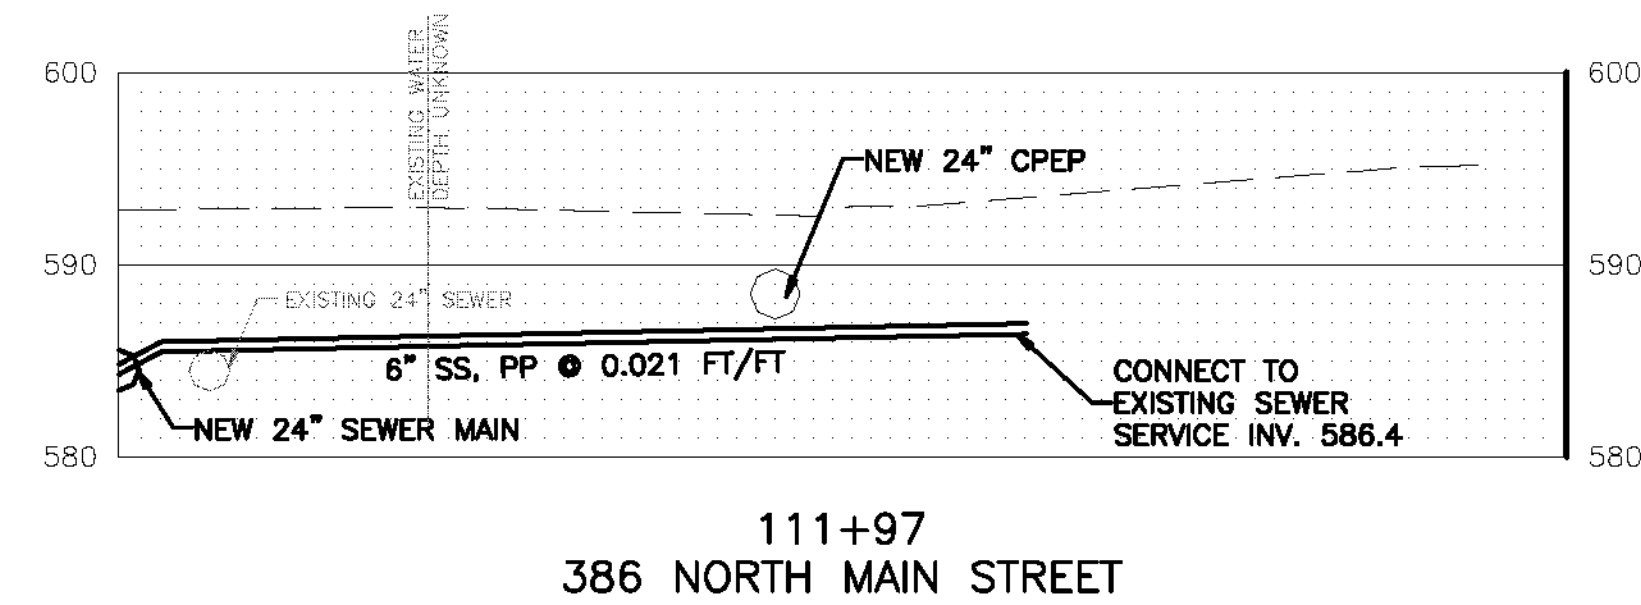


 DUFRESNE GROUP CONSULTING ENGINEERS *** Dufresne Group is owned by Dufresne & Associates, PC	PROJECT NAME: BARRE CITY PROJECT NUMBER: FEGC F 026-1(34) C/2	
	FILE NAME: 717014-SERVICES PROJECT LEADER: R.E. DUFRESNE DESIGNED BY: B.L. BAKER SEWER SERVICE PROFILES	PLOT DATE: Feb. 18, 11 DRAWN BY: B.L. BAKER CHECKED BY: C.L. WHITFHEAD SHEET 144 OF 339