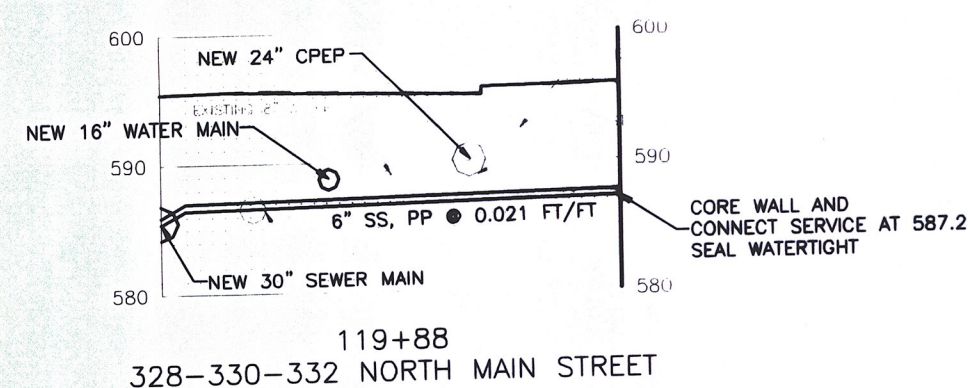
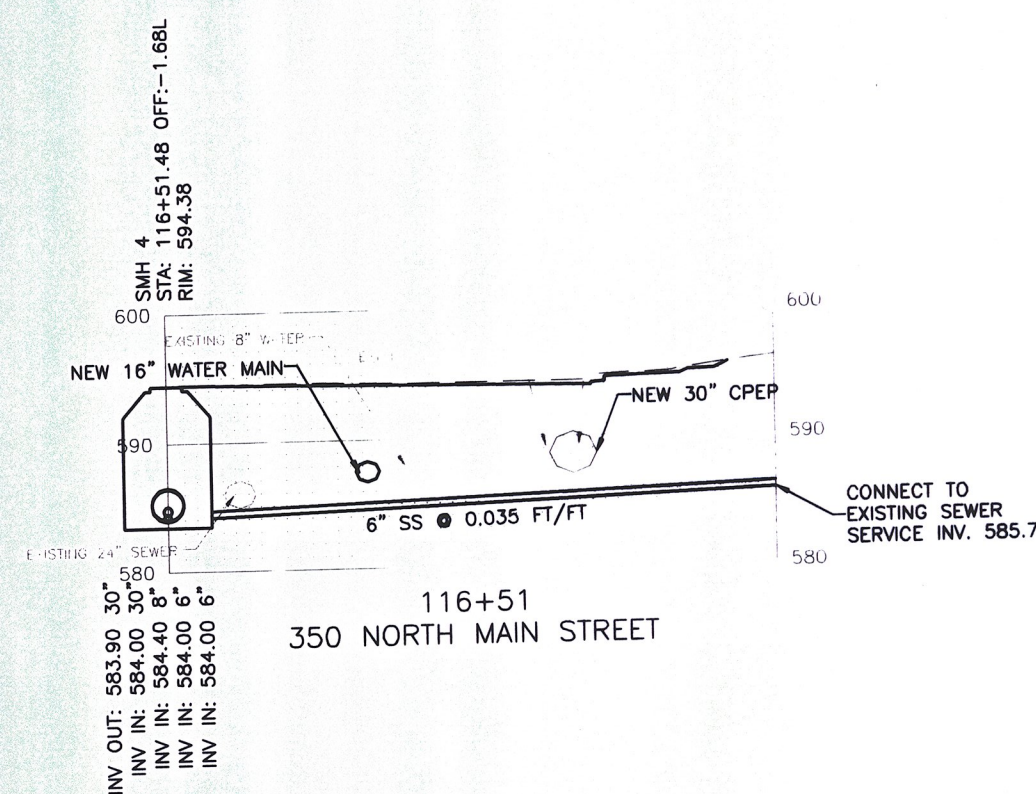
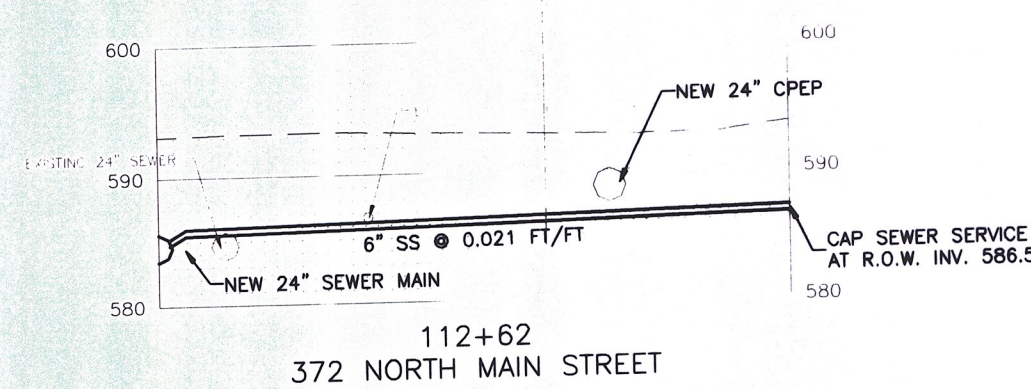
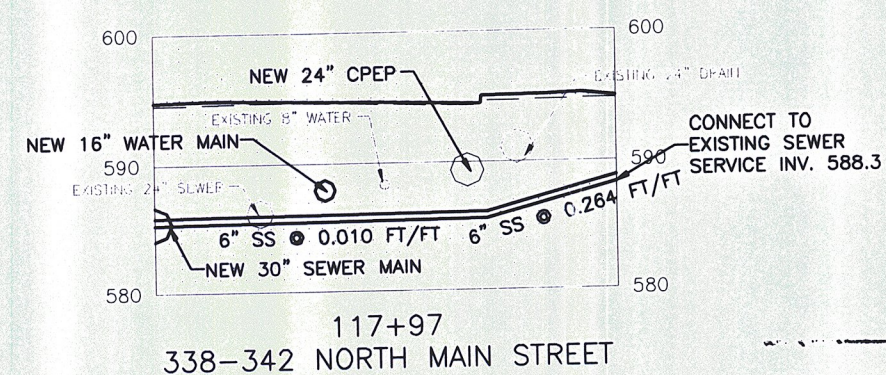
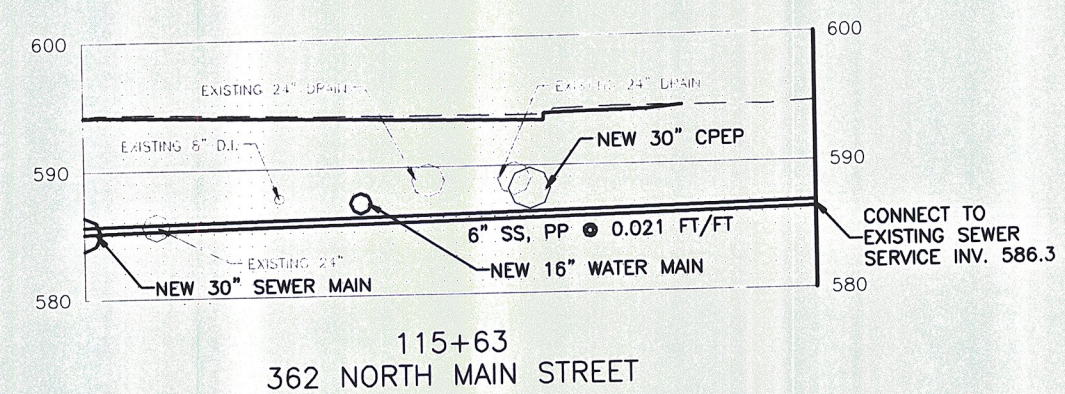
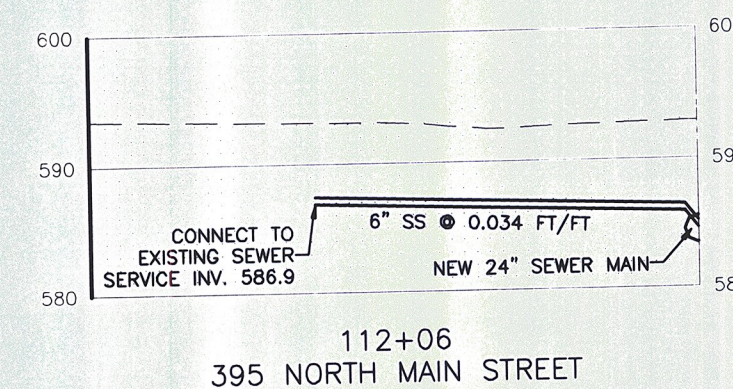
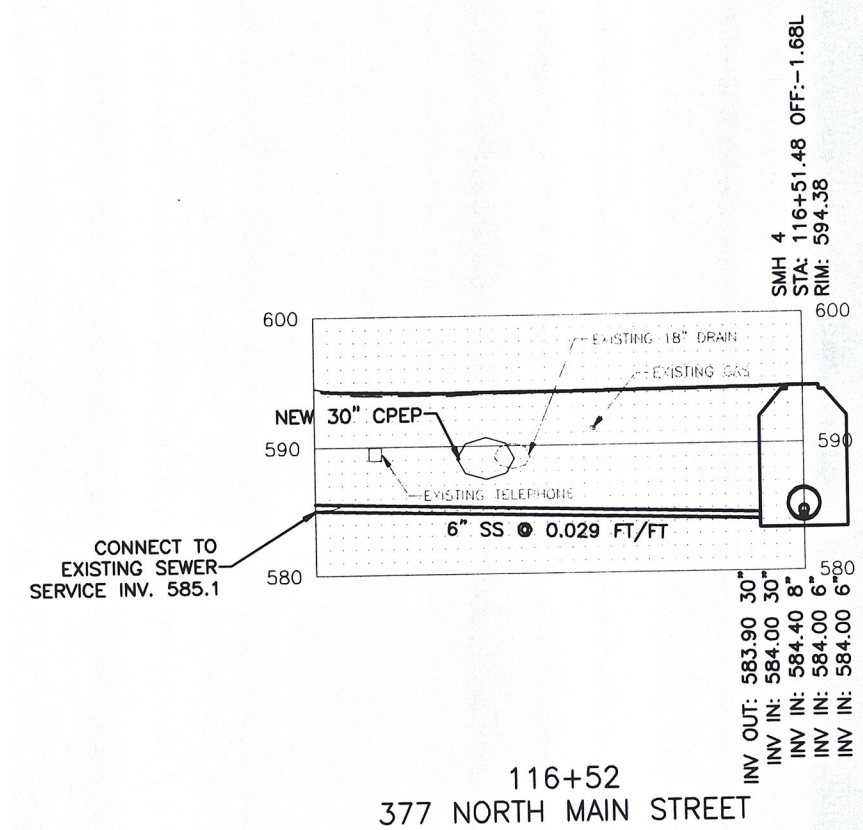
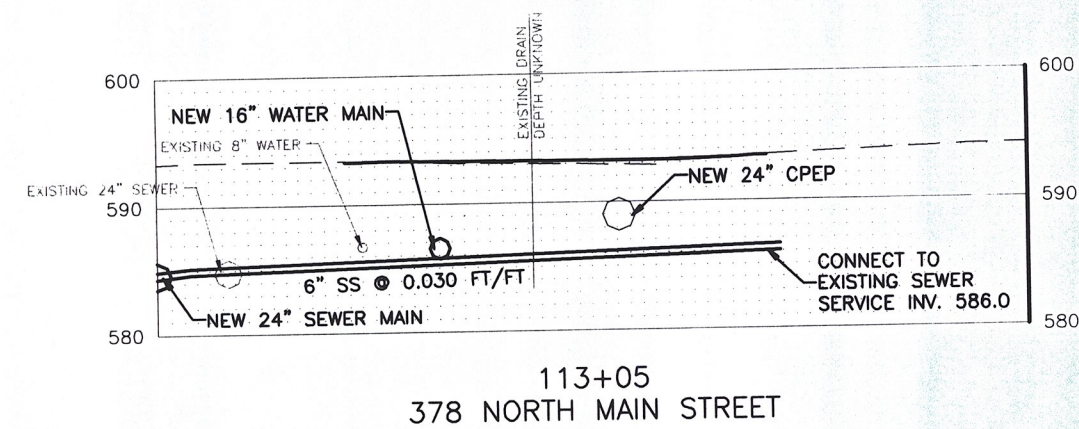
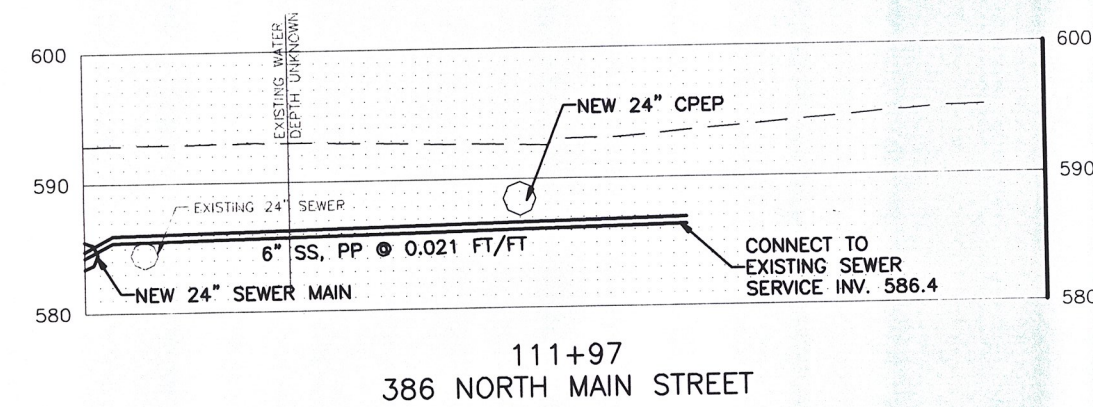


PROJECT NAME:	BARRE CITY	NOTES / REVISIONS
PROJECT NUMBER:	FECC F 026-1(34) C/2	ISSUED: 2/7/2012
FILE NAME:	SAN PROFILES	
MANAGER:	J. LUCK	
DRAWN BY:	C. KEMPNEY	
PROPOSED REDESIGN SANITARY SEWER PROFILES		
Sheet "174 Revised"		