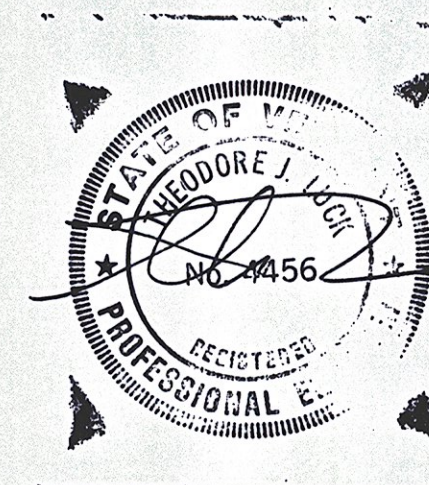
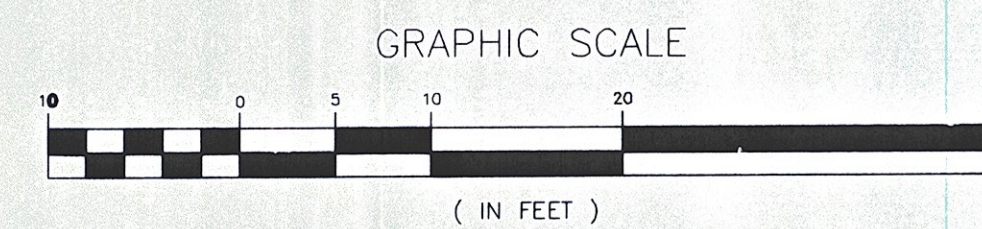
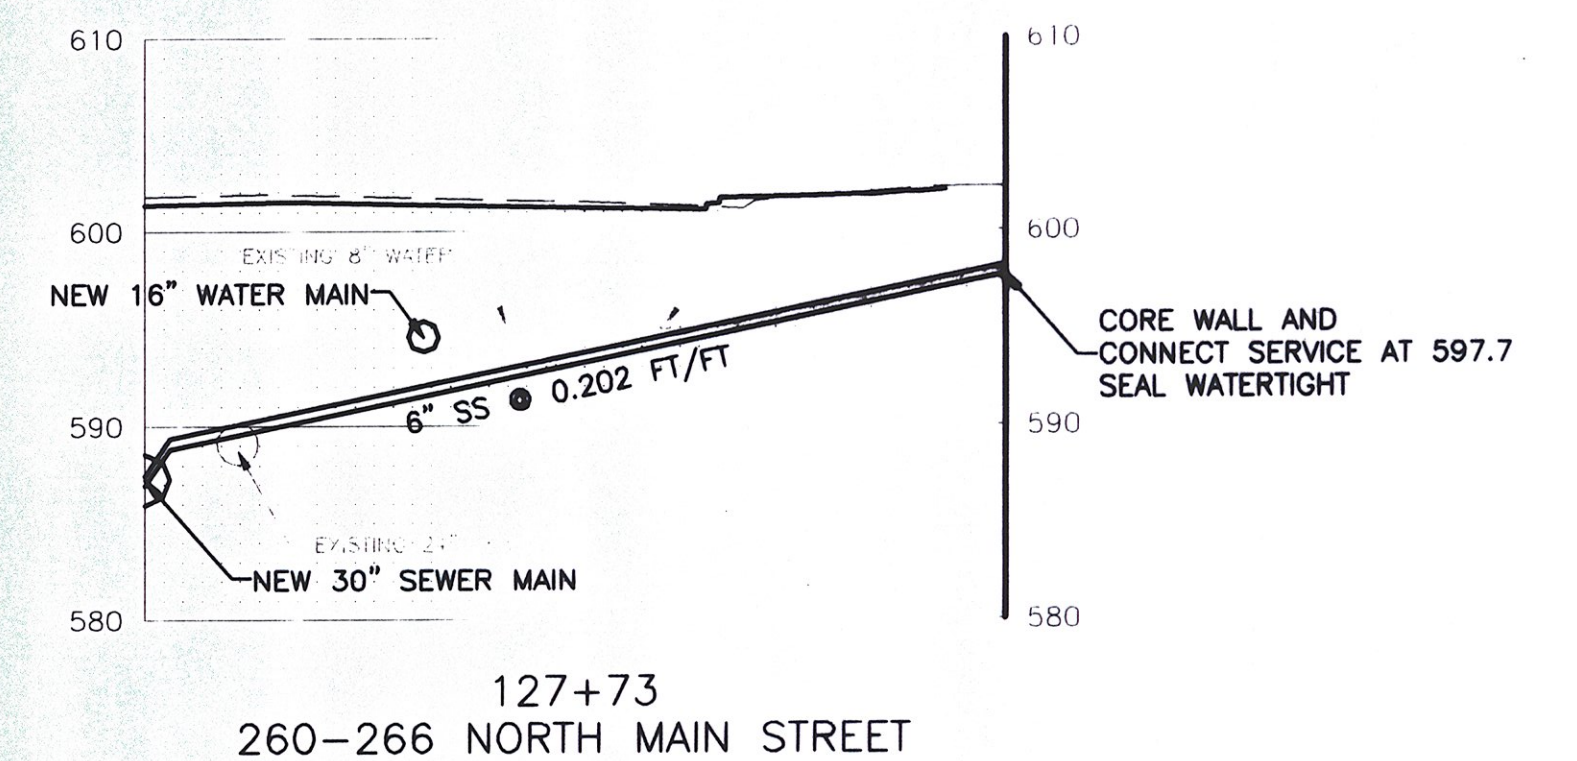
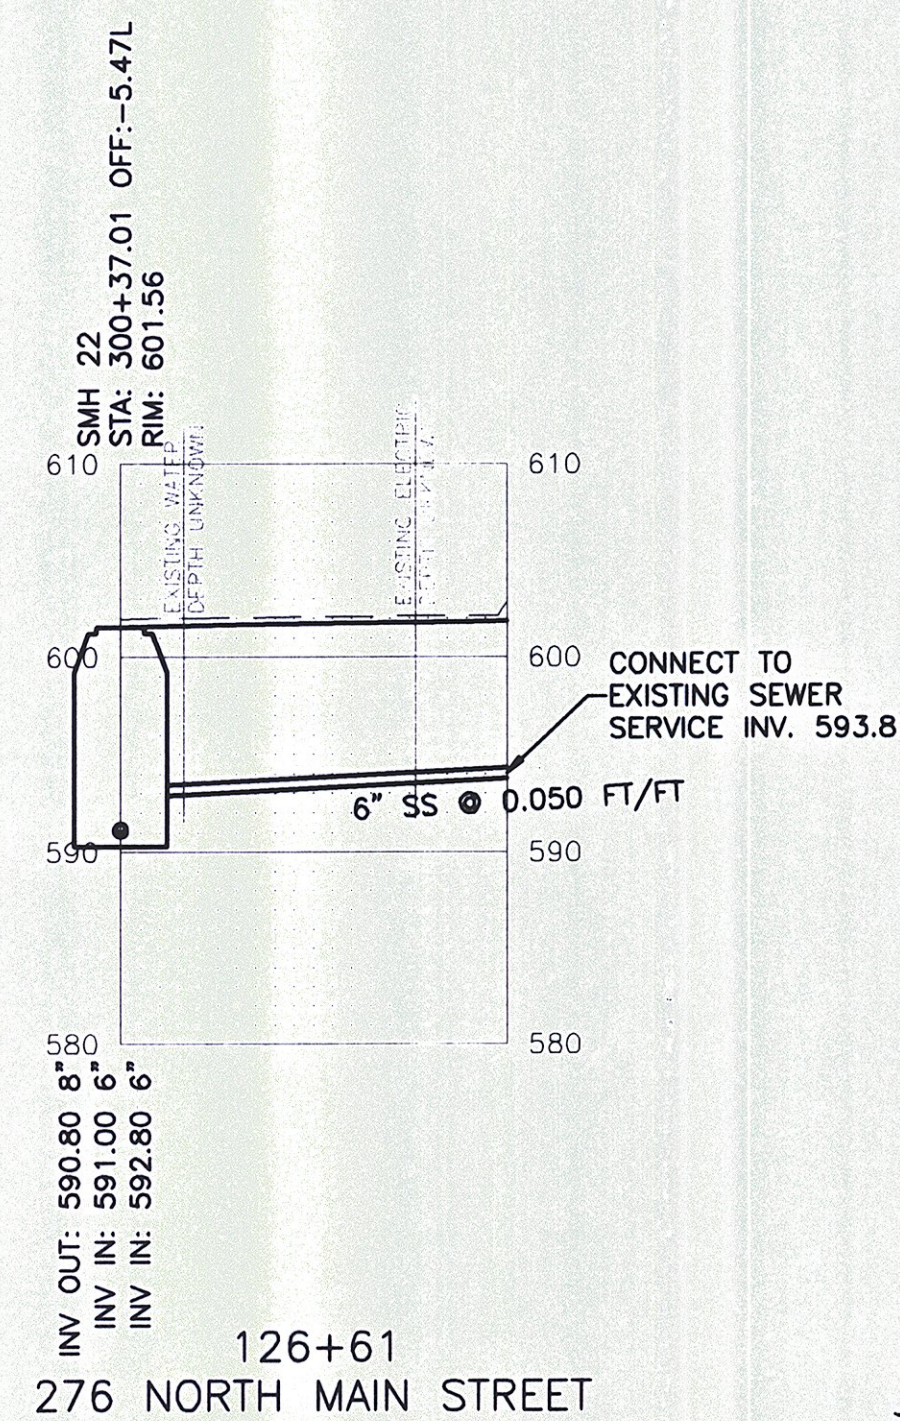
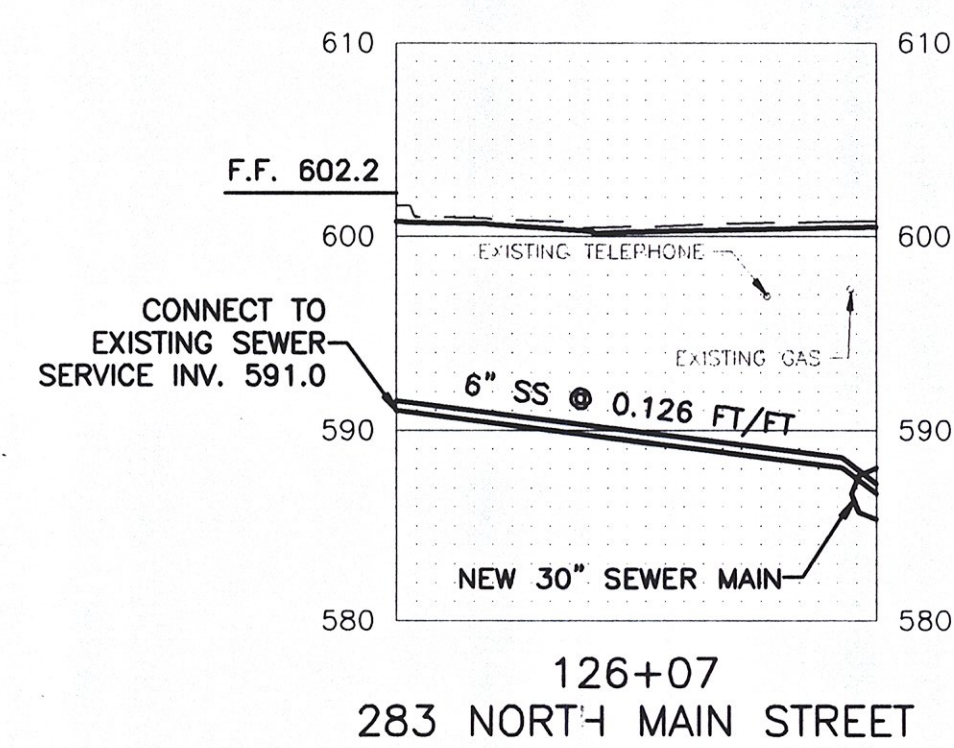
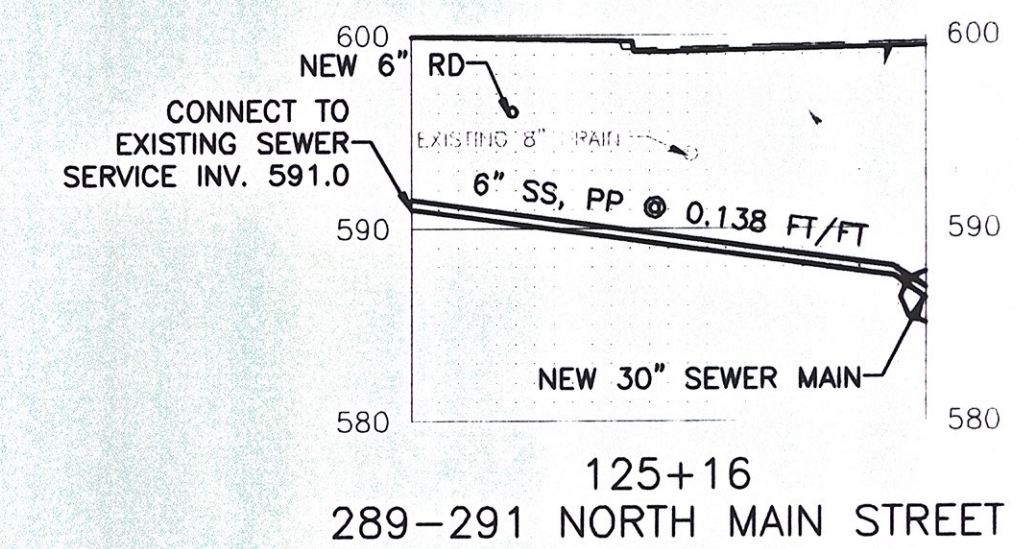
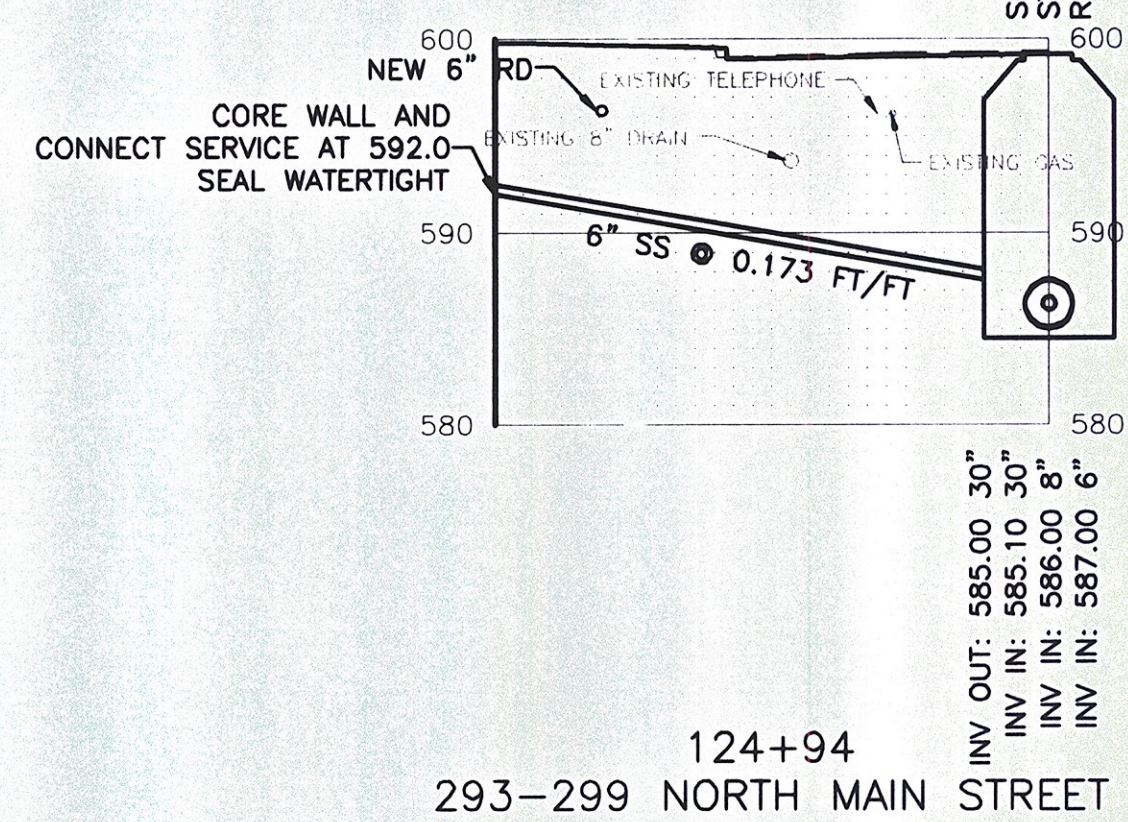
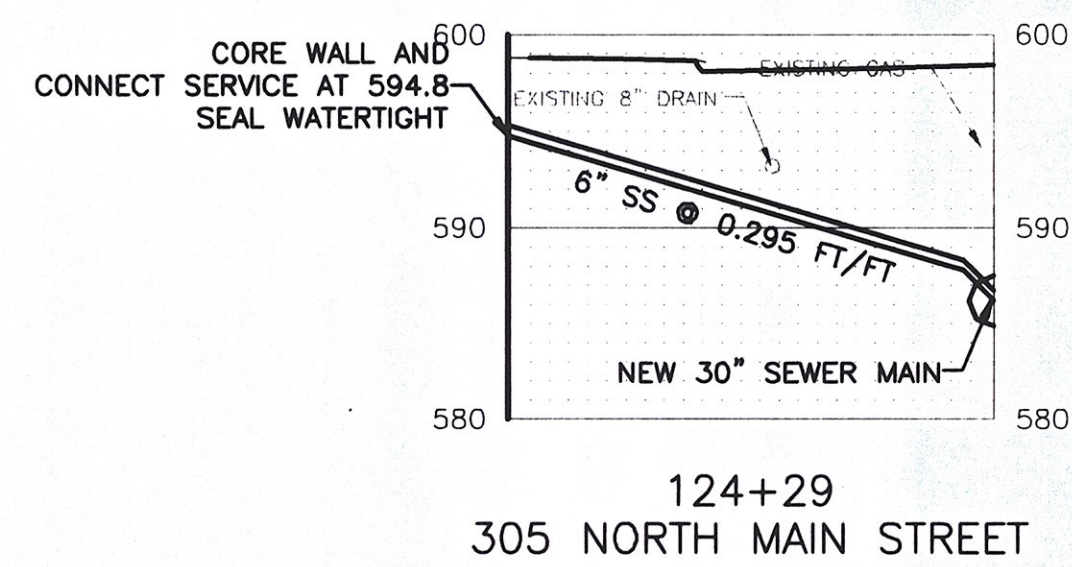
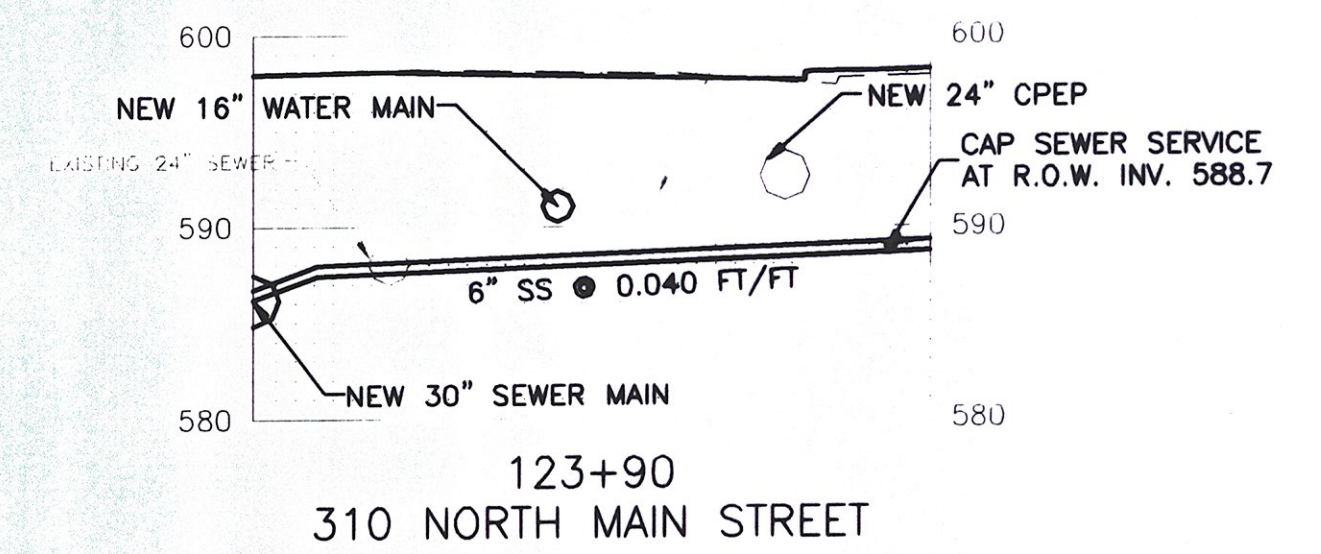
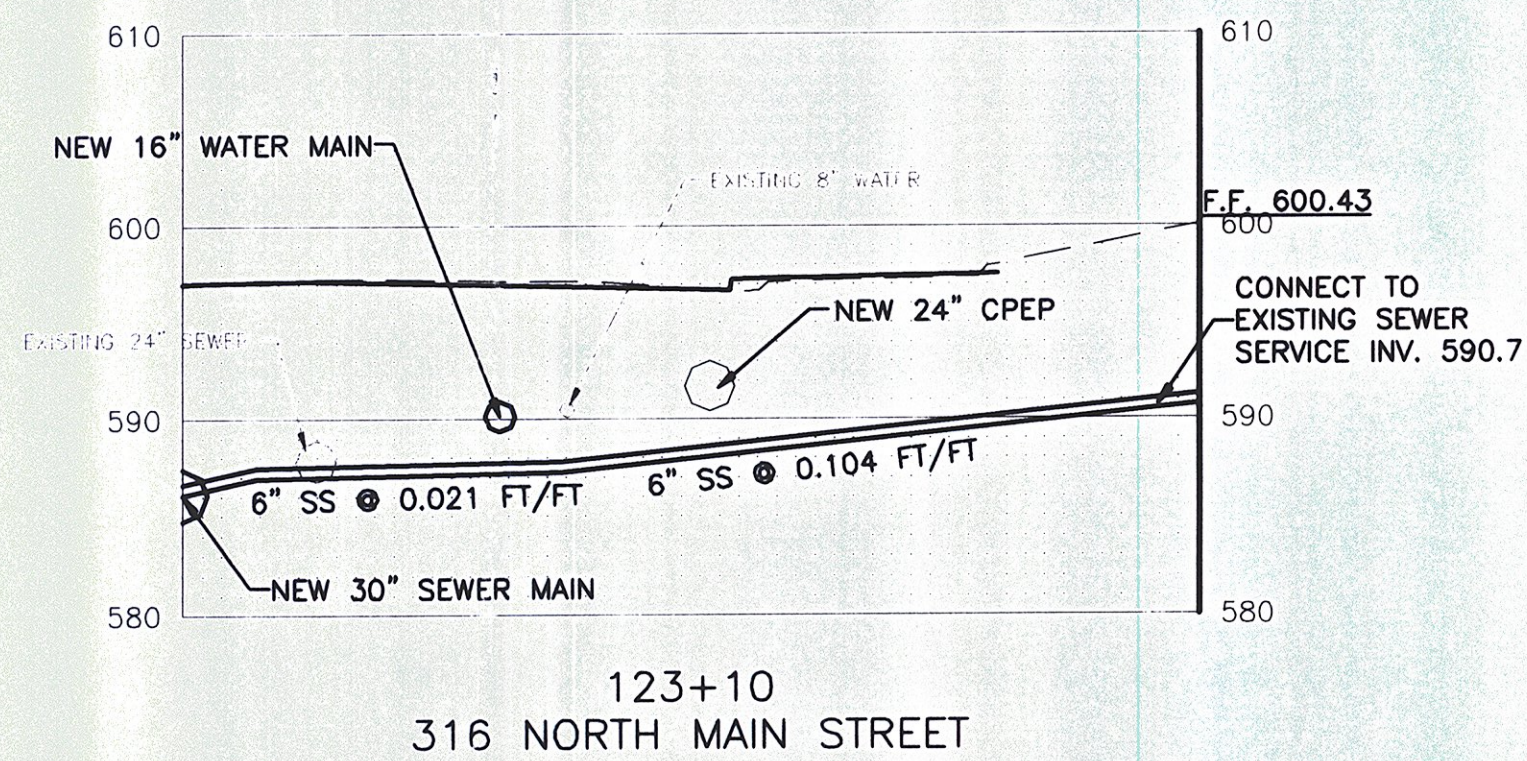
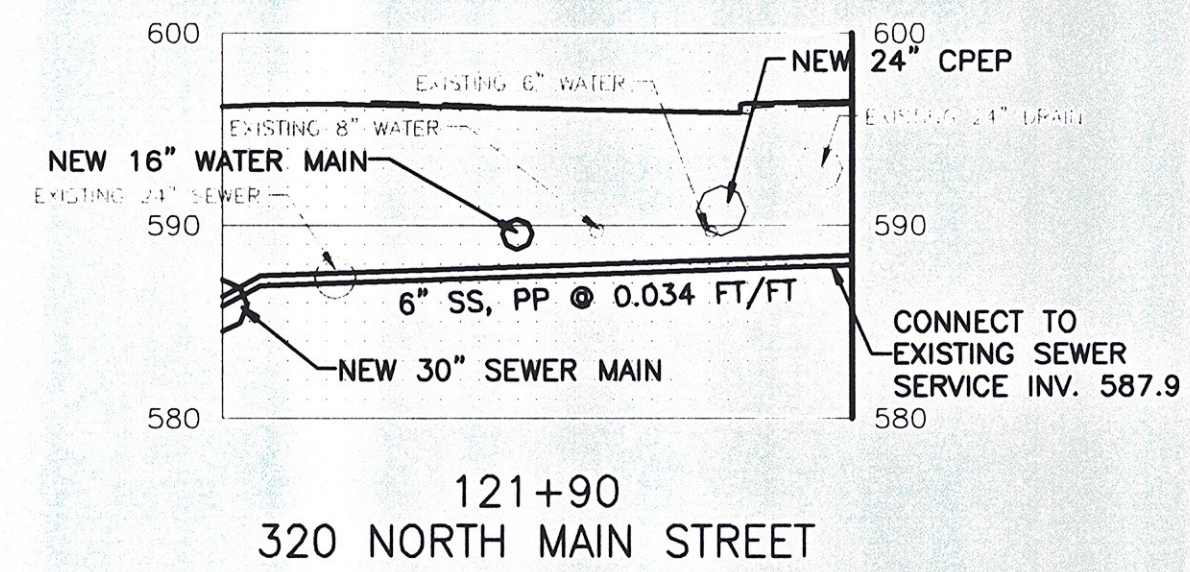
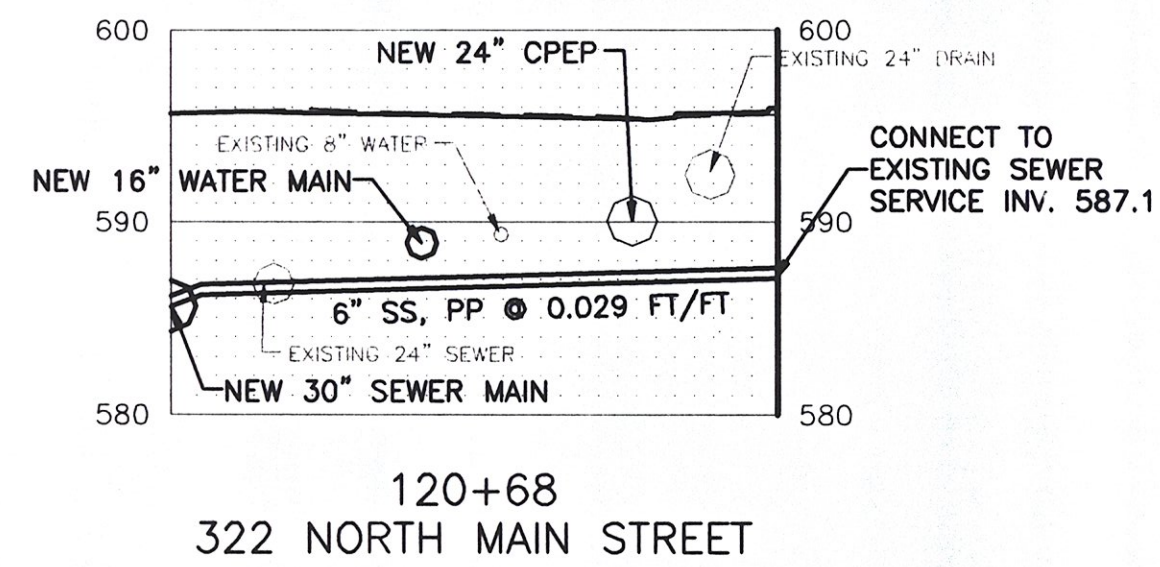


|                                           |                      |                   |
|-------------------------------------------|----------------------|-------------------|
| PROJECT NAME:                             | BARRE CITY           | NOTES / REVISIONS |
| PROJECT NUMBER:                           | FEGC F 026-1(34) C/2 |                   |
| FILE NAME:                                | SAN PROFILES         |                   |
| MANAGER:                                  | J. LUCK              |                   |
| DRAWN BY:                                 | C. KEMPNEY           |                   |
| PROPOSED REDESIGN SANITARY SEWER PROFILES |                      | ISSUED: 2/7/2012  |
|                                           |                      |                   |
|                                           |                      |                   |
|                                           |                      |                   |
|                                           |                      |                   |

Sheet 145 revised