




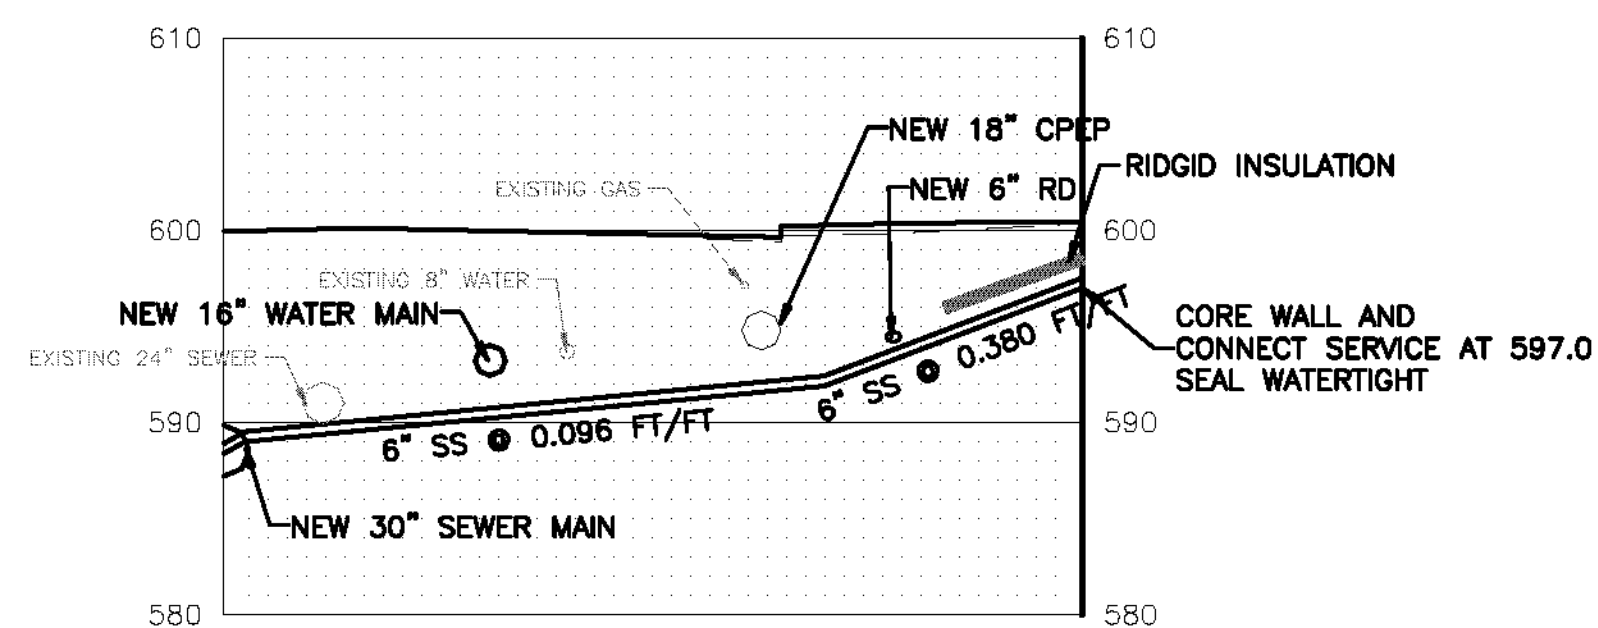


131+13
200 NORTH MAIN STREET

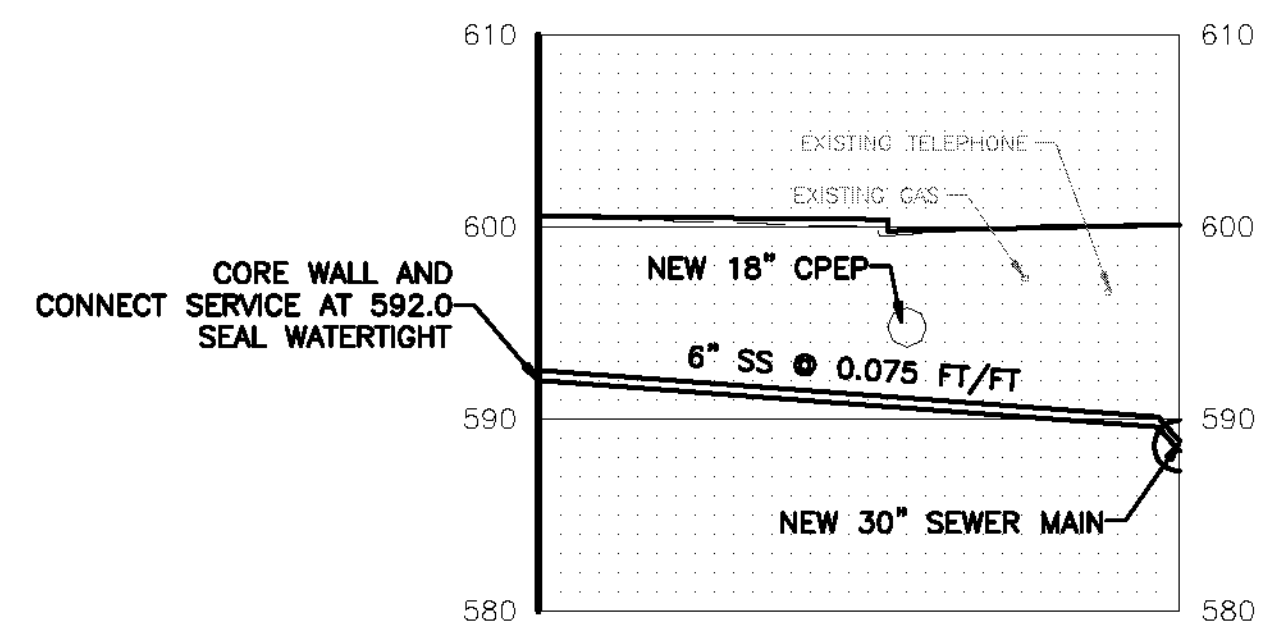


131+57
185-189 NORTH MAIN STREET

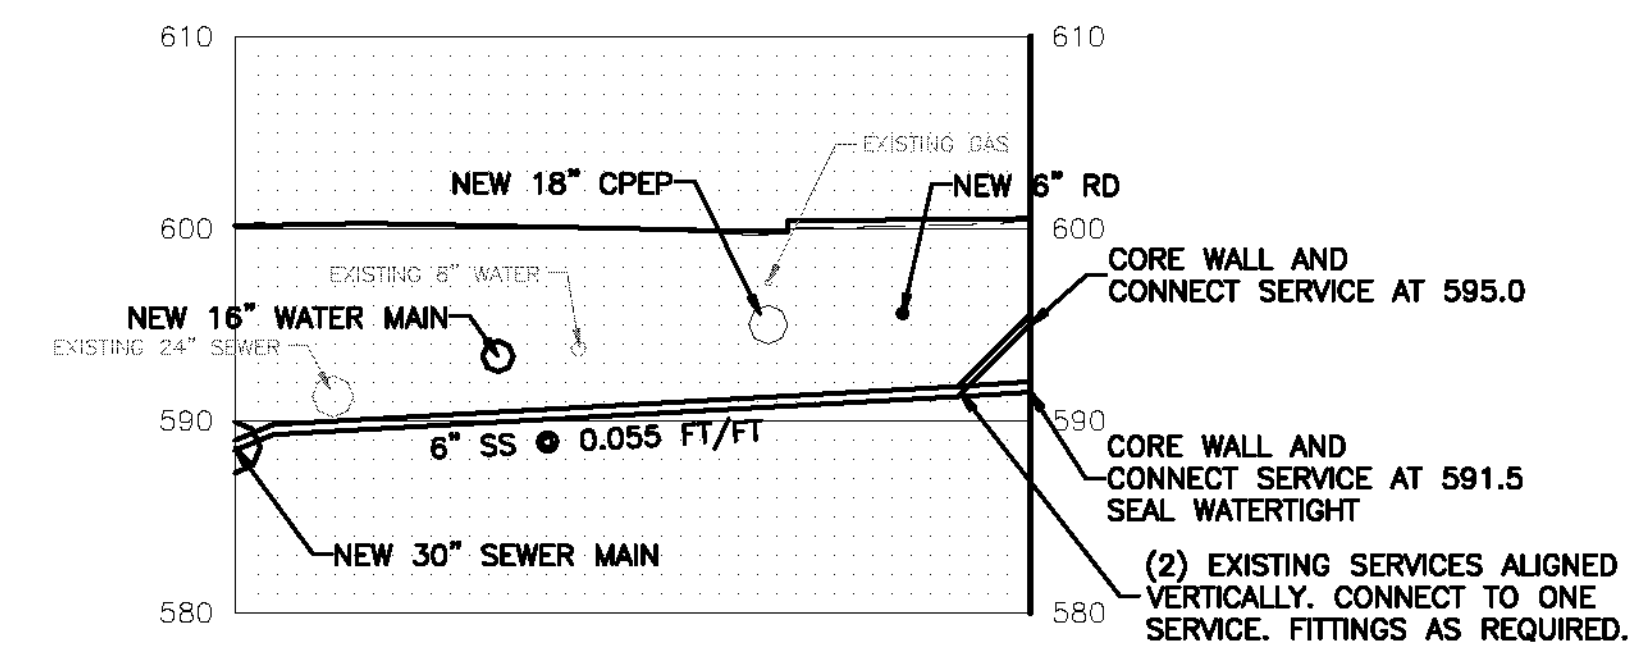


131+67
188-194 NORTH MAIN STREET

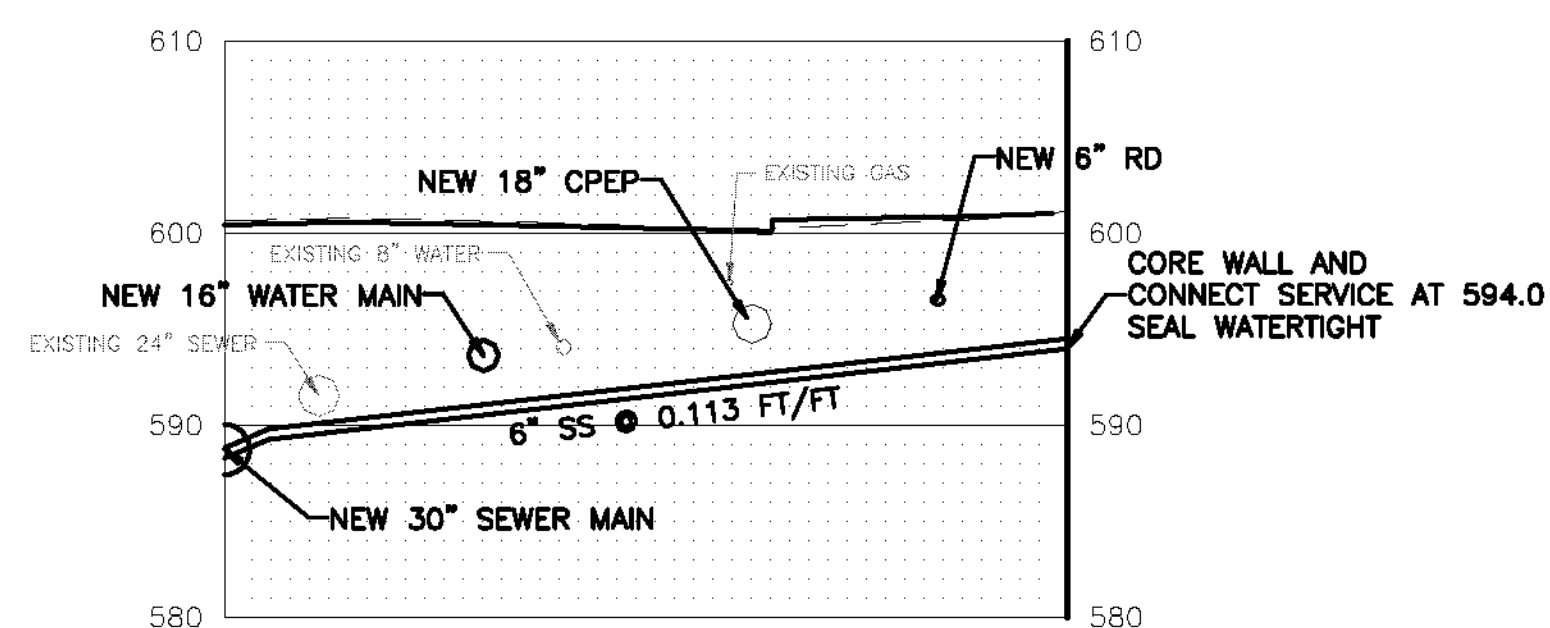


132+37
180-186 NORTH MAIN STREET

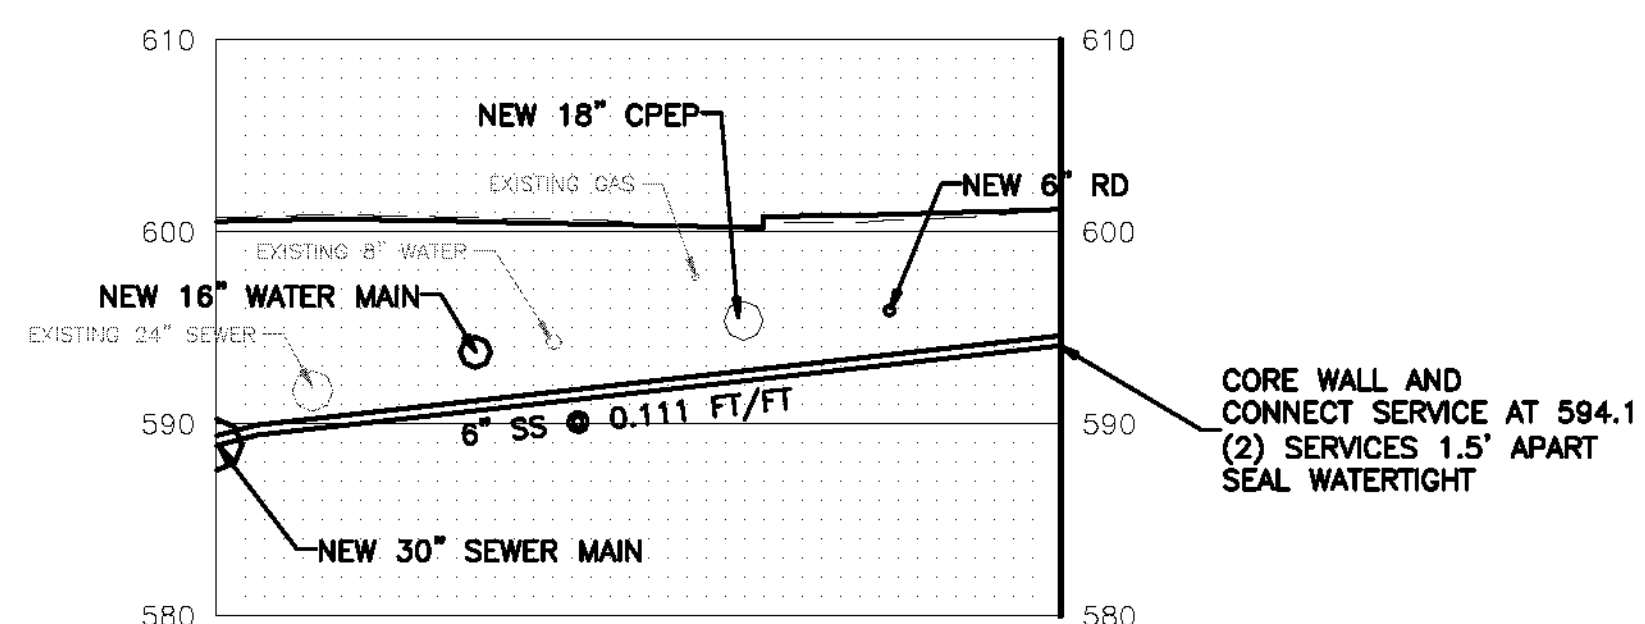


132+65
170-174 NORTH MAIN STREET

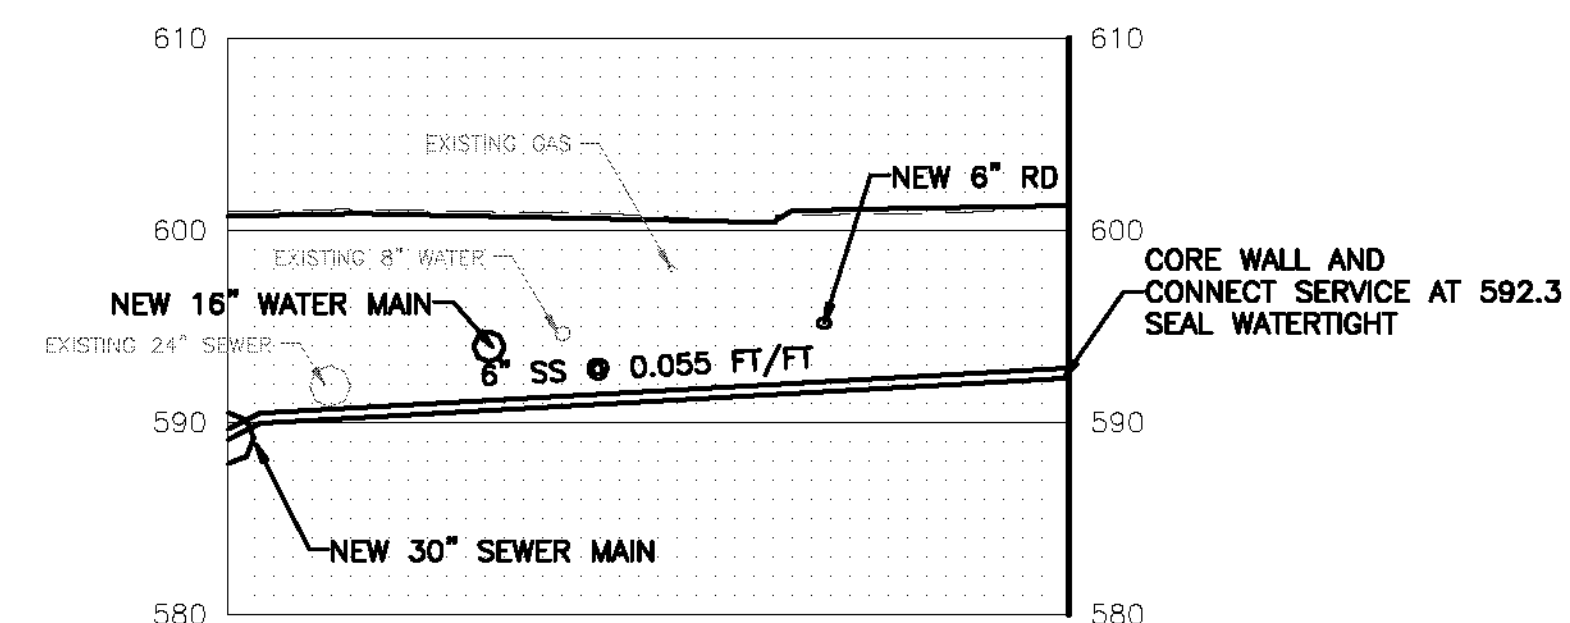


133+09
168 NORTH MAIN STREET

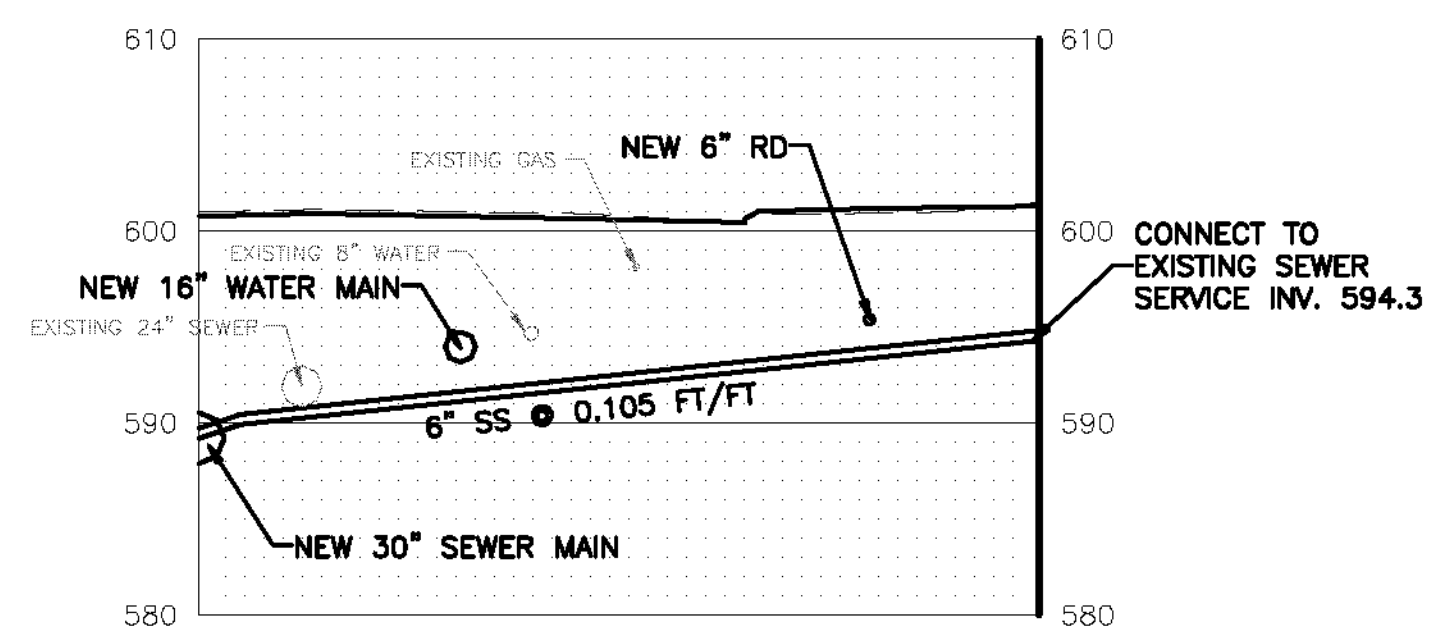


133+17
158-166 NORTH MAIN STREET

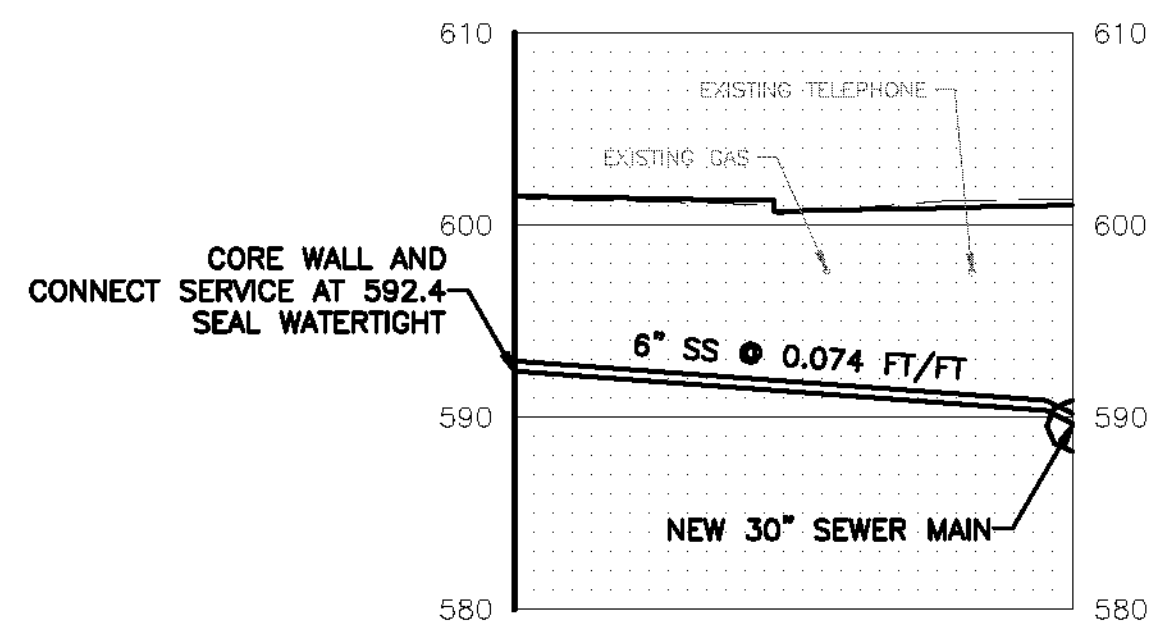

133+78
143-151 NORTH MAIN STREET

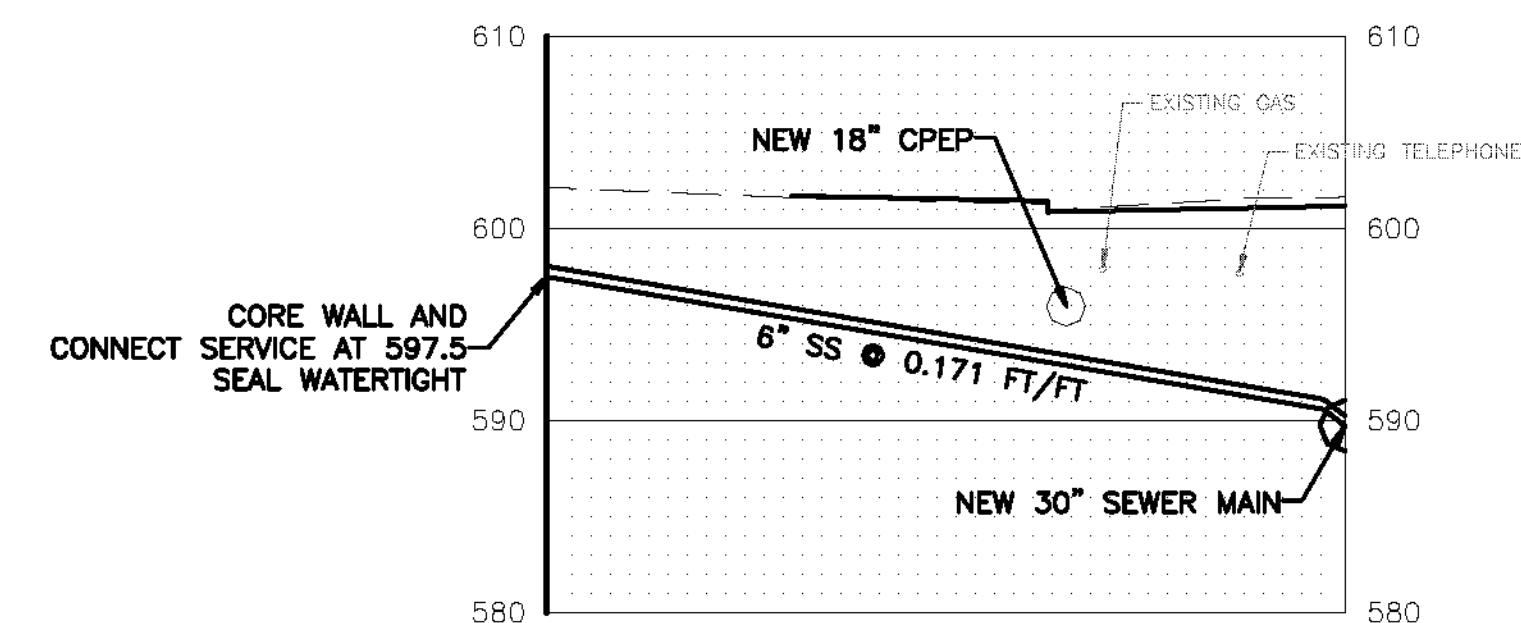

134+06
135 NORTH MAIN STREET

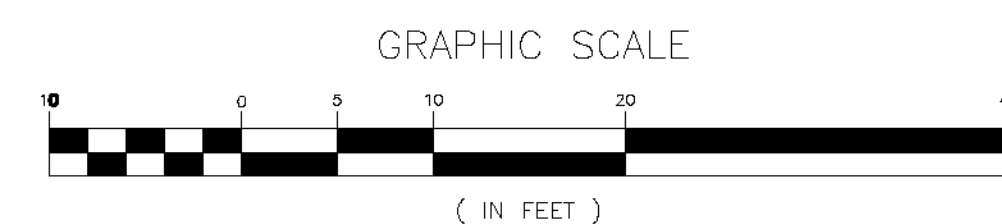

DUFRESNE GROUP
CONSULTING ENGINEERS
Dufresne Group is owned by Dufresne & Associates, PC

PROJECT NAME: BARRE CITY
PROJECT NUMBER: FEGC F 026-1(34) C/2

FILE NAME: 717014-SERVICES
PROJECT LEADER: R.E. DUFRESNE
DESIGNED BY: B.L. BAKER
SEWER SERVICE PROFILES

PLOT DATE: Feb. 18, 11
DRAWN BY: B.L. BAKER
CHECKED BY: C.L. WHITEHEAD
SHEET 147 OF 339