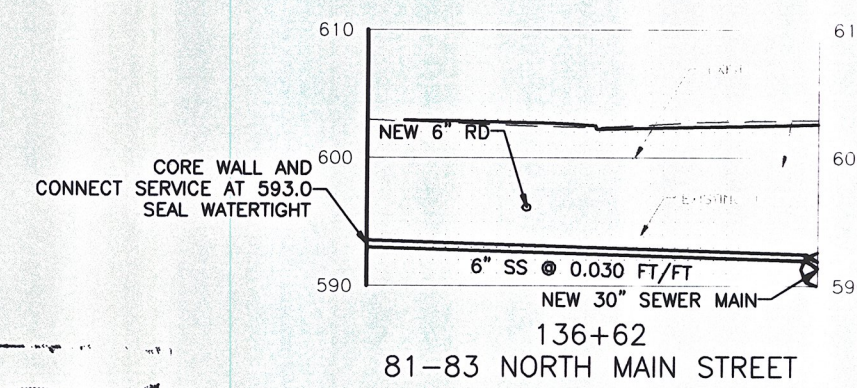
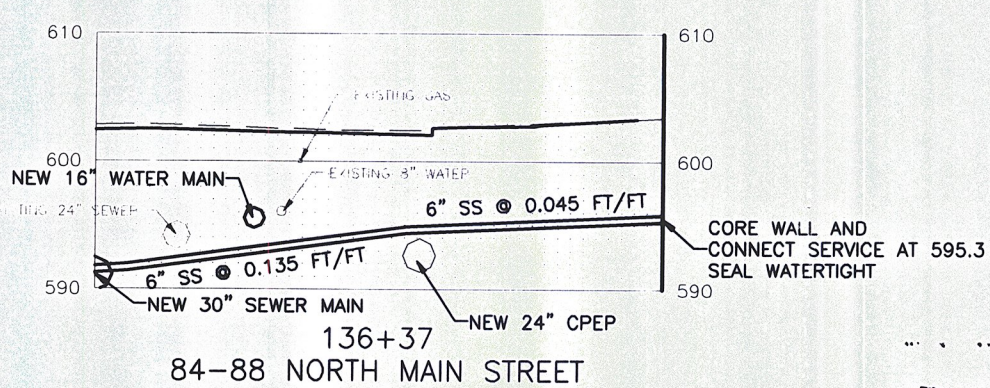
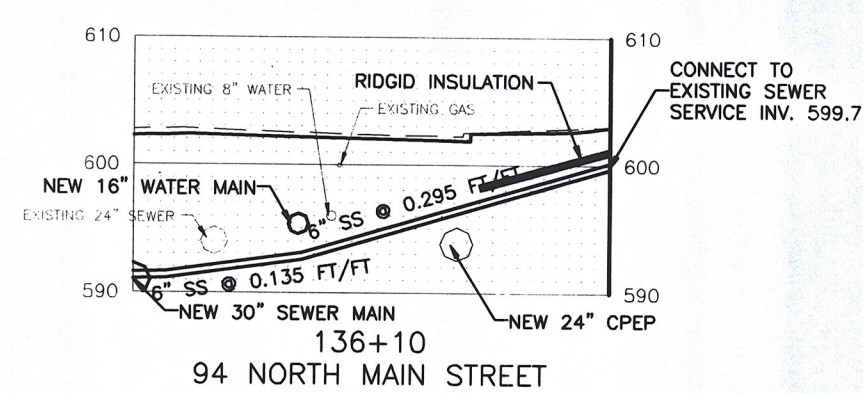
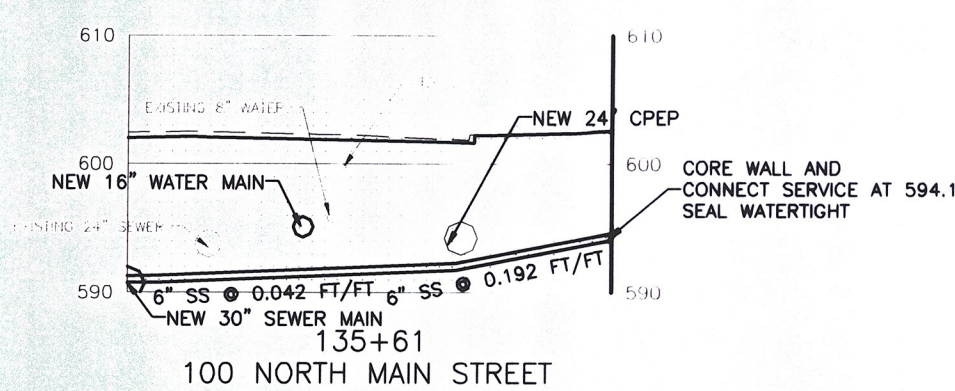
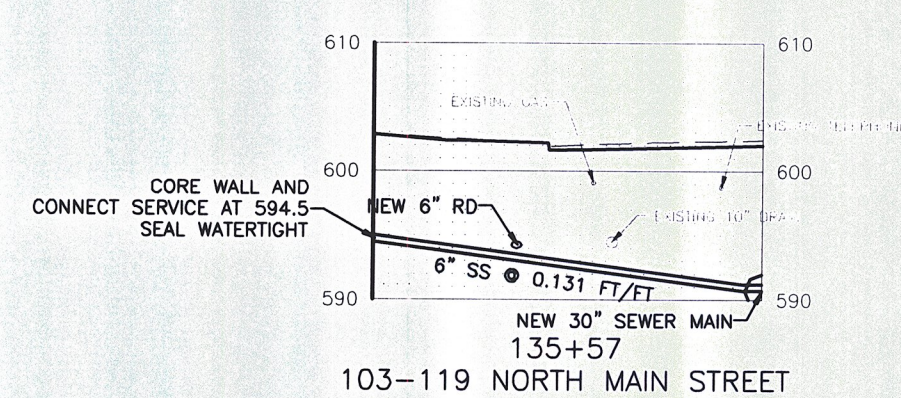
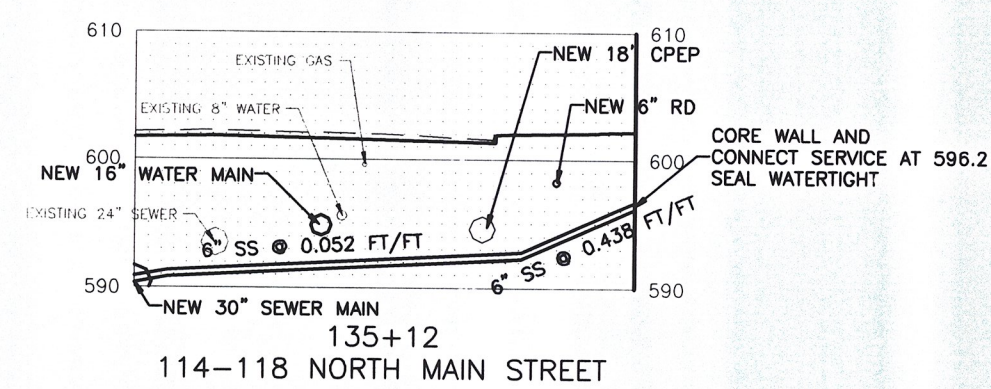
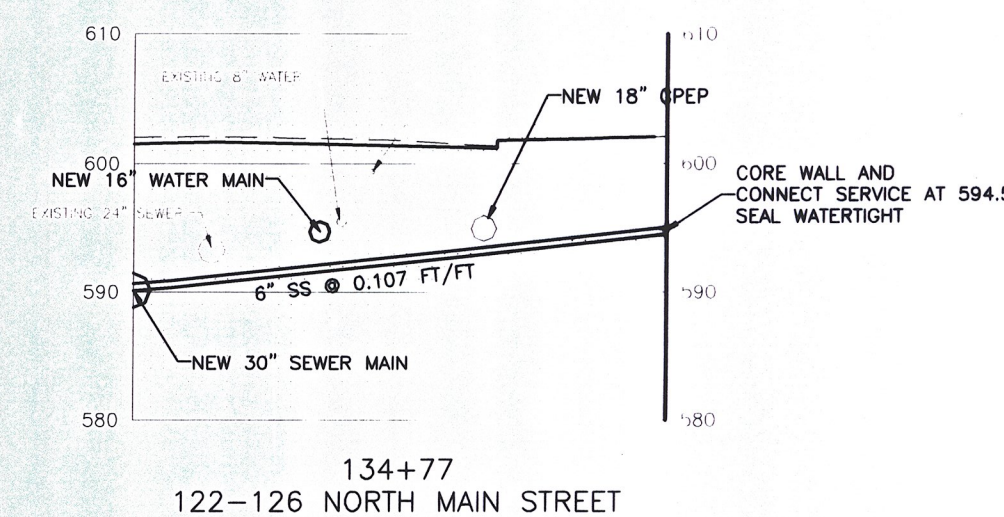
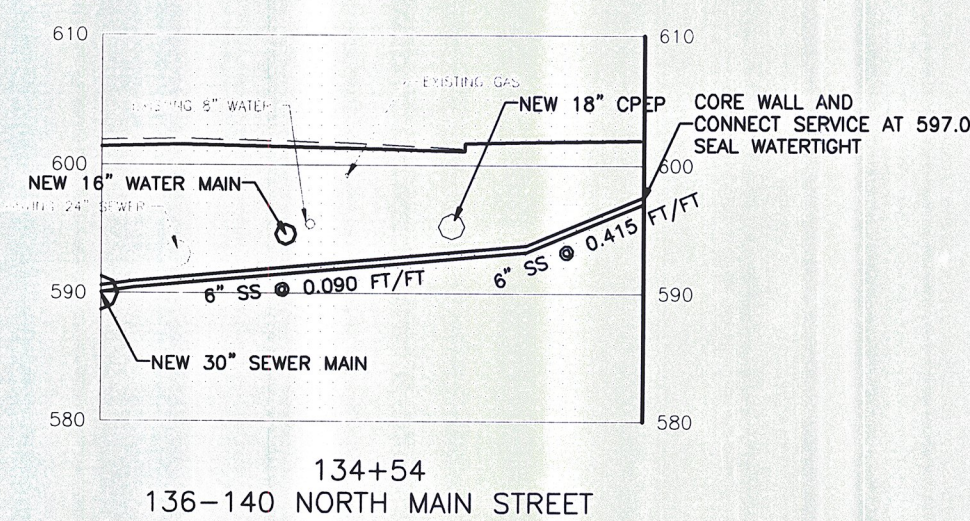
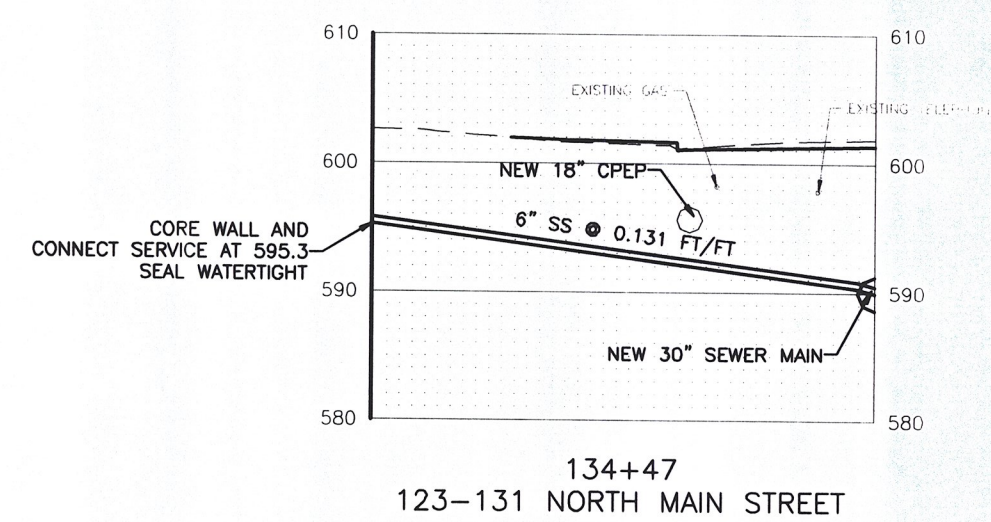


PROJECT NAME: BARRE CITY
PROJECT NUMBER: FE/C F 026-1(34) C/2
FILE NAME: SAN PROFILES
MANAGER: J. LUCK
DRAWN BY: C. KEMPNEY

PROPOSED REDESIGN SANITARY SEWER PROFILES
Sheet 1456 revised

NOTES / REVISIONS	
ISSUED:	2/7/2012