




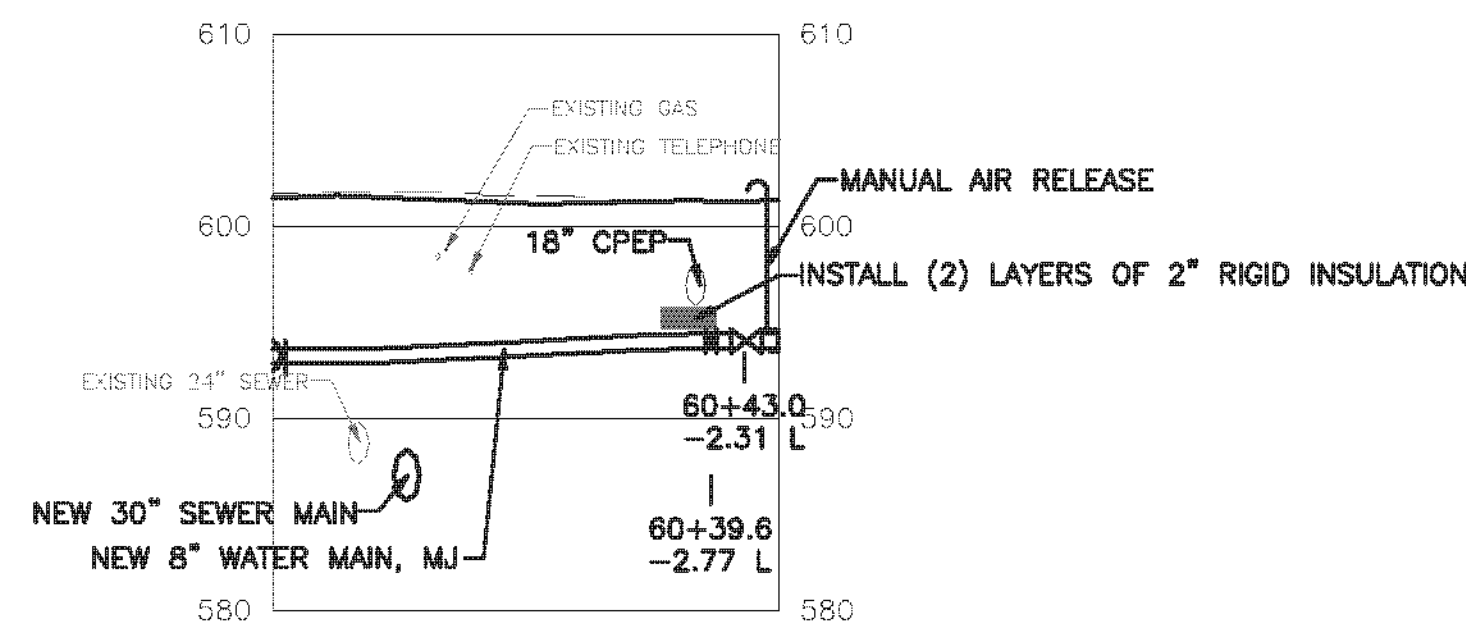


8 IN. WATER MAIN – WEST STREET

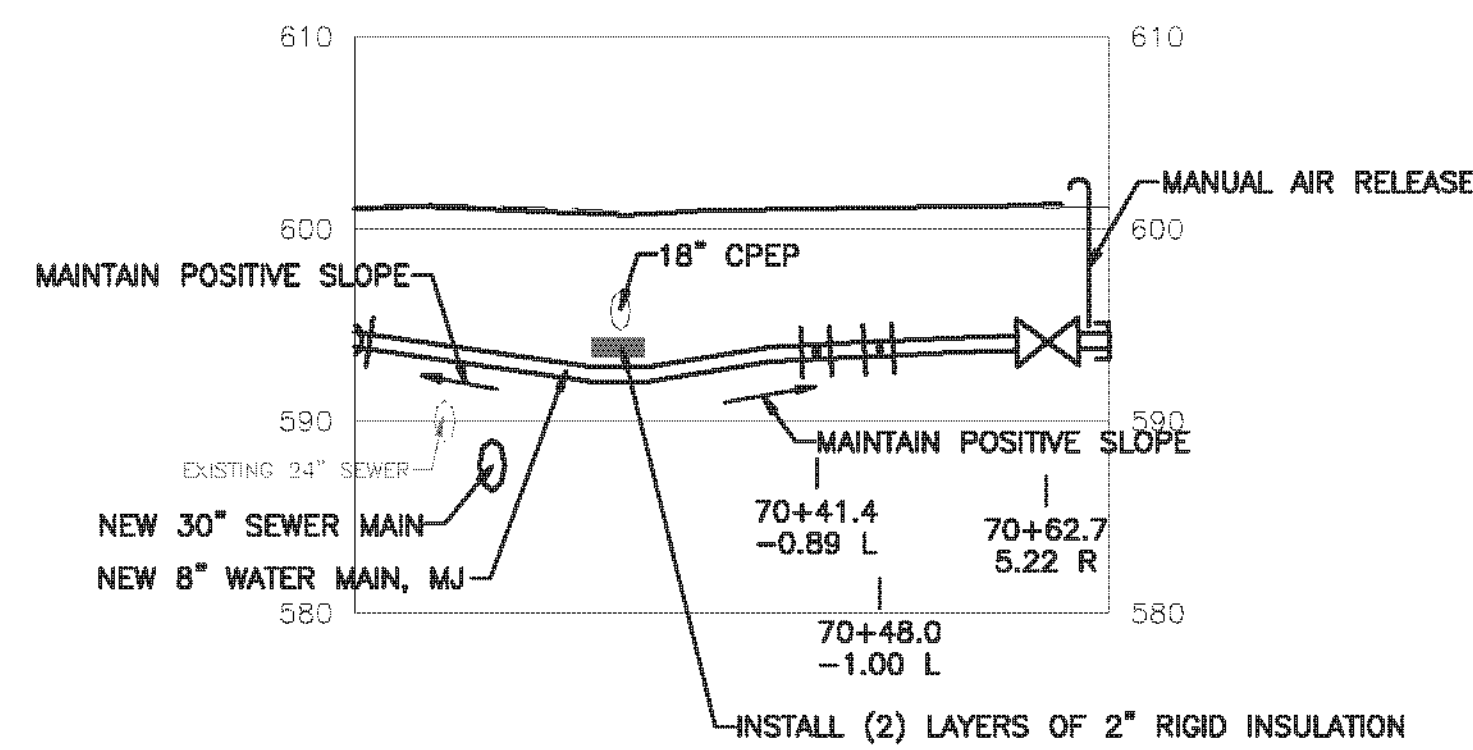


16 IN. WATER MAIN – MERCHANT STREET

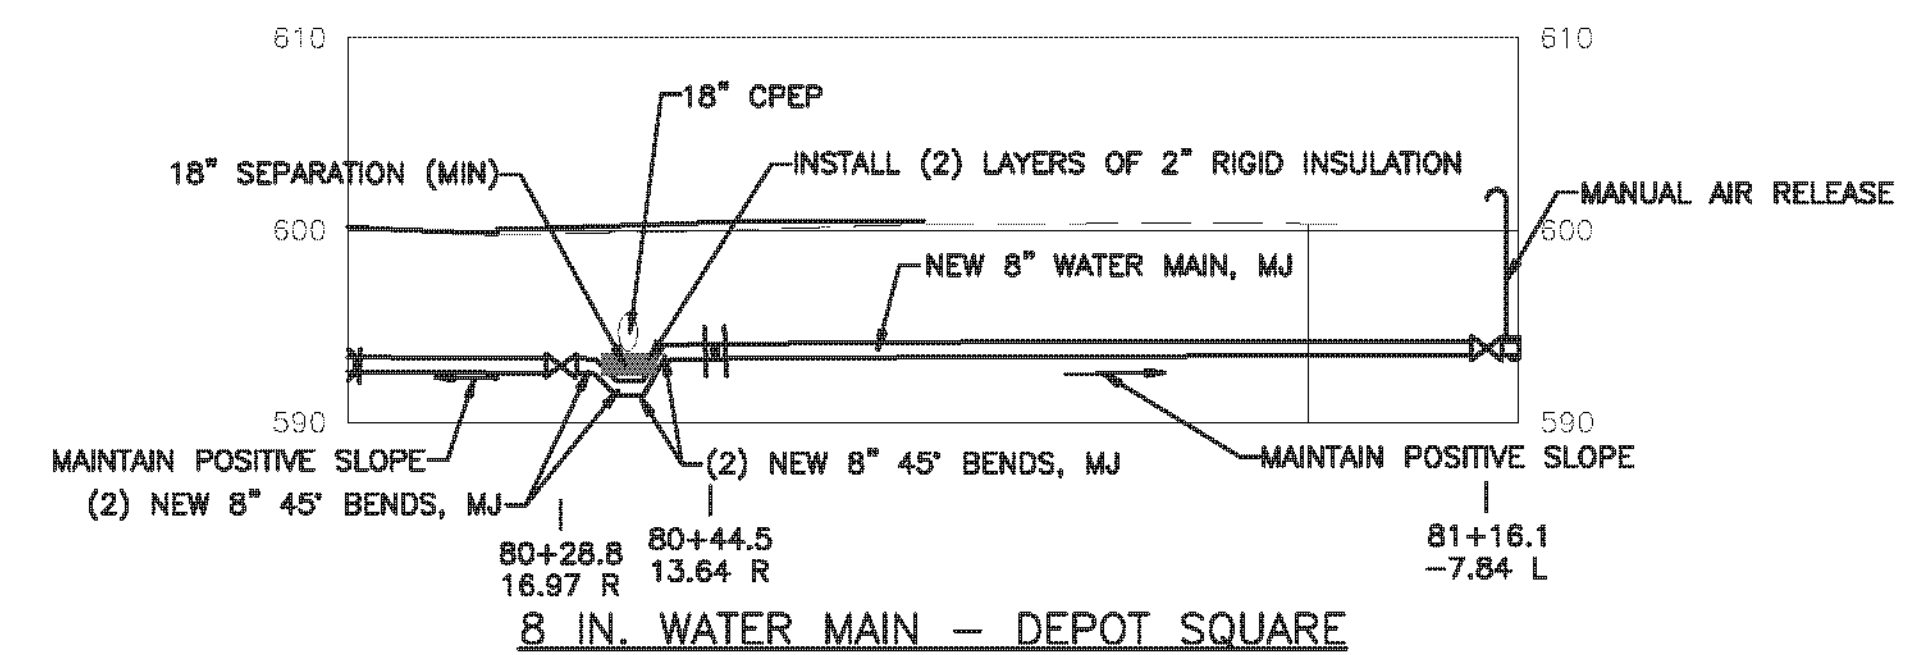


8 IN. WATER MAIN – DEPOT SQUARE

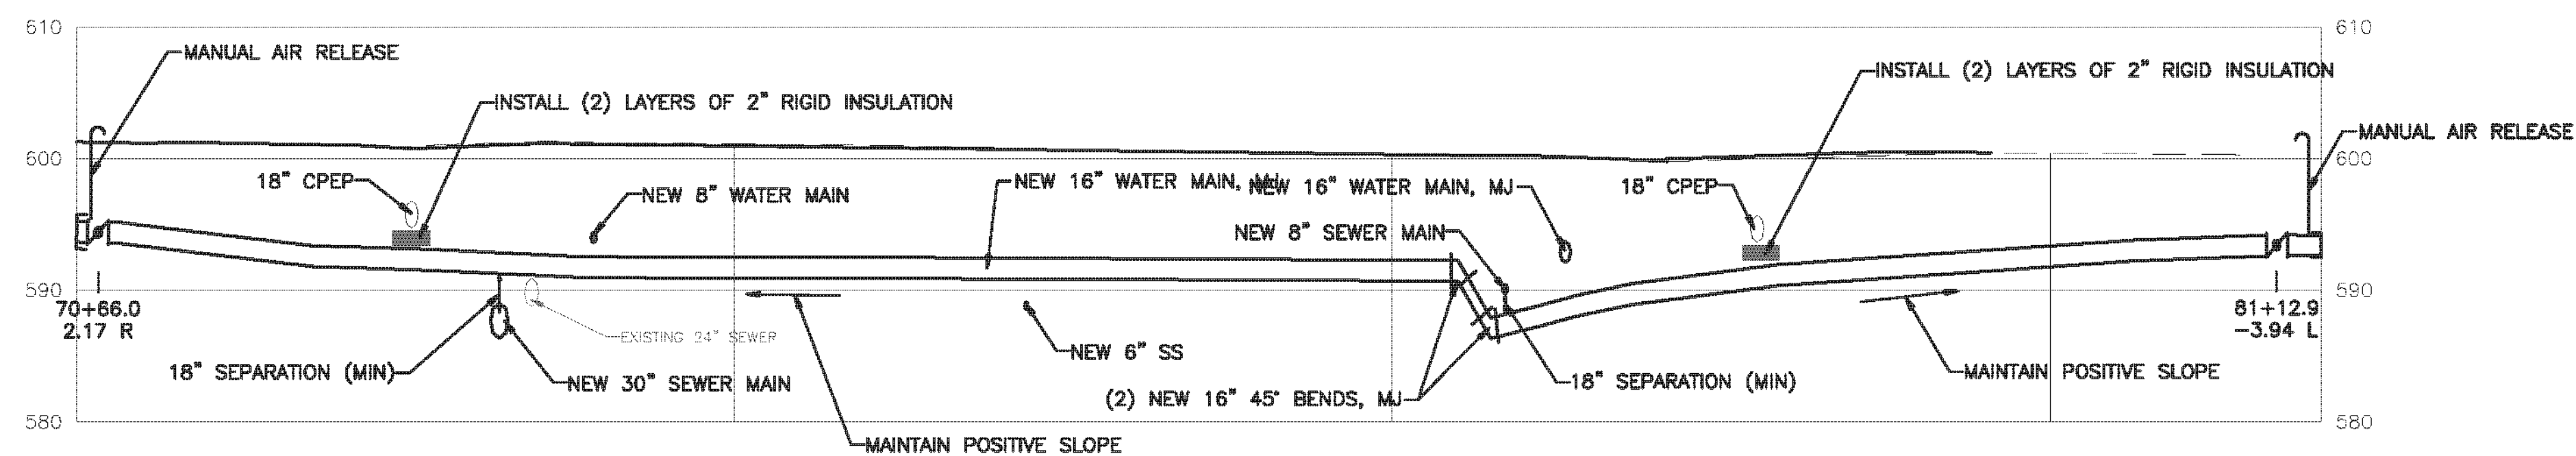

16 IN. HIGH PRESSURE WATER MAIN

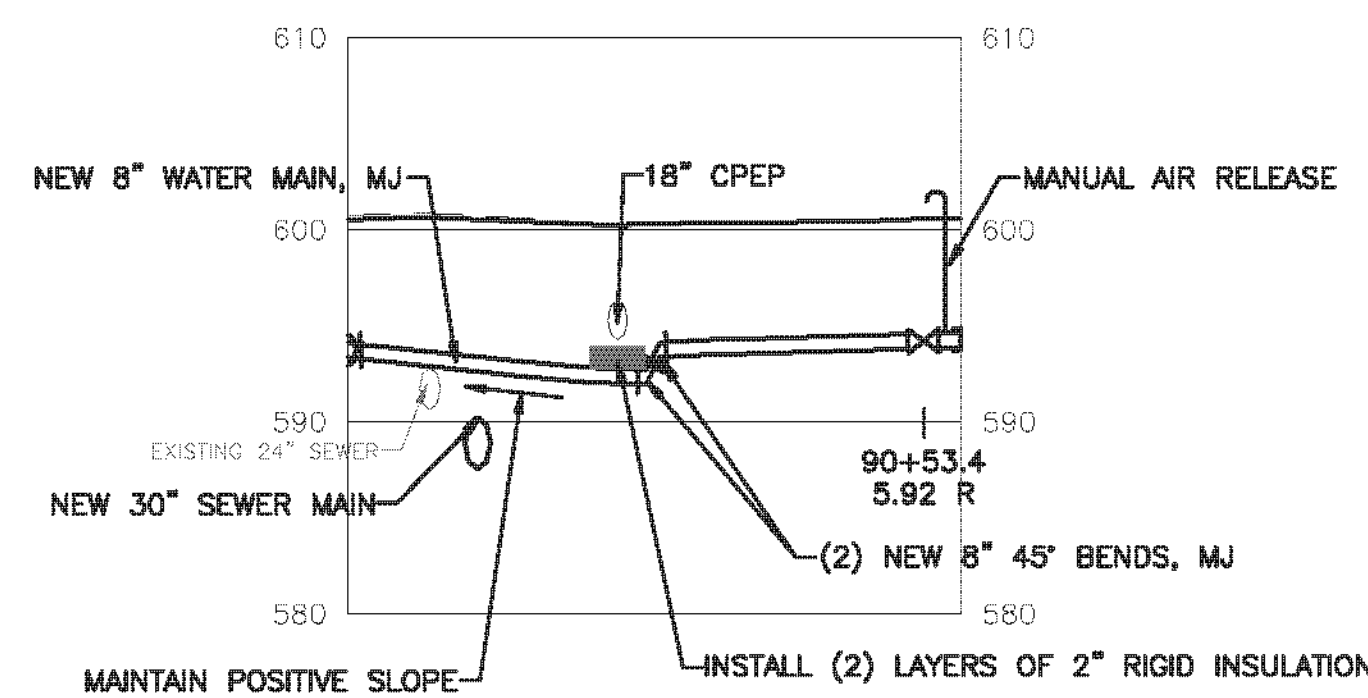



8 IN. WATER MAIN – PEARL STREET

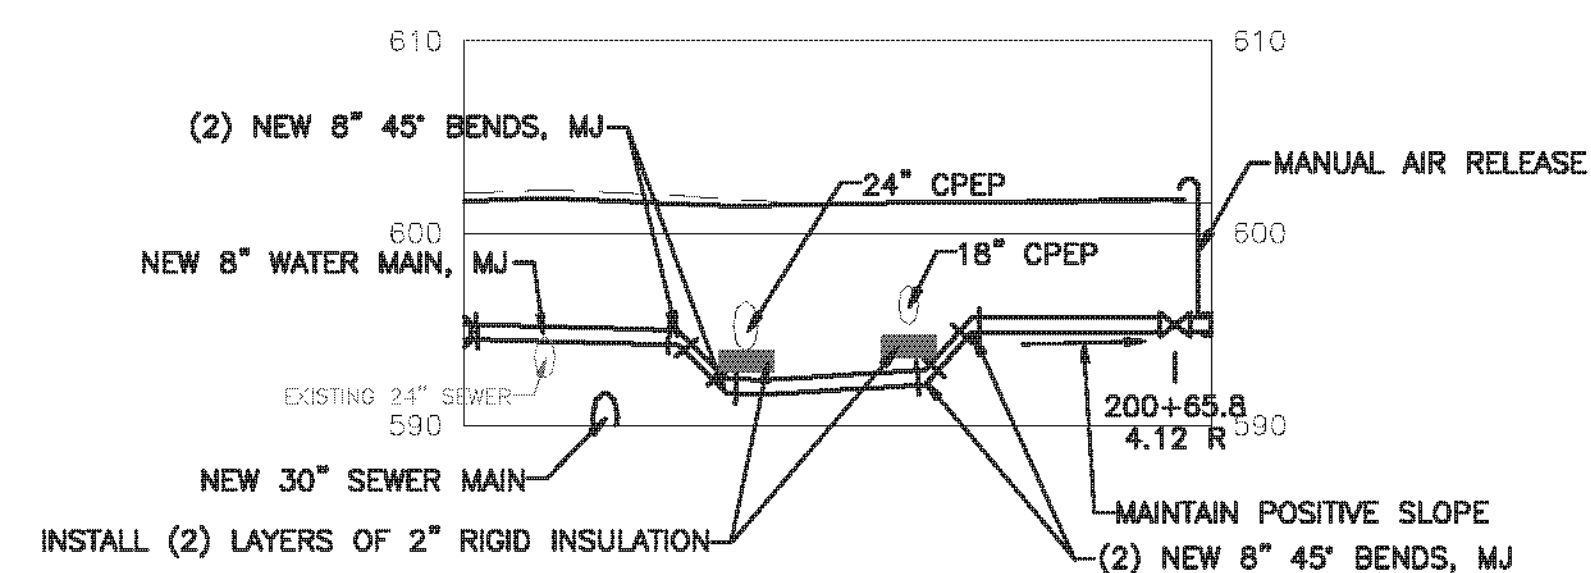

8 IN. WATER MAIN – KEITH AVENUE

NOTES:

1. SEE SHEET 133 FOR GENERAL NOTES, LEGEND, AND ABBREVIATIONS.
2. STATIONING SHOWN HEREON IS BASED ON ROAD CENTERLINE AS PER VIRANS REQUIREMENTS AND MAY NOT REFLECT PROPER PIPE LENGTHS.
3. SEE SHEETS 134–138 FOR PLAN INFORMATION.
4. SEE SHEETS 150 AND 154 FOR DETAILS.

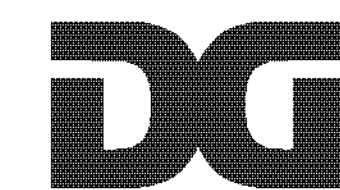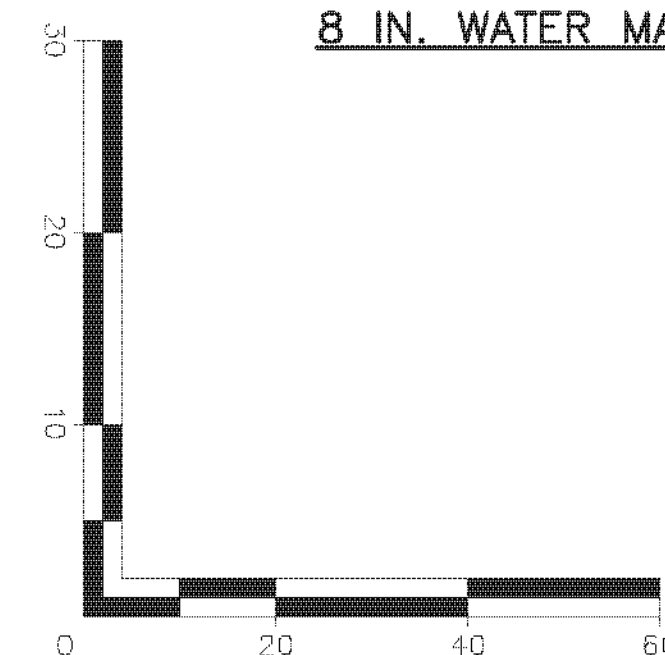

DUFRESNE GROUP
CONSULTING ENGINEERS

Dufresne Group is owned by Dufresne & Associates, PC

PROJECT NAME: BARRE CITY
PROJECT NUMBER: FECC F 026–1(34) C/2

FILE NAME: 717014–PROFILES
PROJECT LEADER: R.E. DUFRESNE
DESIGNED BY: B.L. BAKER
WATER PROFILES

PLOT DATE: Feb. 18, 11
DRAWN BY: B.L. BAKER
CHECKED BY: C.L. WHITFIELD
SHEET 153 OF 339