


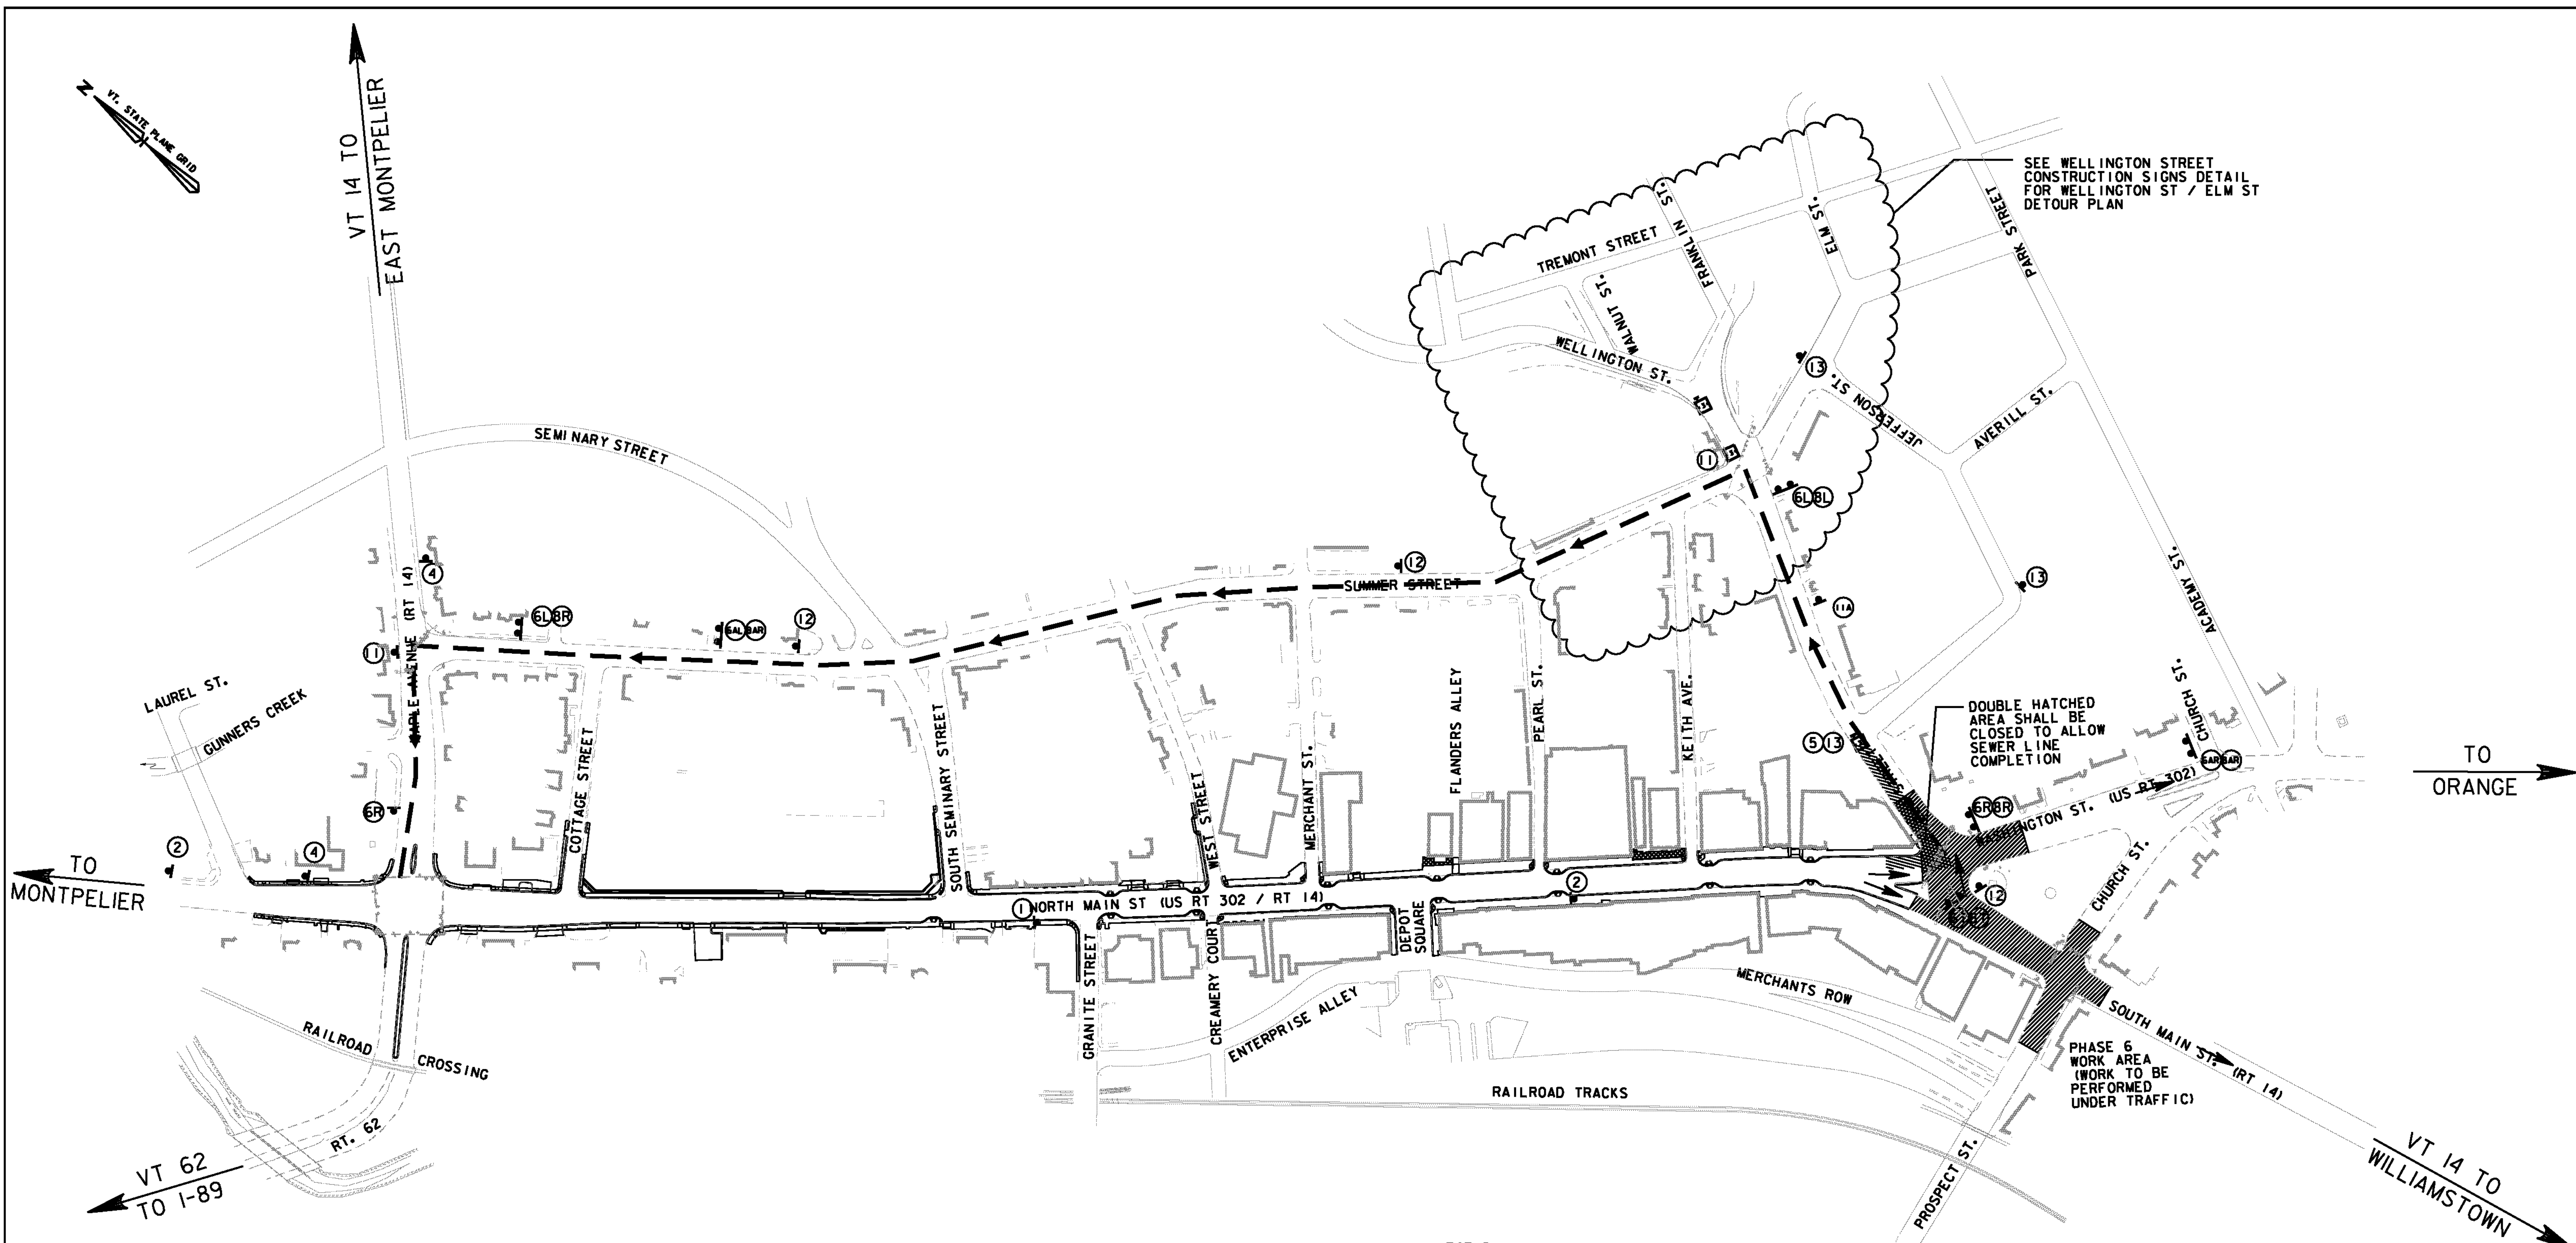

NOTE: ALL SIGNS THAT CONFLICT WITH THE TRAFFIC CONTROL PLANS SHALL BE REMOVED OR FULLY COVERED WITH OPAQUE COVERS (INCLUDES OVERHEAD SIGNS).

1

2

3

4

5

5A

6X

7X

8X

9X

10

10A

10A

11

11A

12

13A

14

X = L

X = R

X = AL

X = AR

X = T

- LEGEND**
- PLASTIC DRUM AND YELLOW TEMPORARY PAVEMENT MARKINGS.
 - PLASTIC DRUM AND WHITE TEMPORARY PAVEMENT MARKINGS.
 - CONSTRUCTION AREA
 - DESIGNATED DETOUR ROUTE
 - CONSTRUCTION SIGN
 - TYPE 1/2/3 BARRICADE
 - BARRICADE WITH SIGNS
 - LOCAL TRAFFIC ACCESS



VHB Vanasse Hangen Brustlin, Inc.

PHASE 6

PROJECT NAME: BARRE CITY

PROJECT NUMBER: FECC F 026-K(34) C/2

FILE NAME: 85b010.DTRI_C2

PROJECT LEADER: G. BAKOS

DESIGNED BY: DMP / MDS

CONST. & DETOUR SIGNING PLAN PHASE 6

PLOT DATE: 3/9/2011

DRAWN BY: DMP / JAR

CHECKED BY:

SHEET 188 OF 339