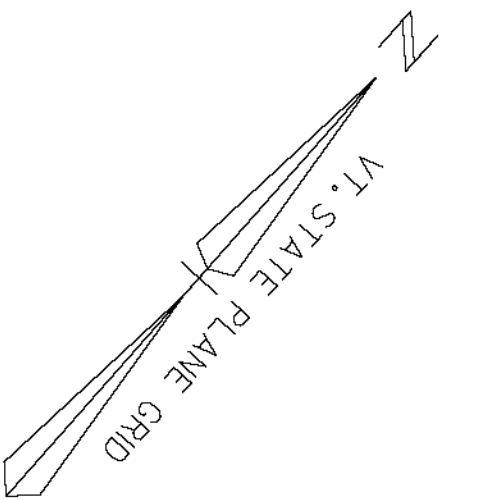


**VHB** *Vanasse Hangen Brustlin, Inc.*