



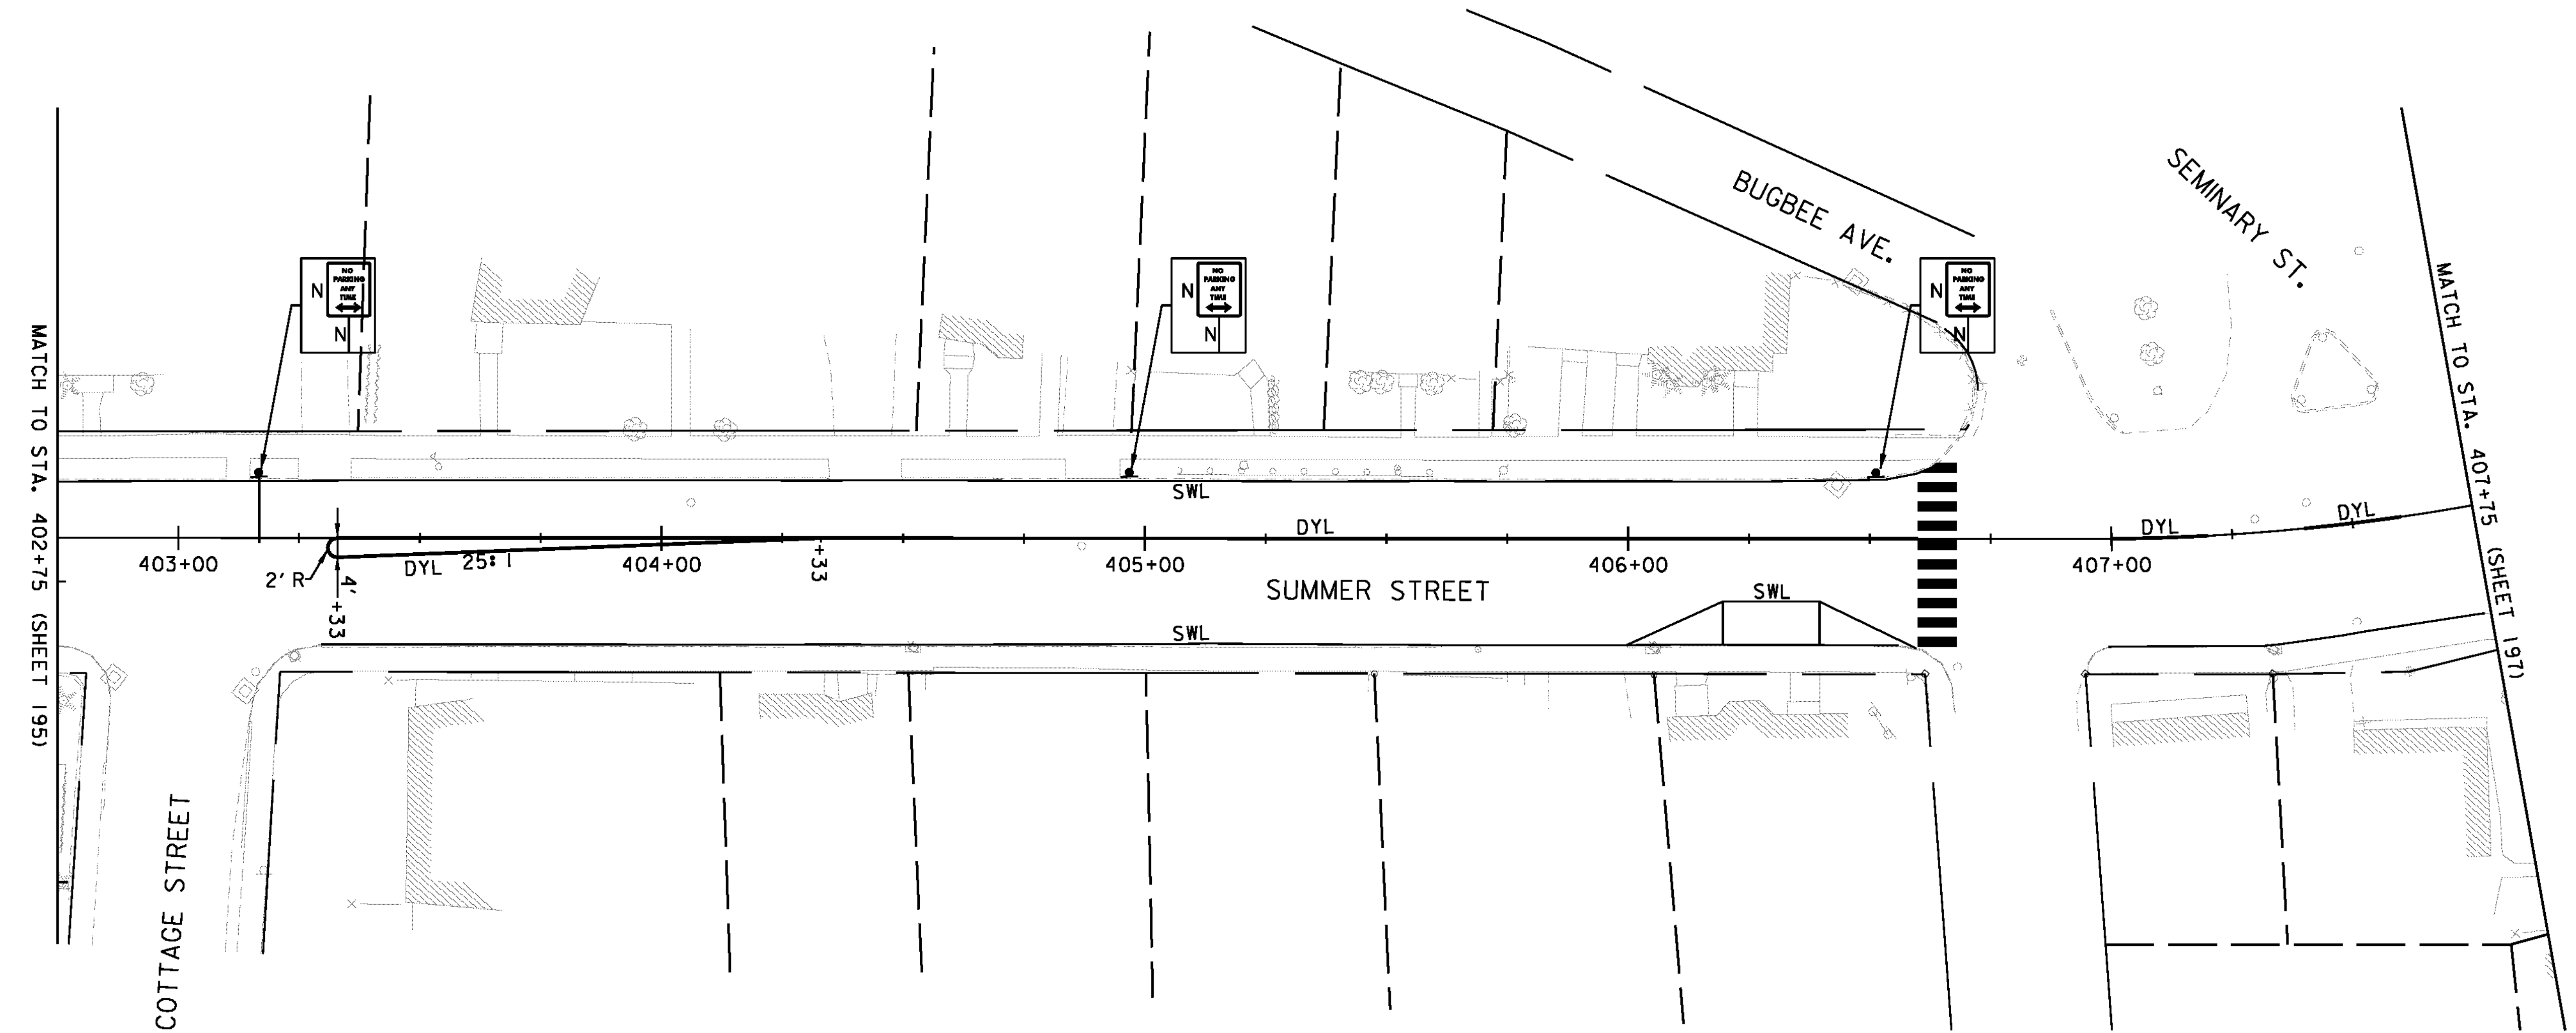

- TEMPORARY 4 INCH YELLOW LINE**
SL STA 403+31 - 406+60 CL (DOUBLE)
SL STA 403+31 - 404+33 RT (DOUBLE)
SL STA 407+00 - 407+20 CL (DOUBLE)
SL STA 407+40 - 407+60 CL (DOUBLE)
- TEMPORARY 4 INCH WHITE LINE**
SL STA 402+75 - 406+64 LT
SL STA 403+30 - 406+56 RT
SL STA 406+00 - 406+60 RT (PARKING)

- | | |
|--------------------------|--------------------------|
| SIGNING LEGEND | STRIPING LEGEND |
| N = NEW | SWL = SINGLE WHITE LINE |
| R = REMOVE | SYL = SINGLE YELLOW LINE |
| R&S = REMOVE AND SALVAGE | DYL = DOUBLE YELLOW LINE |
| RET = RETAIN | SDL = SINGLE DASHED LINE |
| S = SALVAGED SIGN | SBL = SINGLE BROKEN LINE |
| B-B = BACK TO BACK | |

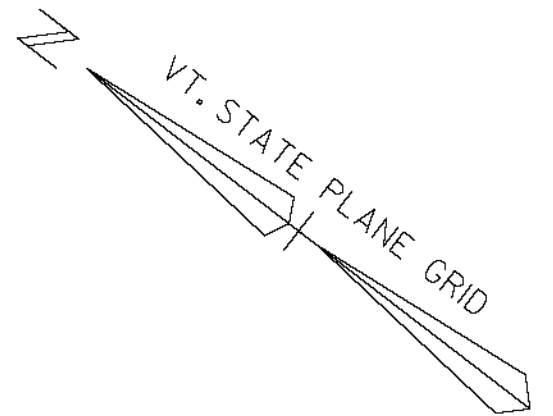

PROJECT NAME: BARRE CITY	
PROJECT NUMBER: FECC F 026-I(34) C/2	
FILE NAME: z85b010bdr tcp	PLOT DATE: 3/9/2011
PROJECT LEADER: G. BAKOS	DRAWN BY: D. PECK
DESIGNED BY: D. PECK	CHECKED BY:
TEMP. SIGNS & PAVEMENT MARKING PLAN #2 SHEET 196 OF 339	