


- CLEARING AND GRUBBING, INCLUDING INDIVIDUAL TREES AND STUMPS
  - SL STA 11+00 - 12+61 RT
  - SL STA 12+83 - 12+91 LT
  - SL STA 12+97 - 15+66 RT
- REMOVAL AND DISPOSAL OF GUARDRAIL
  - SL STA 13+04 - 13+80 RT
- MANUFACTURED TERMINAL SECTION, FLARED
  - SL STA 13+31 - 13+80 RT
- REMOVAL OF EXISTING FENCE
  - SL STA 13+24 - 15+21 RT
- CHAIN-LINK FENCE, 8 FT (POLY-COATED BLACK)
  - SL STA 12+95 - 15+80 RT
- GATE FOR CHAIN-LINK FENCE, 8 FEET (POLY-COATED BLACK)
  - SL STA 13+28 RT
- COLD PLANING, BITUMINOUS PAVEMENT
  - SL STA 11+75 - 12+66
- STONE FILL, TYPE III
  - SL STA 14+57 RT
  - SL STA 15+28 RT
  - SL STA 15+59 RT
- GEOTEXTILE FOR FILTER CURTAIN
  - SL STA 15+07 - 15+50 RT
- PERMANENT EROSION MATTING
  - SL STA 14+32 - 15+45 RT (POND/ON SLOPES)

NOTE:  
 1. SEE THE ITEM DETAIL & DRAINAGE SHEETS AND CROSS SECTIONS FOR PROPOSED DRAINAGE INFORMATION CORRESPONDING TO NOTE NUMBERS SHOWN BY: #

- |  |   |
|--|---|
| <ul style="list-style-type: none"> <li>PROPOSED GRANITE BOLLARD AND CHAIN FENCE</li> <li>PROPOSED ORNAMENTAL STREET LIGHT</li> <li>PROPOSED STREET LIGHT WITH LUMINAIRE BY GMP</li> <li>PROPOSED SIGNAL POLE WITH LUMINAIRE</li> </ul> | <ul style="list-style-type: none"> <li>PROPOSED TRASH RECEPTACLE</li> <li>PROPOSED PARKING METER</li> <li>PROPOSED TREE LOCATION</li> <li>4' x 5' PROPOSED TREE PIT</li> <li>PROPOSED FIRE HYDRANT</li> </ul> |
|--|---|

FOR LANDSCAPING DETAILS  
 SEE SHEET 39 OF 100

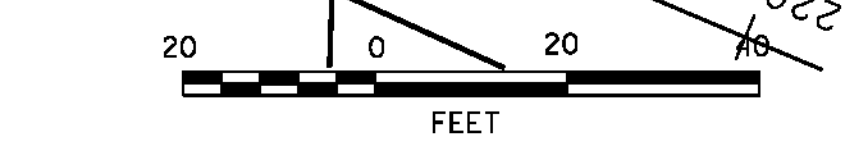

**FOR R.O.W. USE ONLY**

ROW LAYOUT 2

PROJECT NAME: BARRE CITY - NORTH MAIN ST.  
 PROJECT NUMBER: F EGC-F 026-I(34) - CONTRACT 2

FILE NAME: z85b010bdr cp  
 PROJECT LEADER: G. BAKOS  
 DESIGNED BY: D. PECK  
 ROW SHEET 87 OF 100

PLOT DATE: 04-MAR-2011  
 DRAWN BY: D. PECK  
 CHECKED BY:  
 SHEET 215 OF 339

