
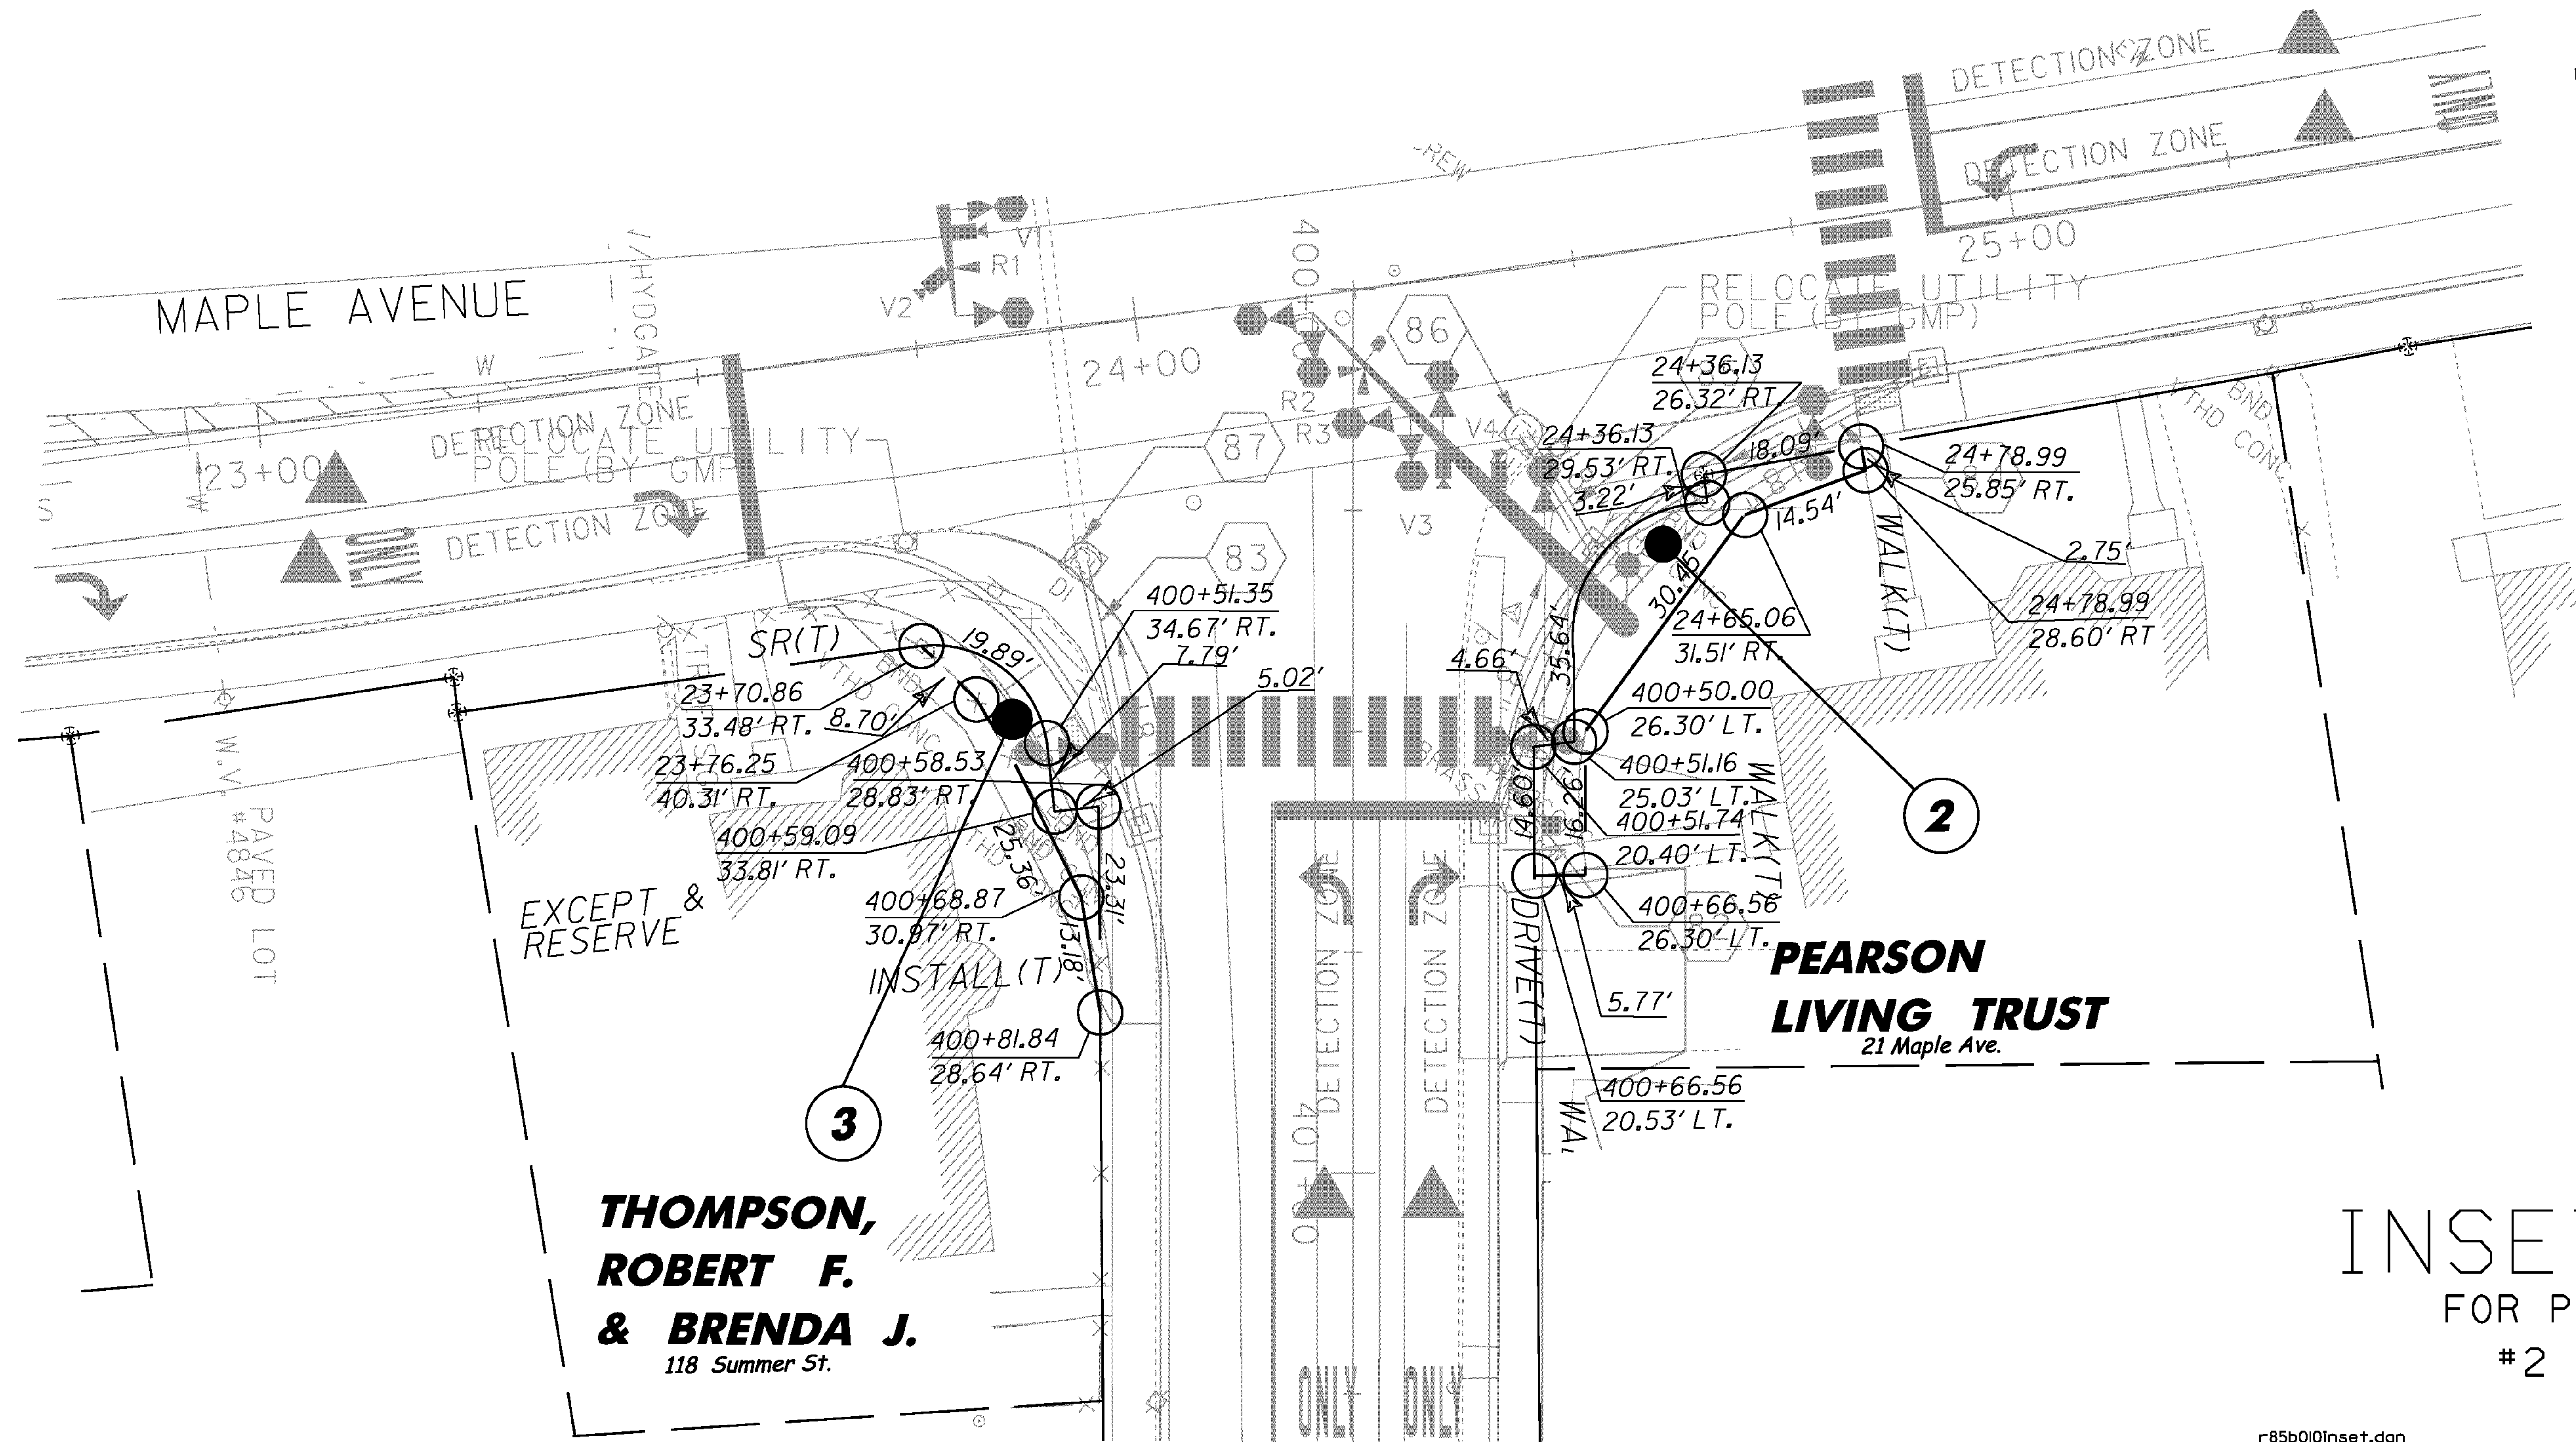


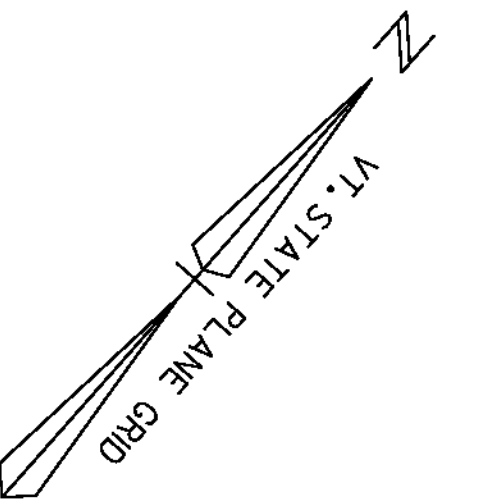

INSET "A"
FOR PARCELS
#2 & #3

**FOR R.O.W.
USE ONLY**

r85b010Inset.dgn	
PROJECT NAME: BARRE CITY - NORTH MAIN ST.	
PROJECT NUMBER: F EGC-F 026-I(34) - CONTRACT 2	
FILE NAME: z85b010bdr cp	PLOT DATE: 04-MAR-2011
PROJECT LEADER: G. BAKOS	DRAWN BY: D. PECK
DESIGNED BY: D. PECK	CHECKED BY:
ROW SHEET 89 OF 100	SHEET 217 OF 339