



COLD PLANING, BITUMINOUS PAVEMENT
STA 136+64 - 136+78 LT
STA 139+60 - 140+25
ST STA 600+48 - 603+75
SL STA 500+25 - 501+60
SL STA 700+53 - 701+50
SL STA 800+19 - 800+65

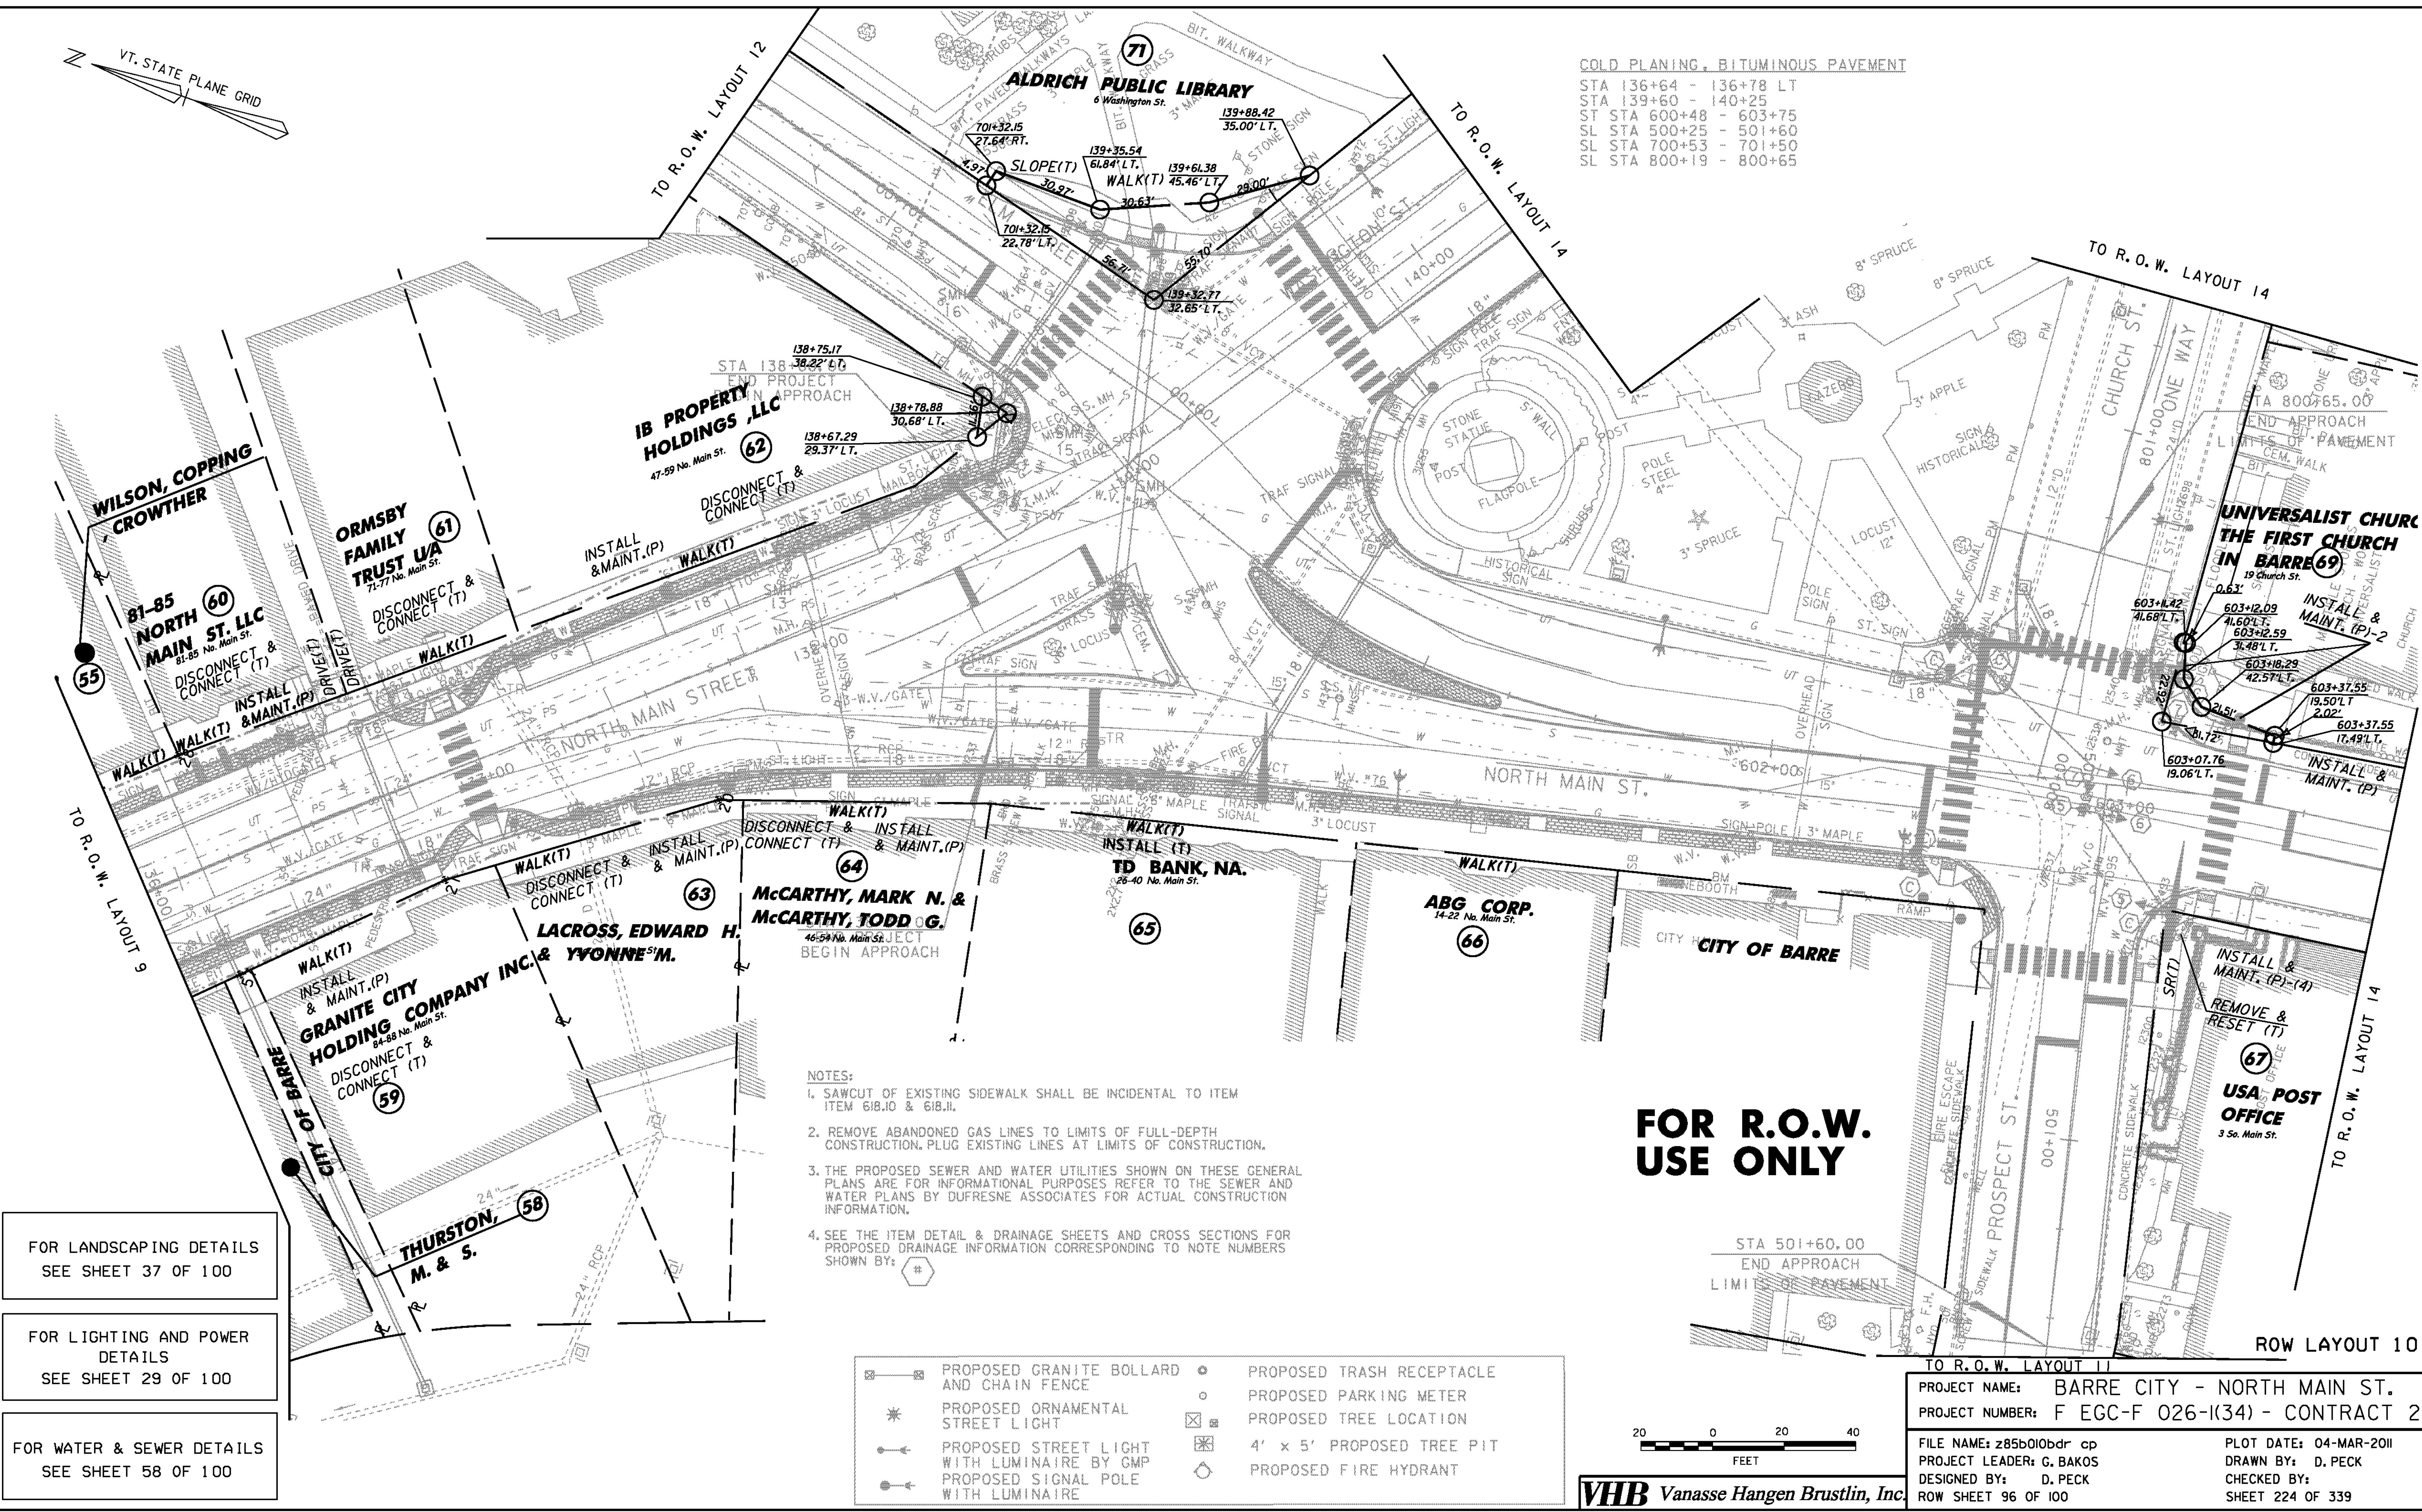

- NOTES:
- 1. SAWCUT OF EXISTING SIDEWALK SHALL BE INCIDENTAL TO ITEM 618.10 & 618.11.
 - 2. REMOVE ABANDONED GAS LINES TO LIMITS OF FULL-DEPTH CONSTRUCTION. PLUG EXISTING LINES AT LIMITS OF CONSTRUCTION.
 - 3. THE PROPOSED SEWER AND WATER UTILITIES SHOWN ON THESE GENERAL PLANS ARE FOR INFORMATIONAL PURPOSES. REFER TO THE SEWER AND WATER PLANS BY DUFRESNE ASSOCIATES FOR ACTUAL CONSTRUCTION INFORMATION.
 - 4. SEE THE ITEM DETAIL & DRAINAGE SHEETS AND CROSS SECTIONS FOR PROPOSED DRAINAGE INFORMATION CORRESPONDING TO NOTE NUMBERS SHOWN BY: #

PROPOSED GRANITE BOLLARD AND CHAIN FENCE	PROPOSED TRASH RECEPTACLE
PROPOSED ORNAMENTAL STREET LIGHT	PROPOSED PARKING METER
PROPOSED STREET LIGHT WITH LUMINAIRE BY GMP	PROPOSED TREE LOCATION
PROPOSED SIGNAL POLE WITH LUMINAIRE	4' x 5' PROPOSED TREE PIT
	PROPOSED FIRE HYDRANT

FOR R.O.W. USE ONLY

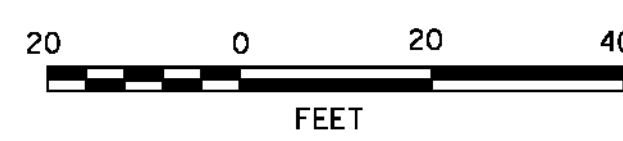

FOR LANDSCAPING DETAILS
SEE SHEET 37 OF 100

FOR LIGHTING AND POWER DETAILS
SEE SHEET 29 OF 100

FOR WATER & SEWER DETAILS
SEE SHEET 58 OF 100

TO R.O.W. LAYOUT 11

PROJECT NAME: BARRE CITY - NORTH MAIN ST.
PROJECT NUMBER: F EGC-F 026-I(34) - CONTRACT 2

FILE NAME: z85b010bdr cp
PROJECT LEADER: G. BAKOS
DESIGNED BY: D. PECK
ROW SHEET 96 OF 100

PLOT DATE: 04-MAR-2011
DRAWN BY: D. PECK
CHECKED BY:
SHEET 224 OF 339

VHB Vanasse Hangen Brustlin, Inc.