


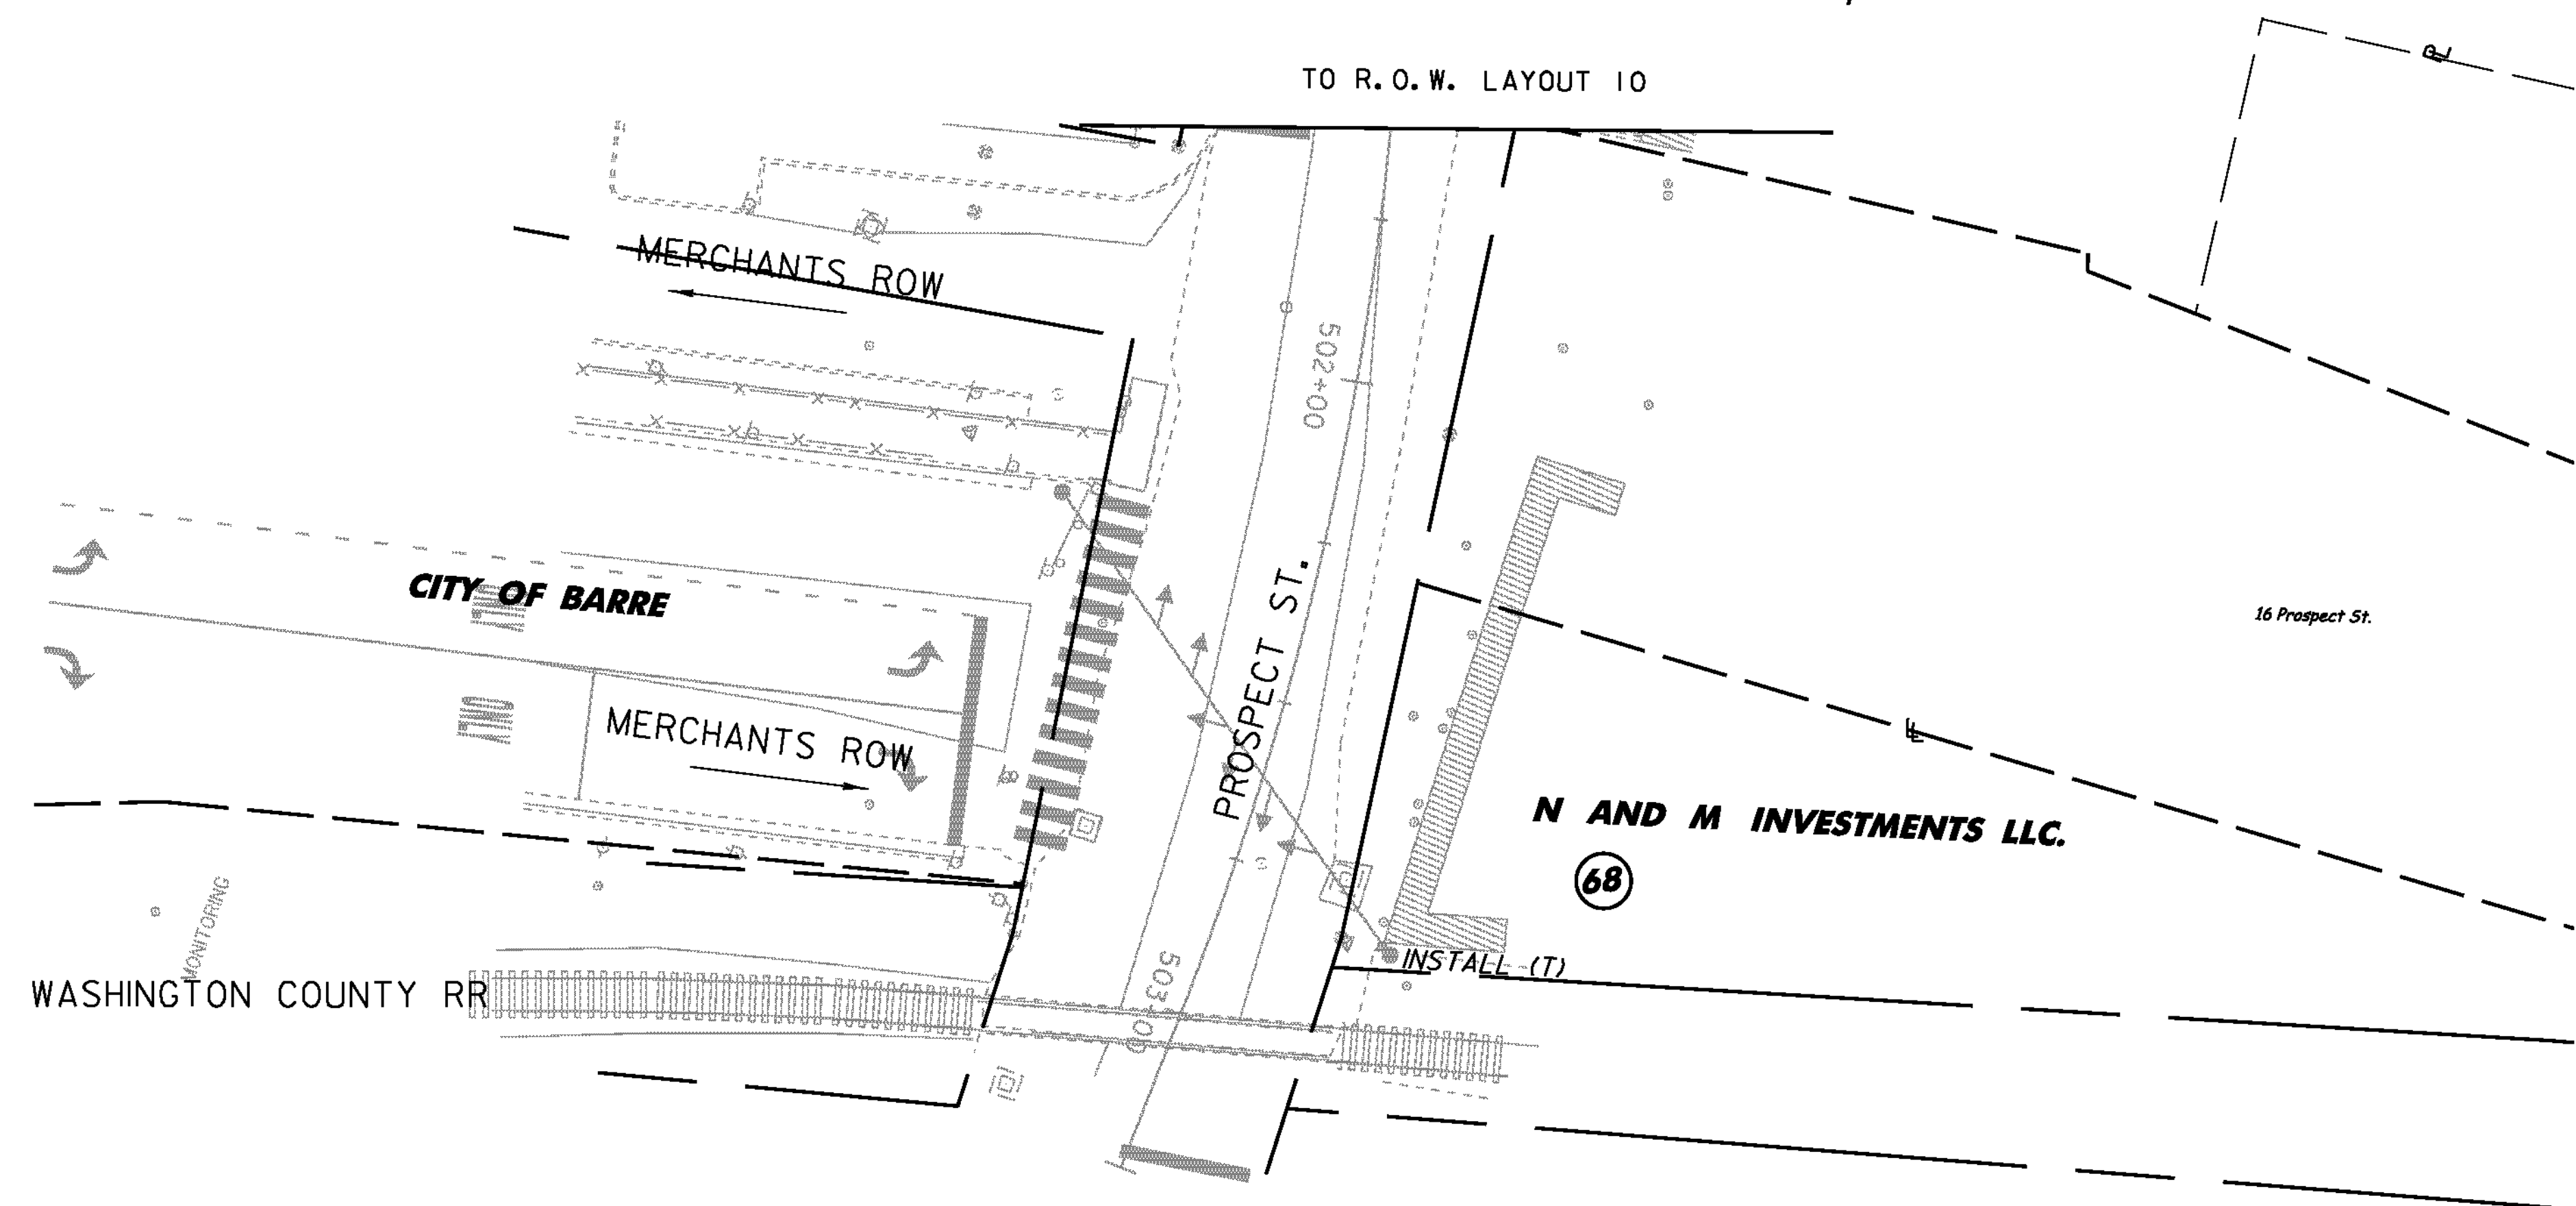

**FOR R.O.W.
USE ONLY**

ROW LAYOUT 11

PROJECT NAME: BARRE CITY - NORTH MAIN ST.
PROJECT NUMBER: F EGC-F 026-I(34) - CONTRACT 2

FILE NAME: z85b010bdr nu
PROJECT LEADER: G. BAKOS
DESIGNED BY: D. PECK
ROW SHEET 97 OF 100

PLOT DATE: 04-MAR-2011
DRAWN BY: D. PECK
CHECKED BY:
SHEET 225 OF 339