



110+77 EXCAVATION ~ 46.5' • 1.15' = 53 SF

$$\frac{4.25}{100} = \frac{X}{27'} = 1.15'$$

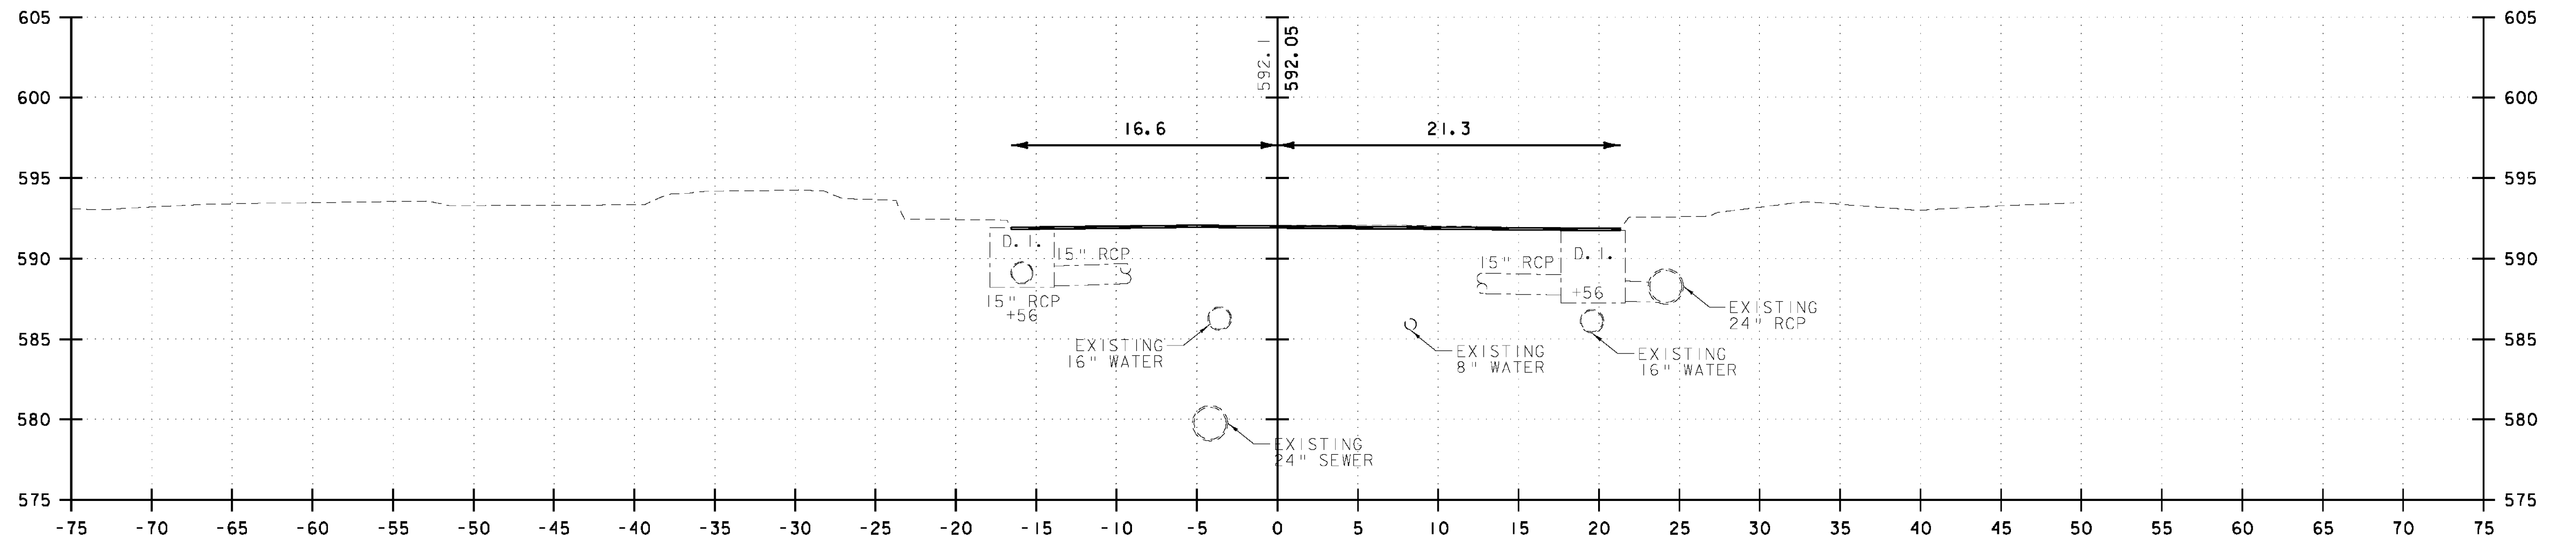

110+65.50 EXCAVATION = 0

BEGIN APPROACH STA. 110+65.25

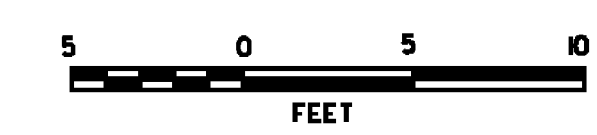

VHB Vanasse Hangen Brustlin, Inc.

NORTH MAIN STREET (US 302)	
PROJECT NAME:	BARRE CITY
PROJECT NUMBER:	FEGC F 026-1(34) C/2
FILE NAME:	85b010_xsl.Cut_C2
PROJECT LEADER:	G. BAKOS
DESIGNED BY:	DMP / MDS
CROSS SECTIONS	
PLOT DATE:	3/9/2011
DRAWN BY:	DMP / JAR
CHECKED BY:	
SHEET	229 OF 339