



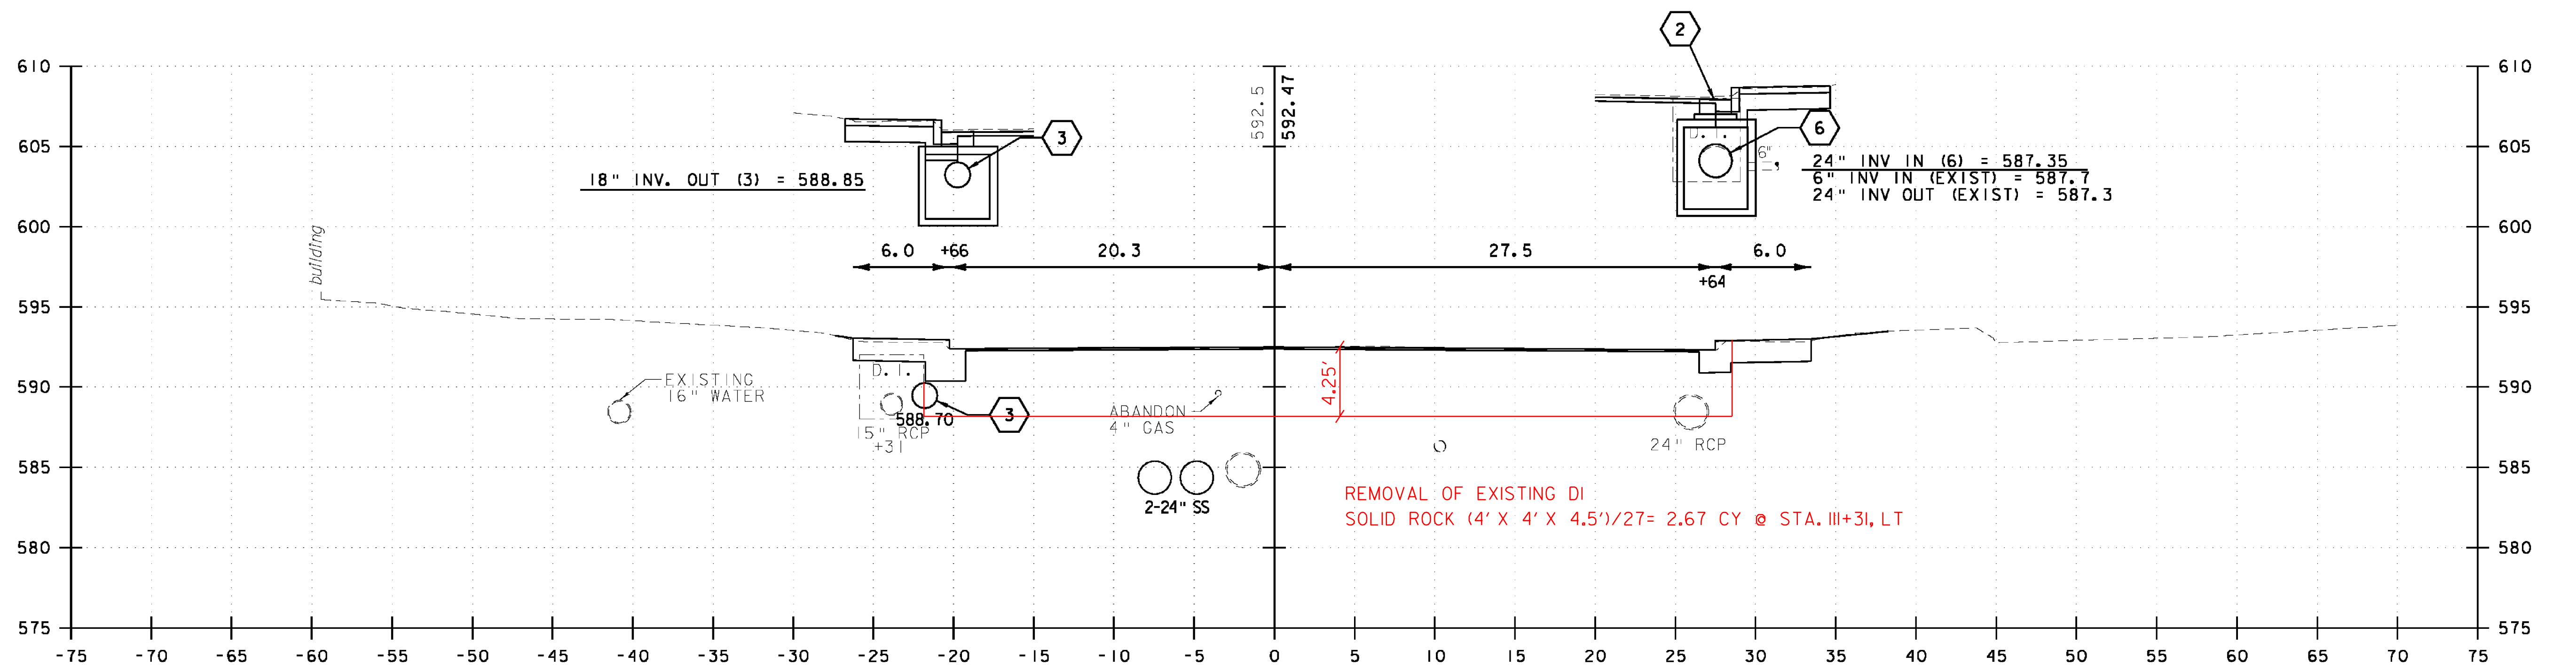

111+50

EXCAVATION ~ (4.25' X 50.5') + (2 X 5' X 1.42')= 229 SF
DENSE GRADED ~ 2.00' X 50.5'= 101 SF
SAND BORROW ~ 1.50' X 50.5'= 76 SF

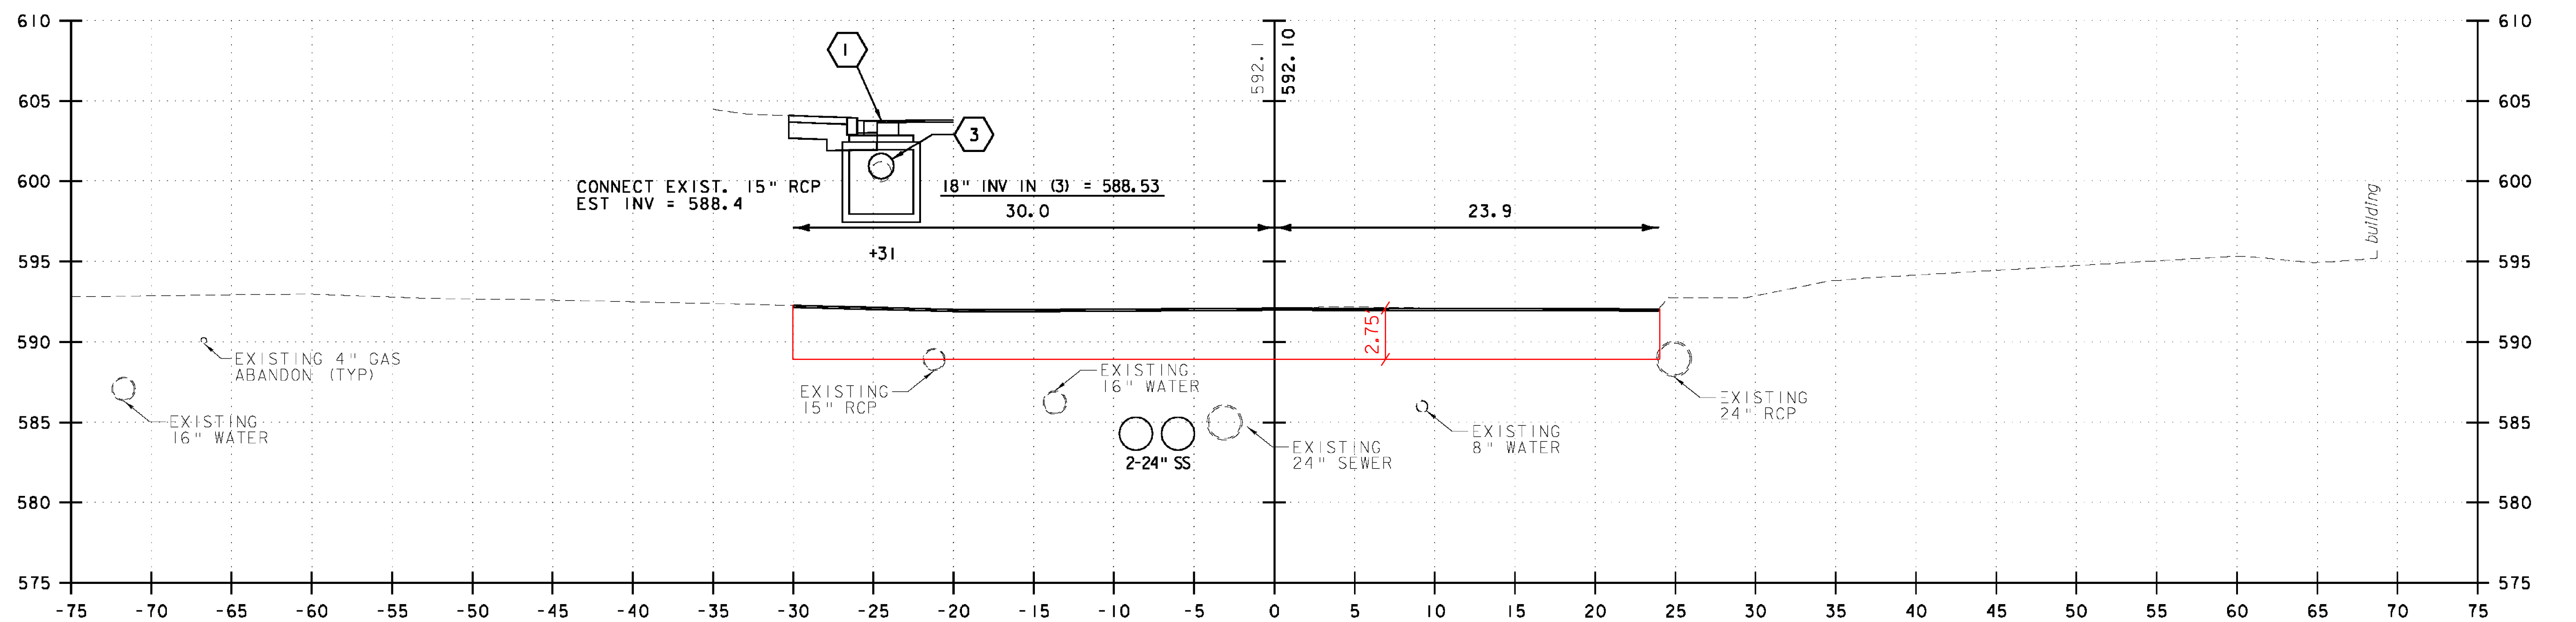

111+00.07

EXCAVATION ~ 2.75' X 54'= 148 SF
DENSE GRADED ~ 2.00' X 54'= 108 SF
SAND BORROW = 0



VHB Vanasse Hangen Brustlin, Inc.

NORTH MAIN STREET (US 302)

PROJECT NAME: BARRE CITY
PROJECT NUMBER: FECC F 026-1(34) C/2

FILE NAME: 85b010.xml.Cut_C2
PROJECT LEADER: G. BAKOS
DESIGNED BY: DMP / MDS
CROSS SECTIONS

PLOT DATE: 3/9/2011
DRAWN BY: DMP / JAR
CHECKED BY:
SHEET 230 OF 339