



112+50
 EXCAVATION ~ (4.25' X 59') + (2.5' X 1.42')= 265 SF
 DENSE GRADED ~ 2.00' X 59'= 118 SF
 SAND BORROW ~ 1.50' X 59'= 88.5 SF

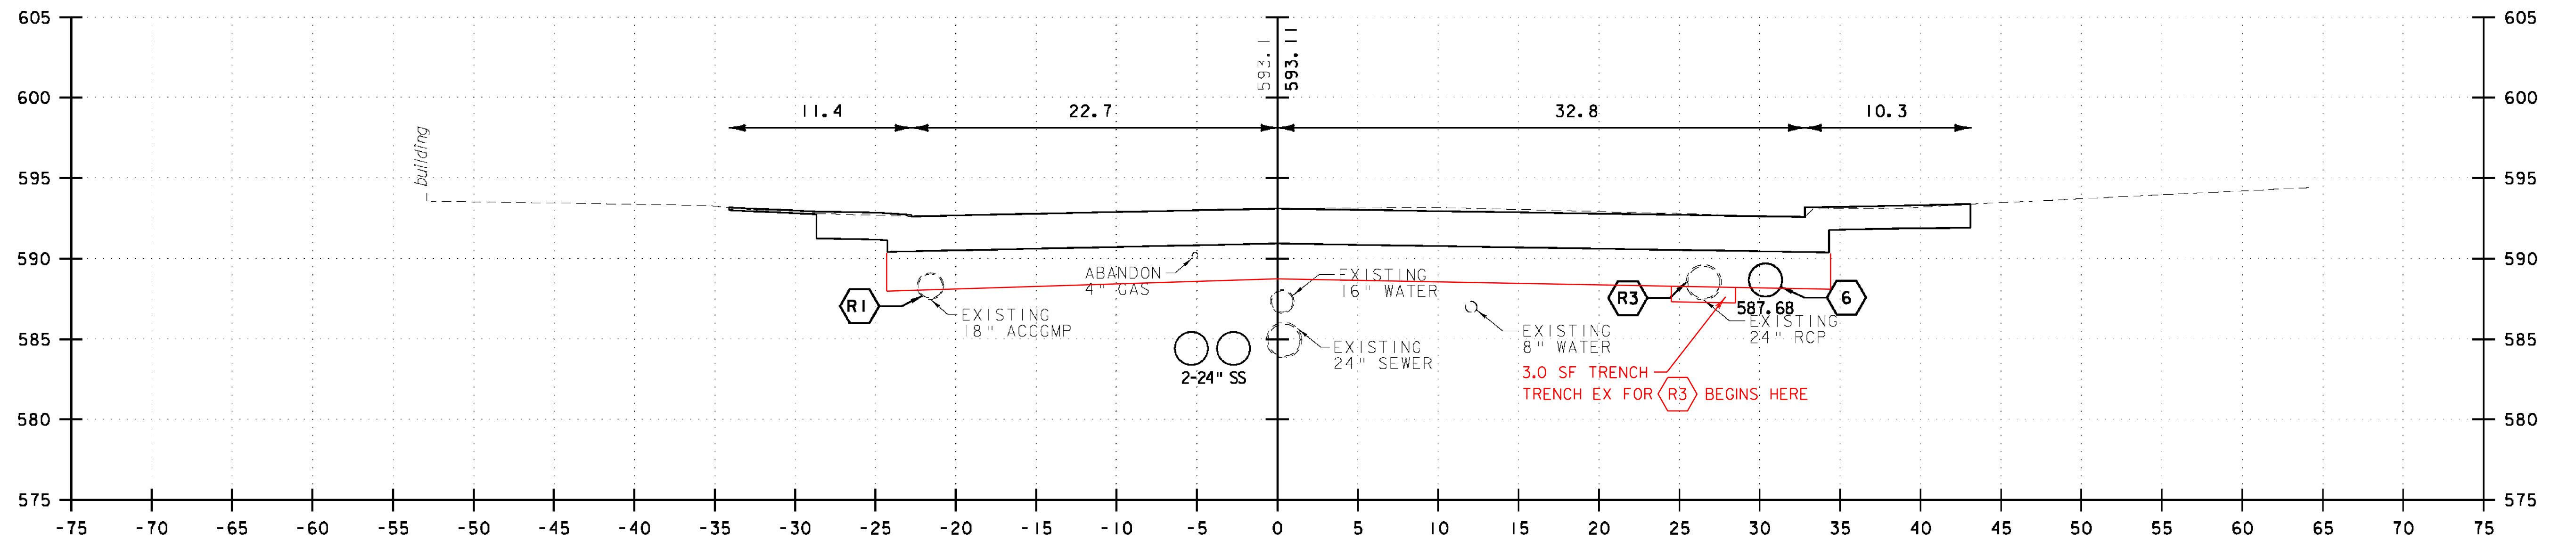

112+40

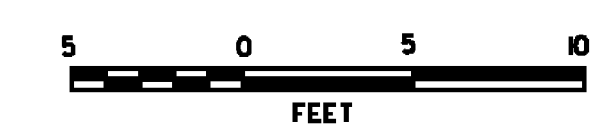

VHB Vanasse Hangen Brustlin, Inc.

NORTH MAIN STREET (US 302)	
PROJECT NAME:	BARRE CITY
PROJECT NUMBER:	FEGC F 026-(134) C/2
FILE NAME:	85b010_xsl.Cu+1.C2
PROJECT LEADER:	G. BAKOS
DESIGNED BY:	DMP / MDS
CROSS SECTIONS	
PLOT DATE:	3/9/2011
DRAWN BY:	DMP / JAR
CHECKED BY:	
SHEET	232 OF 339